

See to Bel:

THU 16 JUN 89

THU 13 JUN 89

S.S. No. 17.

Parkmore
Belfast Report
No 3833


Section and Elevation of Ballast tank

Solid floor plates on ~~every~~ frames.


~~Bracket at Centre of large plate on interm. side frames.~~

Centre plate Continuous; Girders intercostal.

Scale $\frac{1}{2}$ " = one foot.

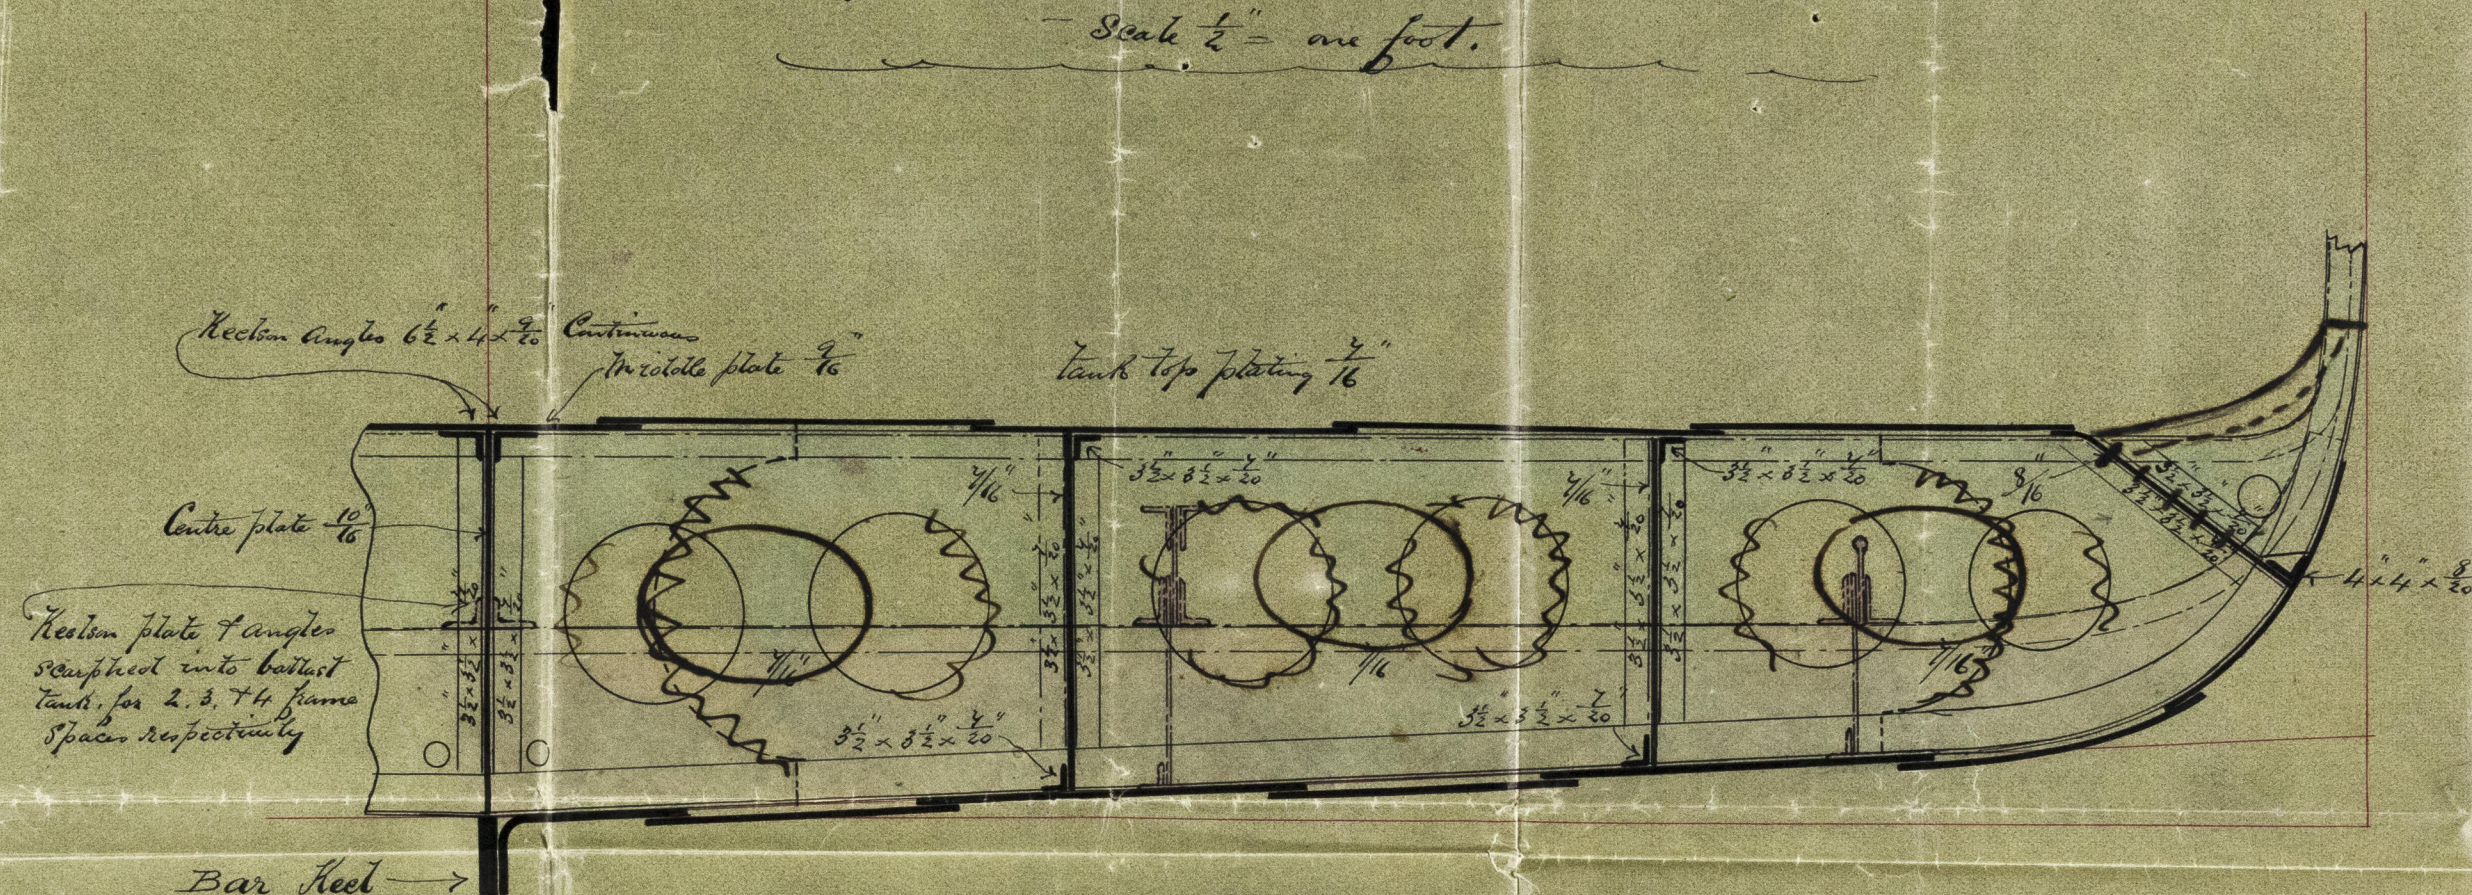

Section in way of Ballast tank.

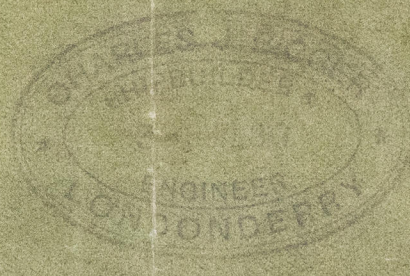

Scale $\frac{1}{4}$ " = one foot.

Elevation



© 2019
Lloyd's Register
Foundation

BEL98-034