




CHARLES J. BIGGER  
SHIPBUILDER &  
9-DEC-89  
ENGINEER  
LONDONDERRY

Parkmore  
Belfast Report  
No 3833

CHARLES J. BIGGER  
RECEIVED  
24 DEC 89  
LONDONDERRY

LOYDE REGISTERED  
BELFAST  
STREETING

© 2021  
D.M.  
Lloyd's Register  
Foundation  
BCE58-035

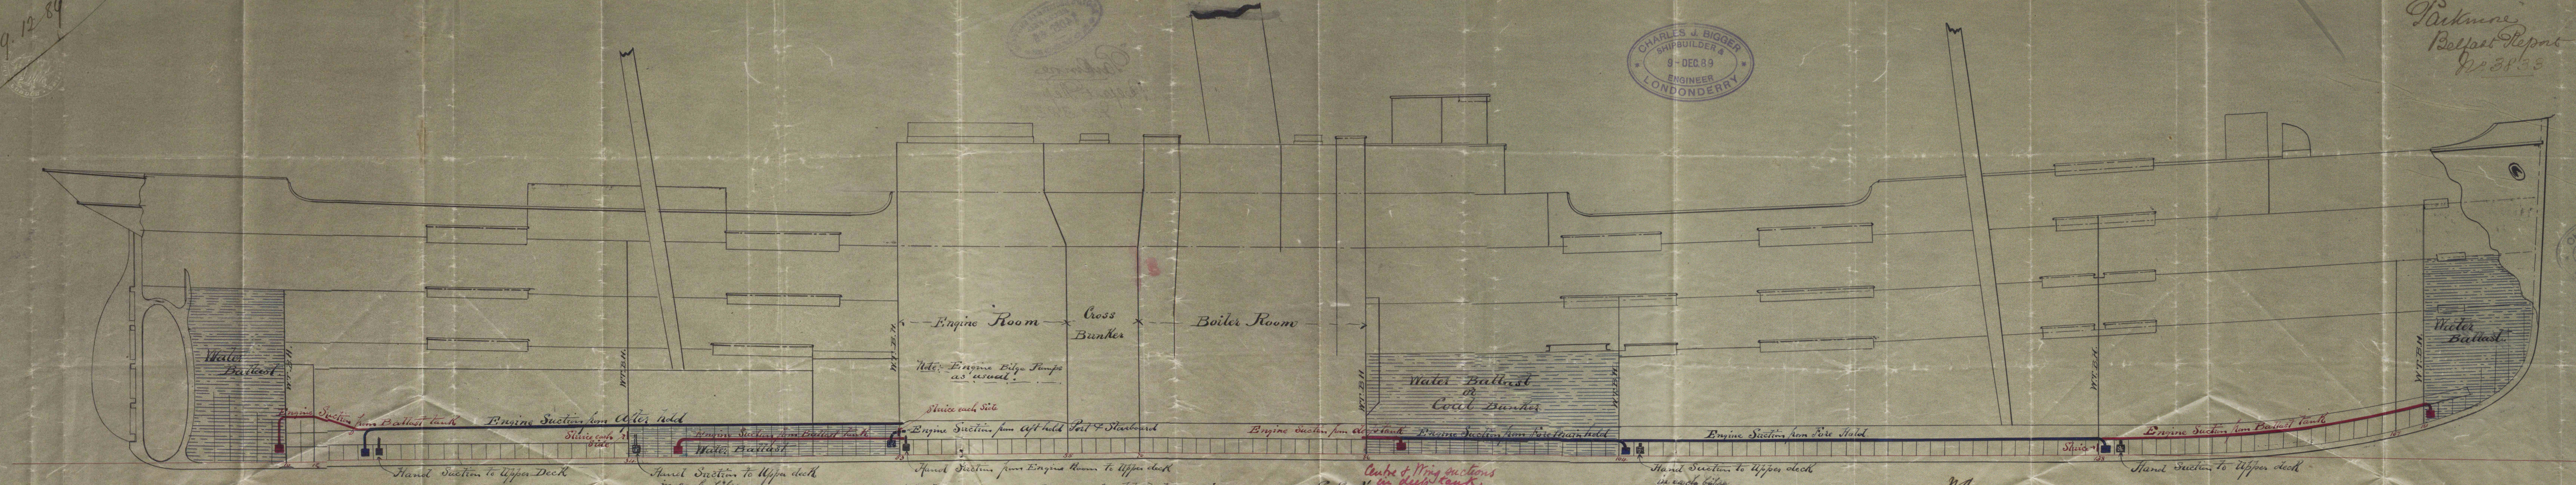


Elevation Plan of Mold Piping in S.S.  
Scale  $\frac{1}{8}$ " = one foot.

Centre & Wing sections  
"in deep tank"  
"Sedgemore"  
"Parkmore"

W.A.  
17-12-89



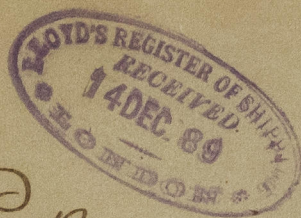

Parkmore  
Belfast Report  
No 3833

5300-85138

Boiler Room

Cross  
Bunker

Room

Boiler Room

Boiler Room



© 2021

Lloyd's Register  
Foundation