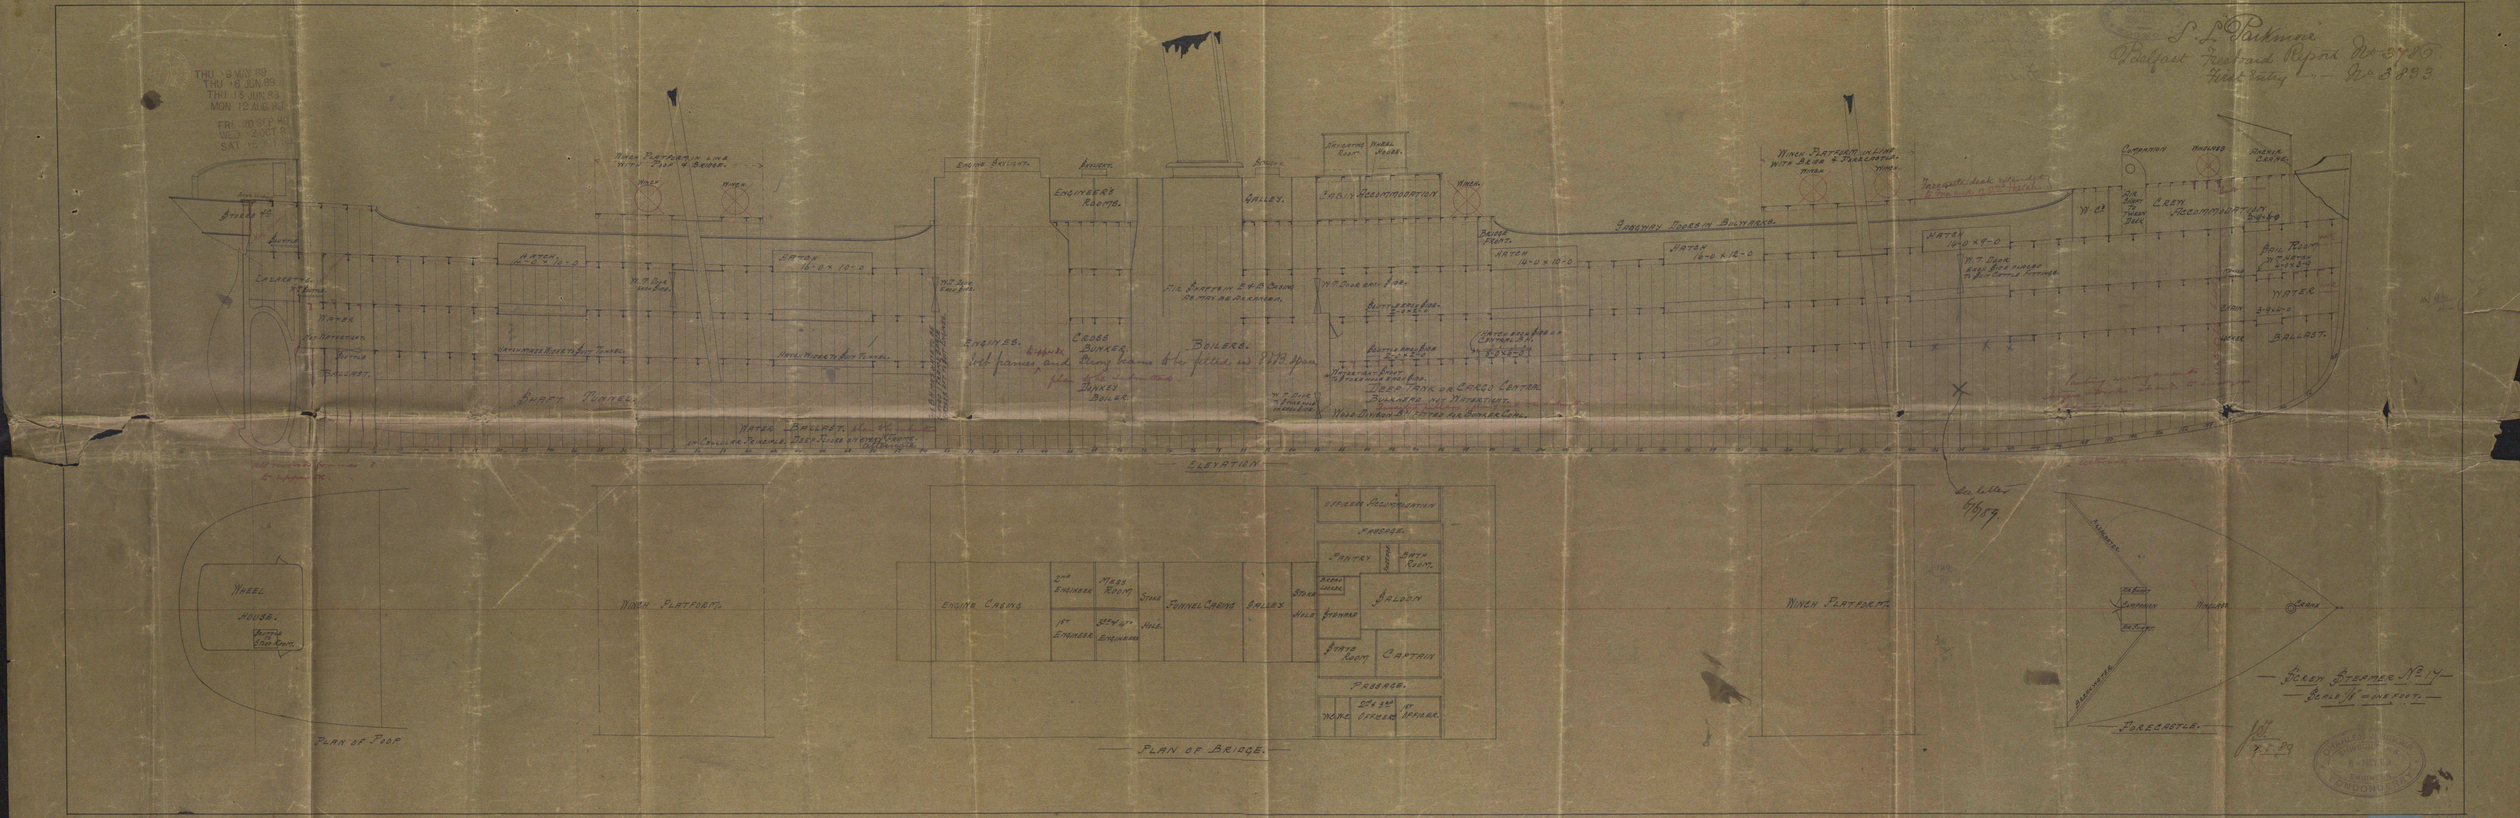
S. S. Palmerie
THU 18 MAY 89
THU 15 JUN 89
MON 12 AUG 89
FRI 20 SEP 89
WED 25 OCT 89
SAT 18 NOV 89
Winch Platform in line with Bridge & Poop Front
Engine Casing
Bridge
Engineer's Rooms
Galley
Saloon Accommodation
Winch
Bridge Front
Hatch 16-0 x 10-0
Hatch 16-0 x 12-0
W.T. Door
Bunker Door
Bunker Door Trimmers
Hatch 16-0 x 10-0
Hatch Tunnel
Water Ballast
Engines. 6 Work. Set frames and
Cross Bunker. Bunkers Boiler.
Boilers. 6 to feed to 210 lbs.
