


— Elevation of After End No 76 S.S. — *S.D. Eveleen Bel Rpr 3872*
 — Showing alternative Arrangement —
 — Scale 1/8 inch = one ft. —

WED 26 MAR 90

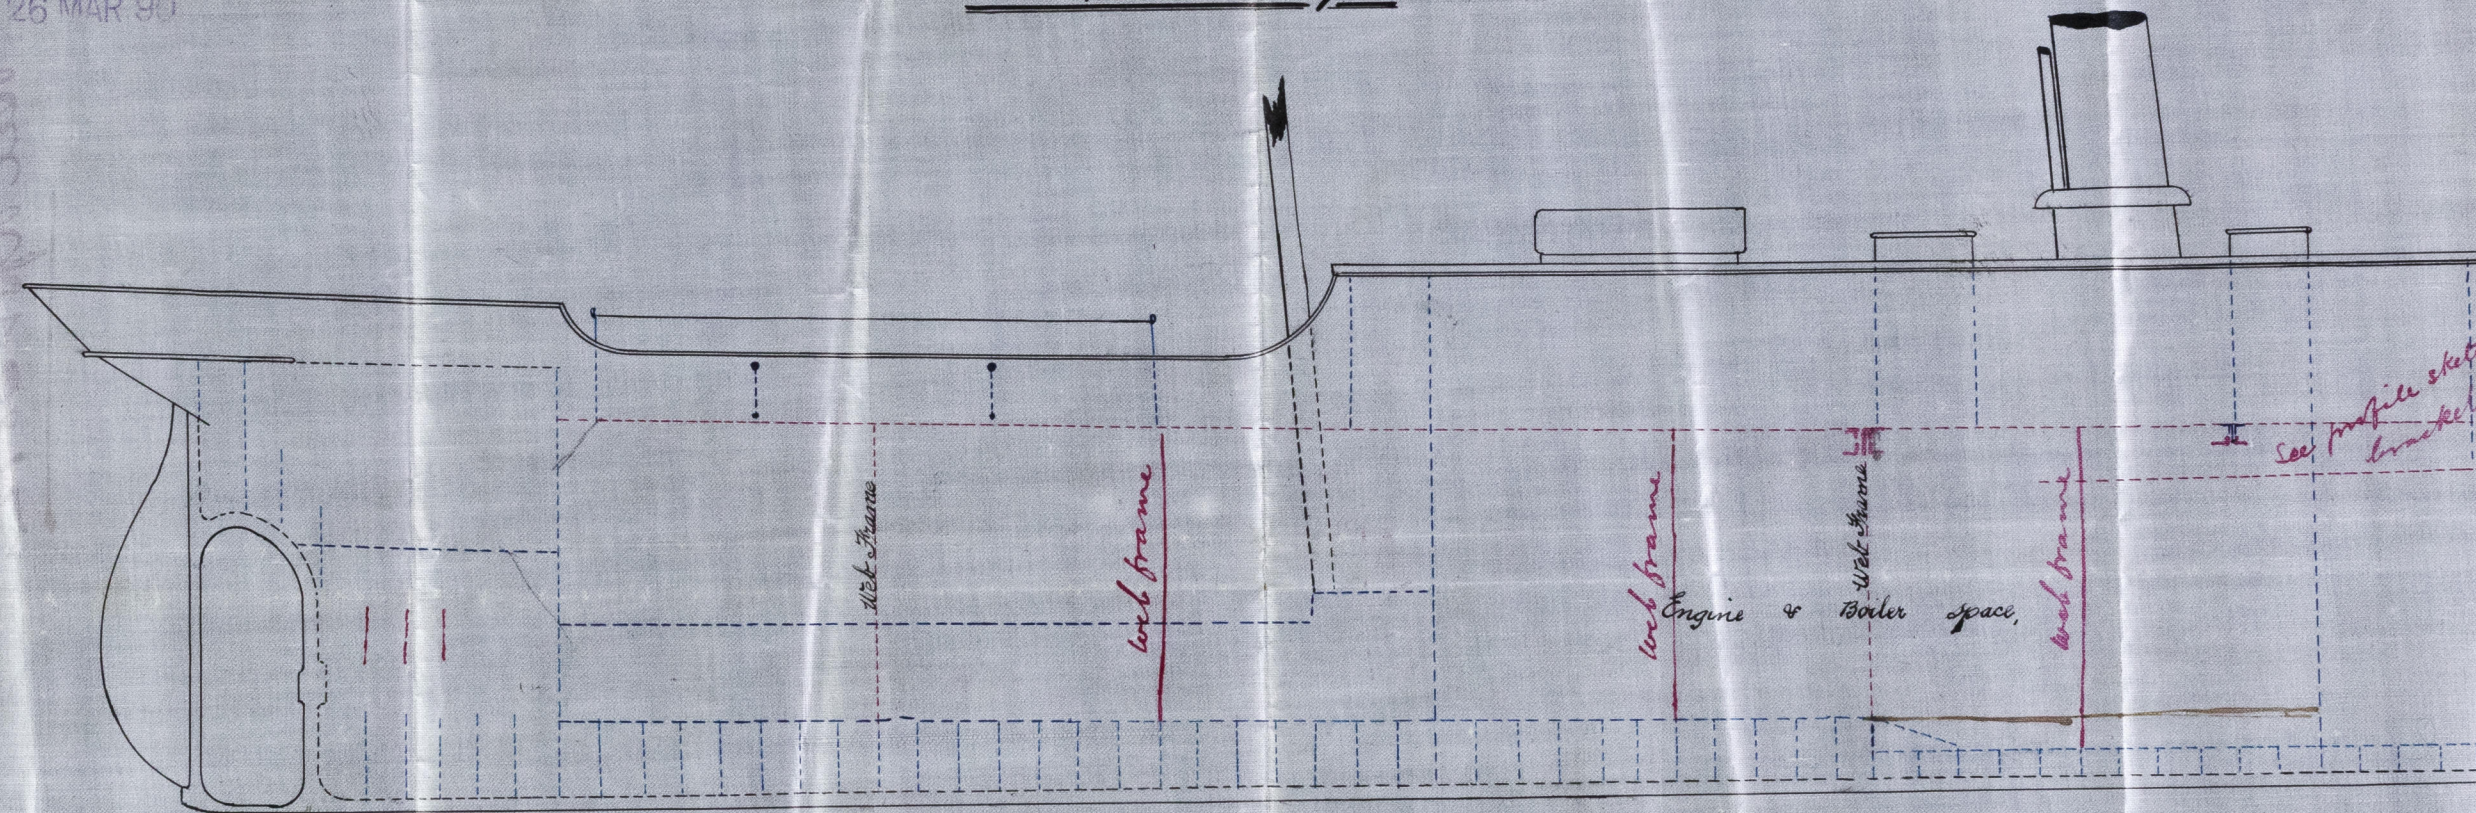

See profile sketch for doubling at break brackets etc.

See full profile for amendments.



Am 21.3.90

BEL58-102



© 2019

Lloyd's Register
Foundation

SS No 476

Freeboard Rpt No 31/63

S/S Ewellen

BEL 58-102

Bel Rpt 3872



© 2019

Lloyd's Register
Foundation