


Section shewing Quarter Deck at line A on Elevation.

H^o 76 SS.

S/S Evelyn Bel Rpt 3872

WED 26 MAR 90

Scale $\frac{1}{2}$ inch = one foot.

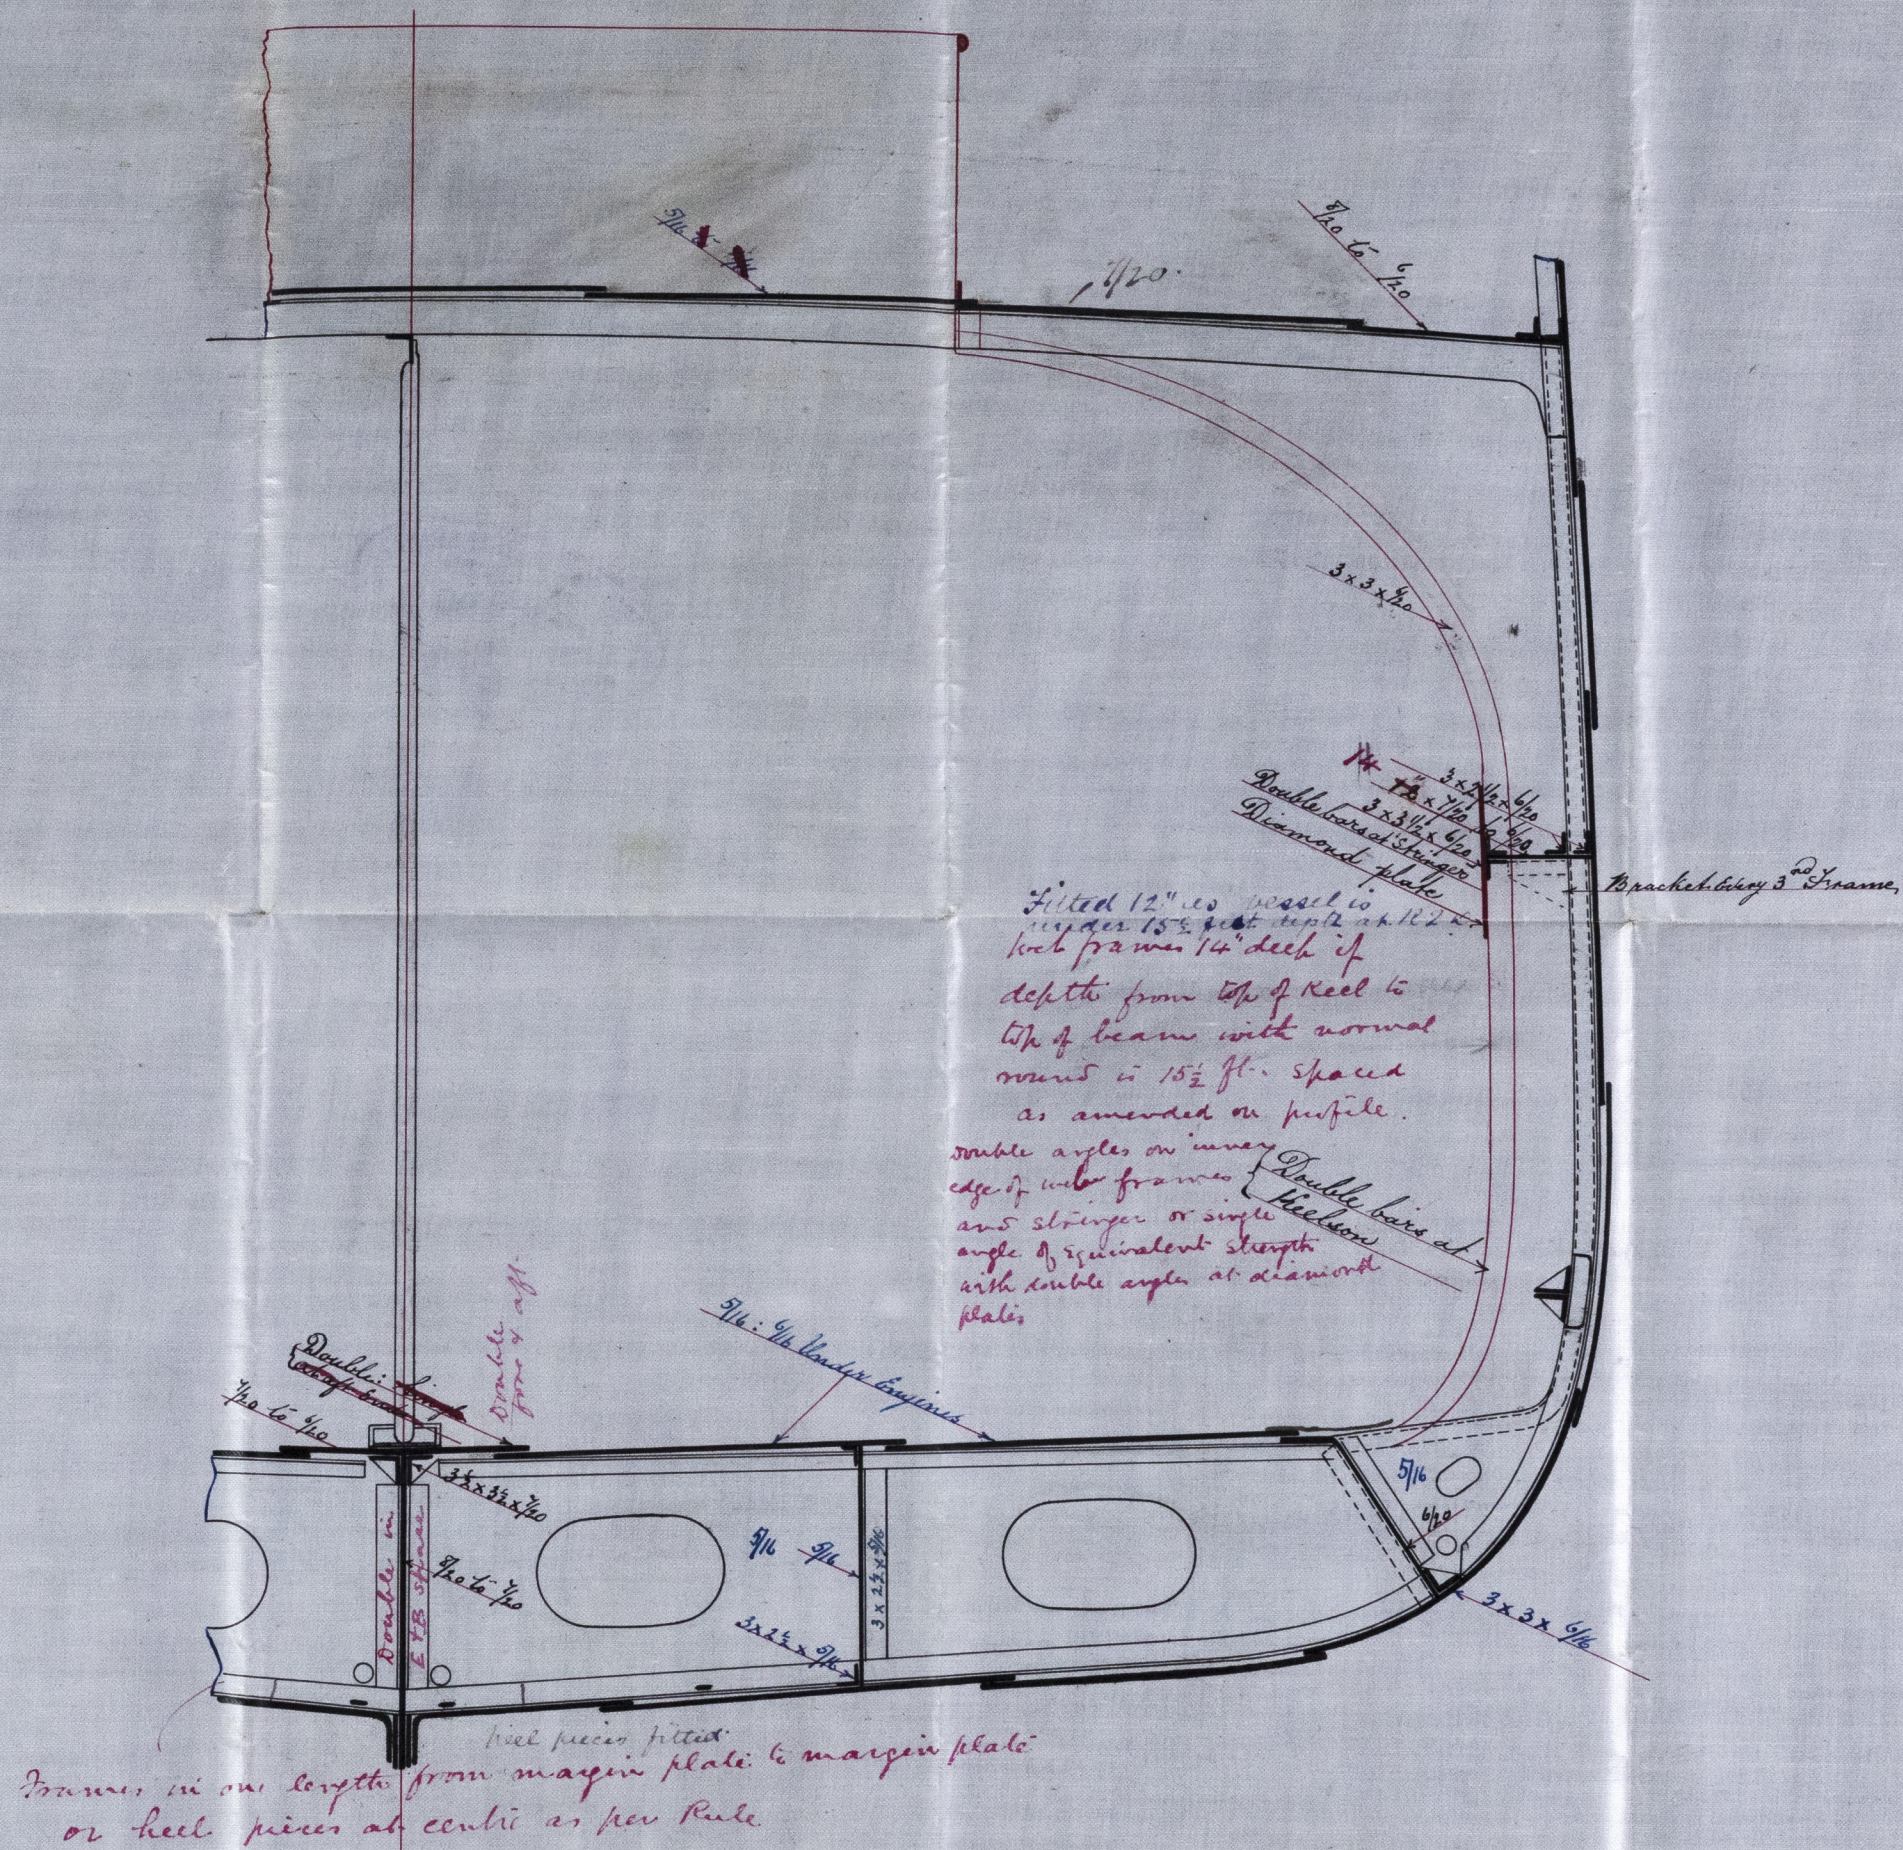

Note: - Lines in red show the Web frames, and Web beams at hatchways.

Note:- Scankings written in blue refer to iron.



26/3/90

Ph. 21-3-9

13ECS8-103

S/S Eveleen

Bee Rpt 3872

~~Sub provided material~~

BELS8-0103

R _____

of _____



© 2019

Lloyd's Register
Foundation