


Section thro' Engine Casing.


Scale $\frac{1}{2}$ inch = one ft.

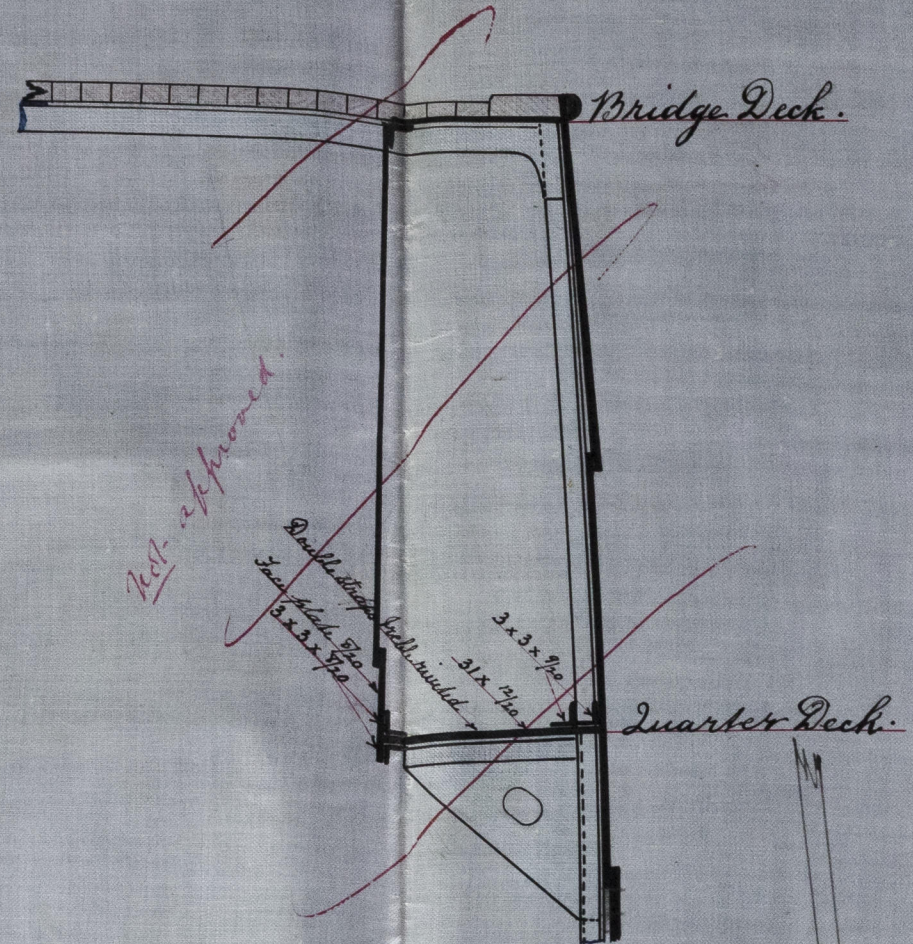

Sp Eveleen Bell Rpr 3872



Elevation & Deck Plan. No. 76. S.S.

Scale 8 inch = one ft.

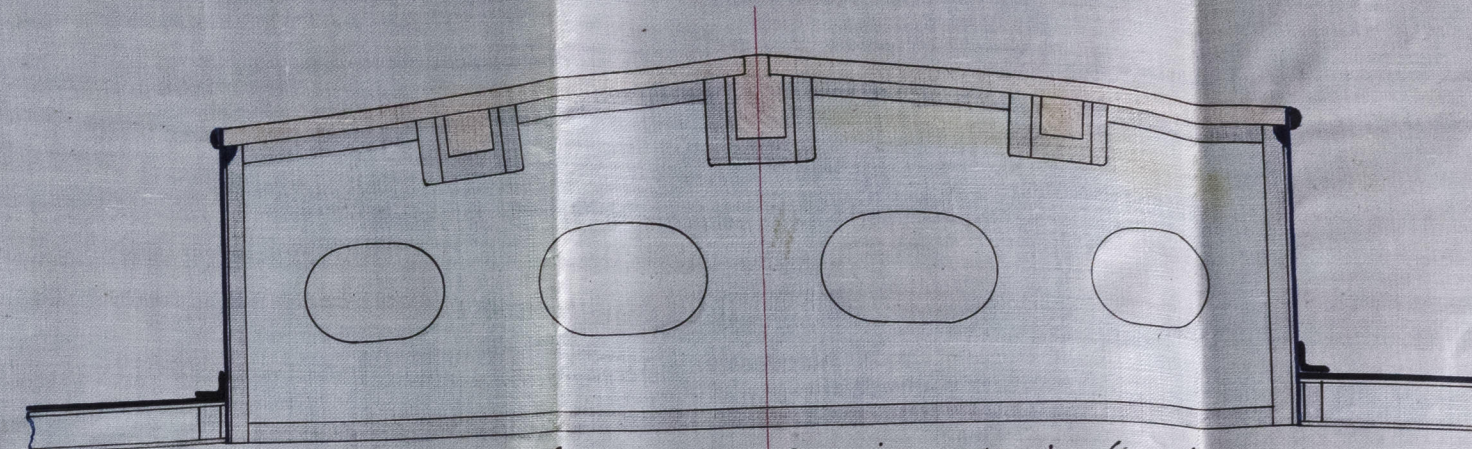

Shuwarship Section of Main Huseh.

Scale $\frac{1}{2}$ inch = one f^t.

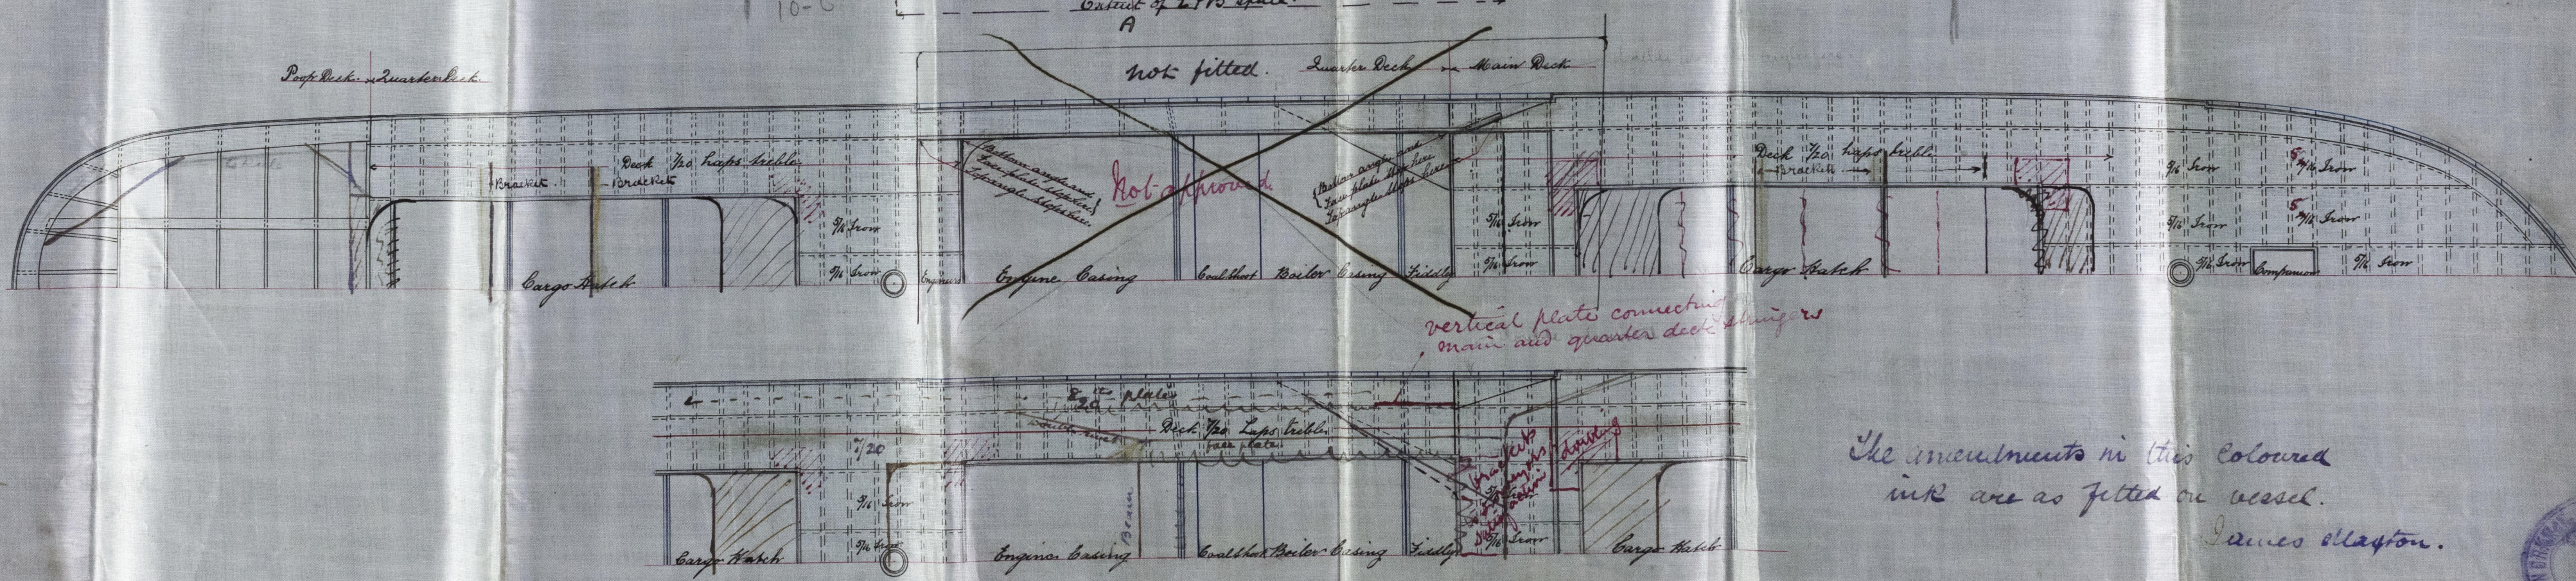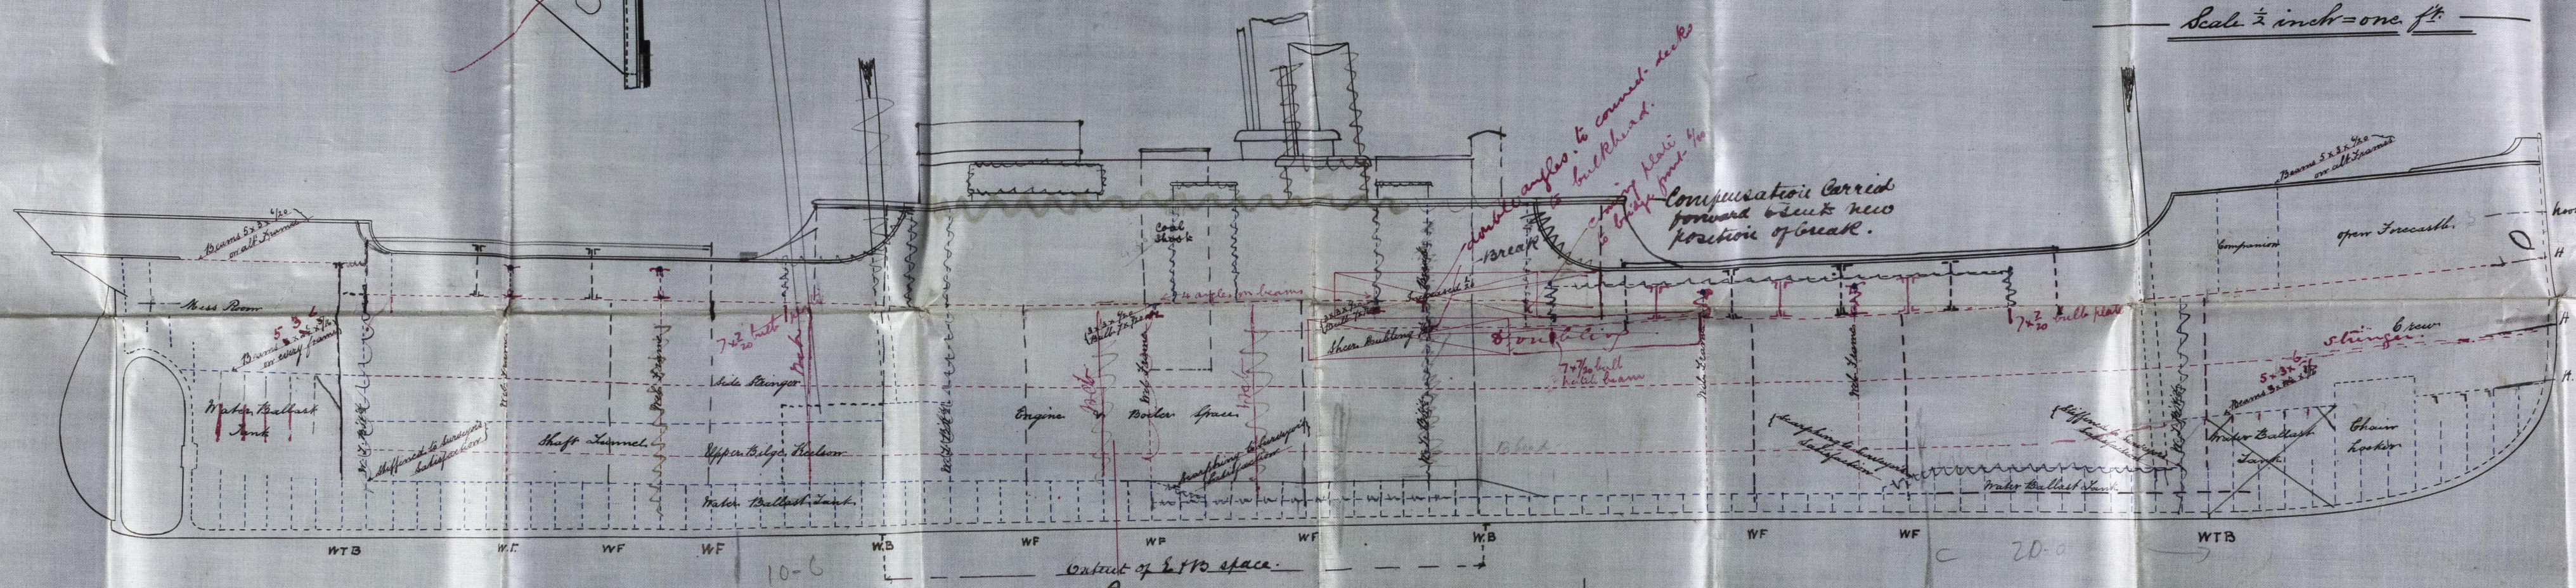

The amendments in this Coloured
ink are as fitted on vessel.

James Clayton.

Alternative Plan ~~Filed~~ as amended.

© 2019

S/S Eveleen

Bel Rpt 3872

BEL 58-0104

ms no 20 for
in 1900/1901

ME

ME



© 2019

Lloyd's Register
Foundation