


S.S. "Stream Fisher"

Bel. Rpt 2916

SAT 27 SEP 90

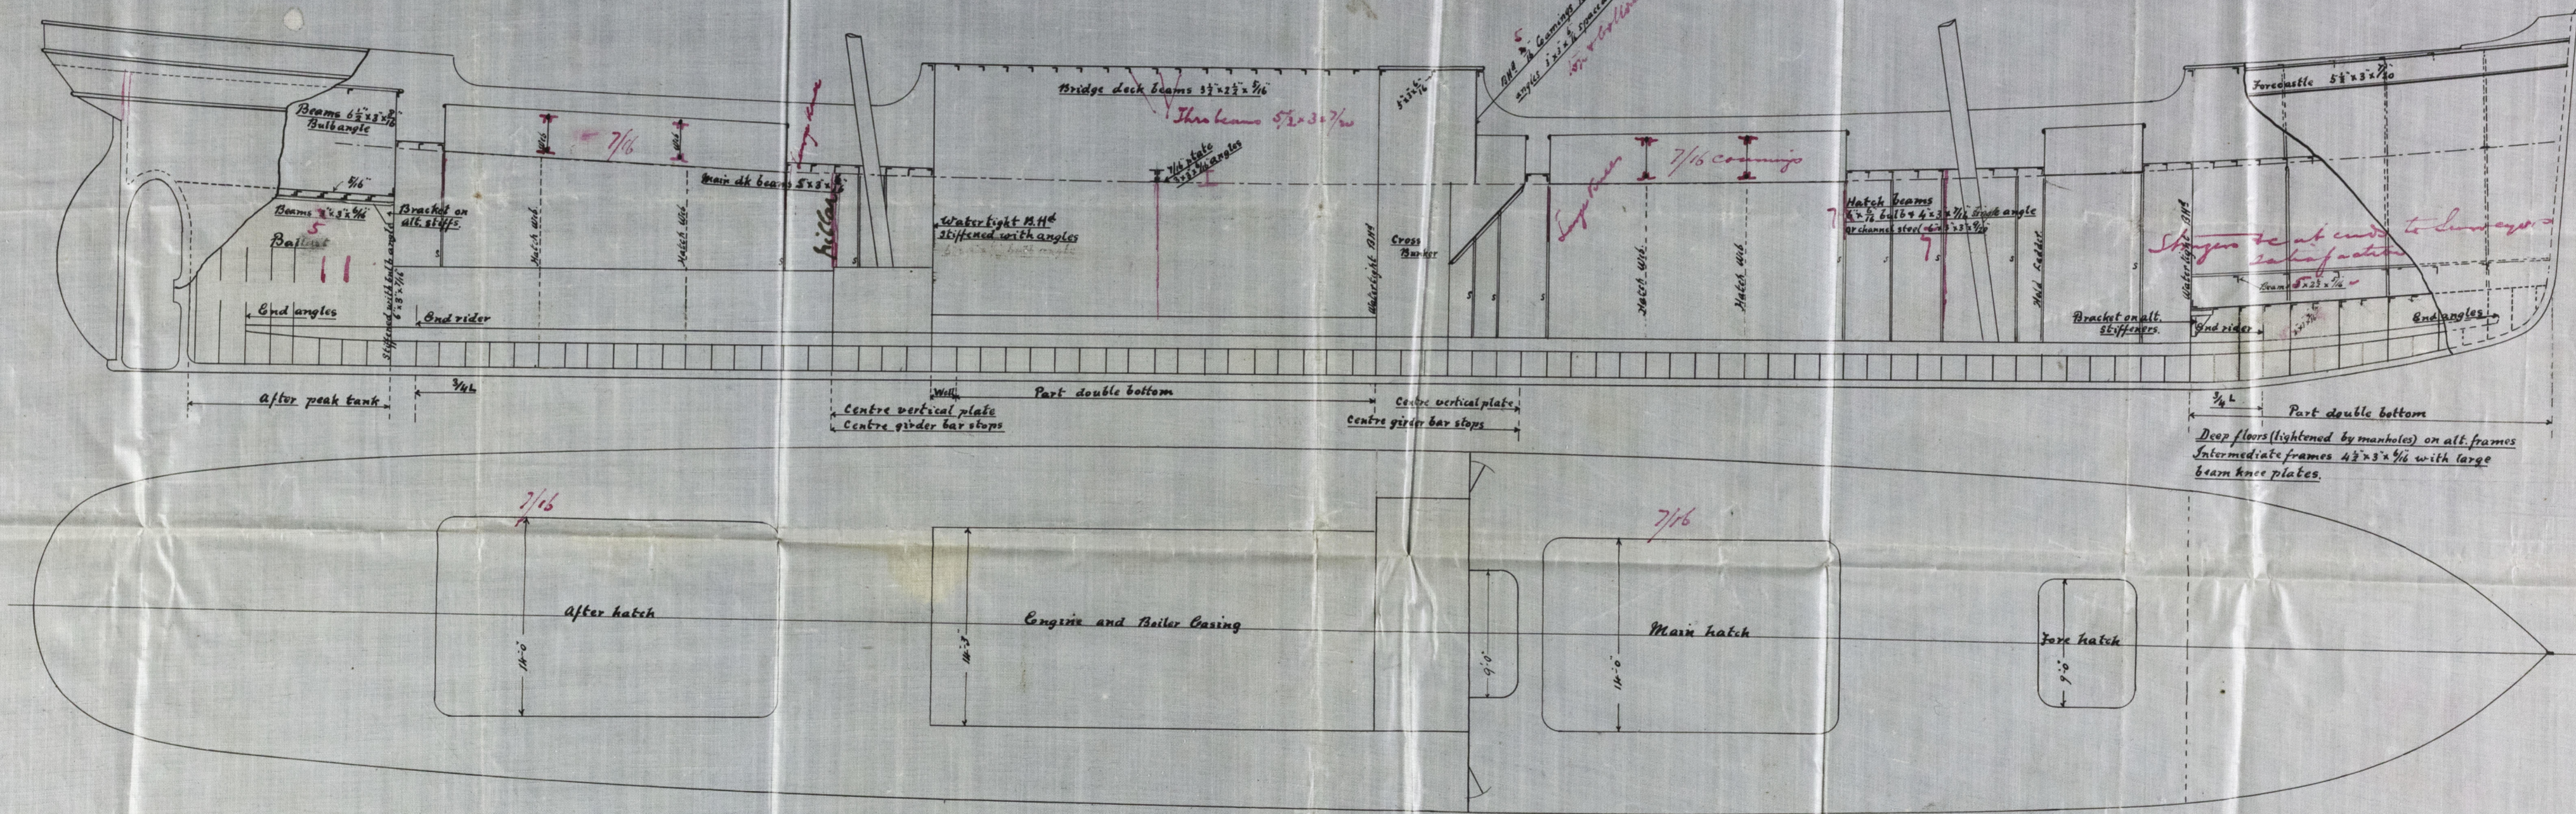

LONGITUDINAL SECTION AND DECK PLAN

S.S. N° 46.

Scale 1" = 1 foot


MACILWAINE & MACCOLL, LIMITED
SHIP BUILDERS AND ENGINEERS
BELFAST

46

46

S.S. Stream Fisker
Bel Rpr 3916

SVL 525598

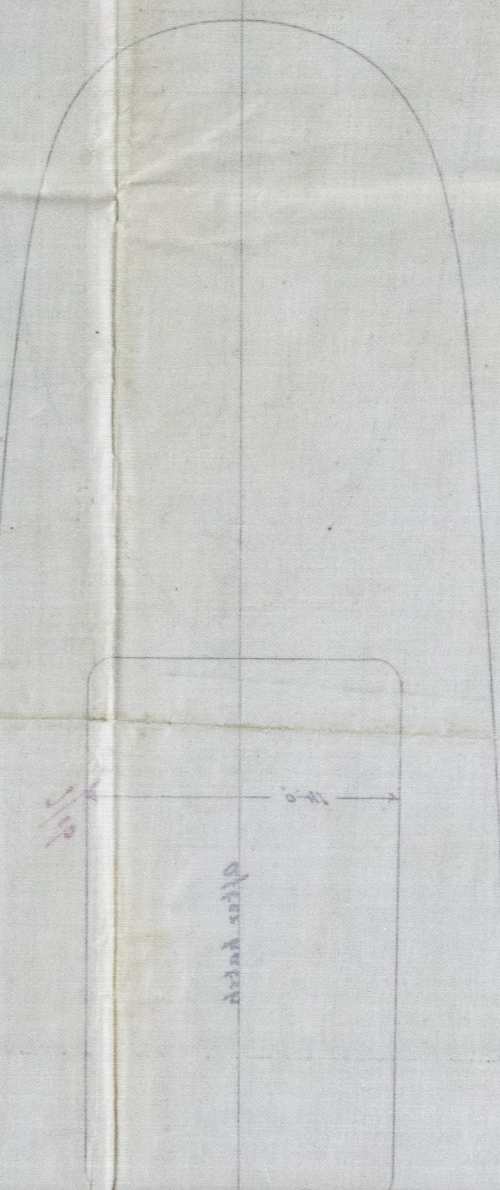

© 2019

Lloyd's Register
Foundation