
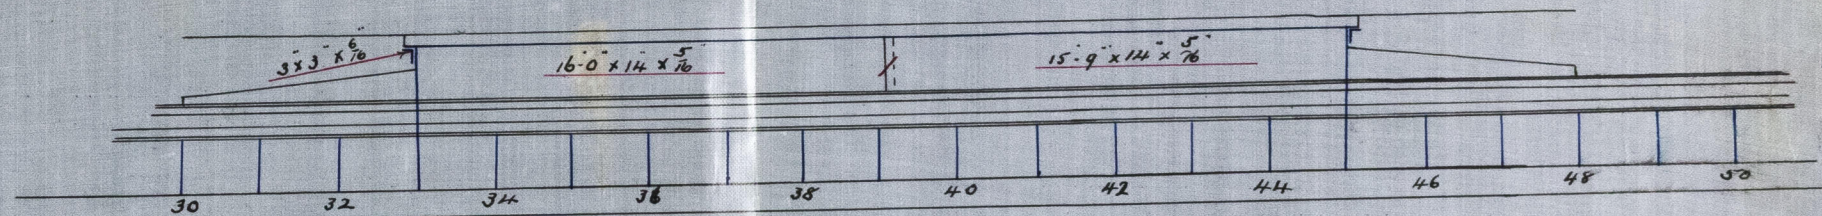


S. S. "Susannah Kelly"
Alterations effected May 1891

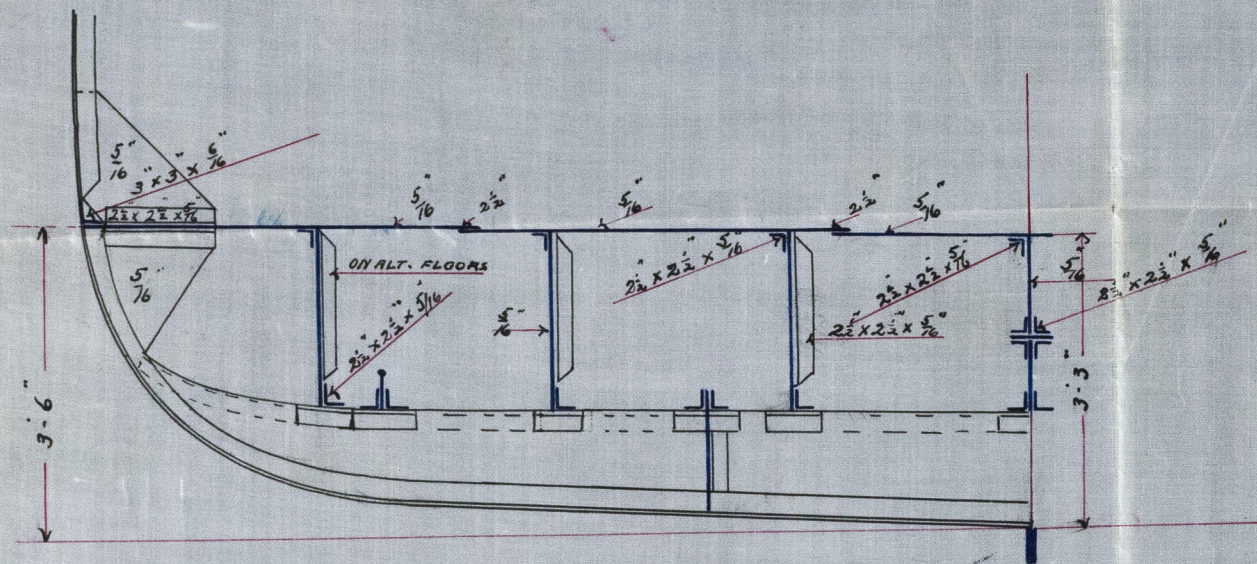

- N^o 43 -

DOUBLE BOTTOM

SCALE $\frac{1}{2}$ & $\frac{1}{4}$ = 1 FOOT

