

Received at Belfast office, May 2nd 1891

Lloyd's Register of British and Foreign Shipping.

(Report on Vessel No. 80 Port Belfast)

Belfast

No. 1935 a

SHIP FORGINGS OR CASTINGS.

The words FORGINGS or CASTINGS, IRON or STEEL, should be struck out as may be required.

I have to report that the undermentioned Iron or ~~Steel~~ Forgings or Castings, manufactured by

The Stockton Forge Co. of Stockton

for the Vessel No. 80, being built by Imperial Iron Works Clark & Co

of Belfast have been inspected by me as set forth below, and found to be, so far as can be seen, sound.

Mark on Forgings.


Lloyd's
No. 1935 a
80 Co.

Hugh Cannon

Sunderland
1-5-91

	STERN FRAME.	RUDDER FRAME.	STEM.
Material*	<u>Scrap iron</u>	<u>Scrap iron</u>	
How made	<u>Faged</u>	<u>Faged</u>	
Dimensions	<u>9' x 5 1/2'</u>	<u>7 1/2' x 3 1/2'</u>	
Progress on Inspection	<u>Finished</u>	<u>Faged & smithed</u>	
Dates when Inspected	<u>July 16/91</u>	<u>March 20-26 April 9-14-17</u> <u>20-21-27/91</u>	

SKETCHES OF FRAMES SHEWING POSITION AND DESCRIPTION OF WELDS OF FORGINGS, OR PARTICULARS OF TESTS APPLIED TO CASTINGS.

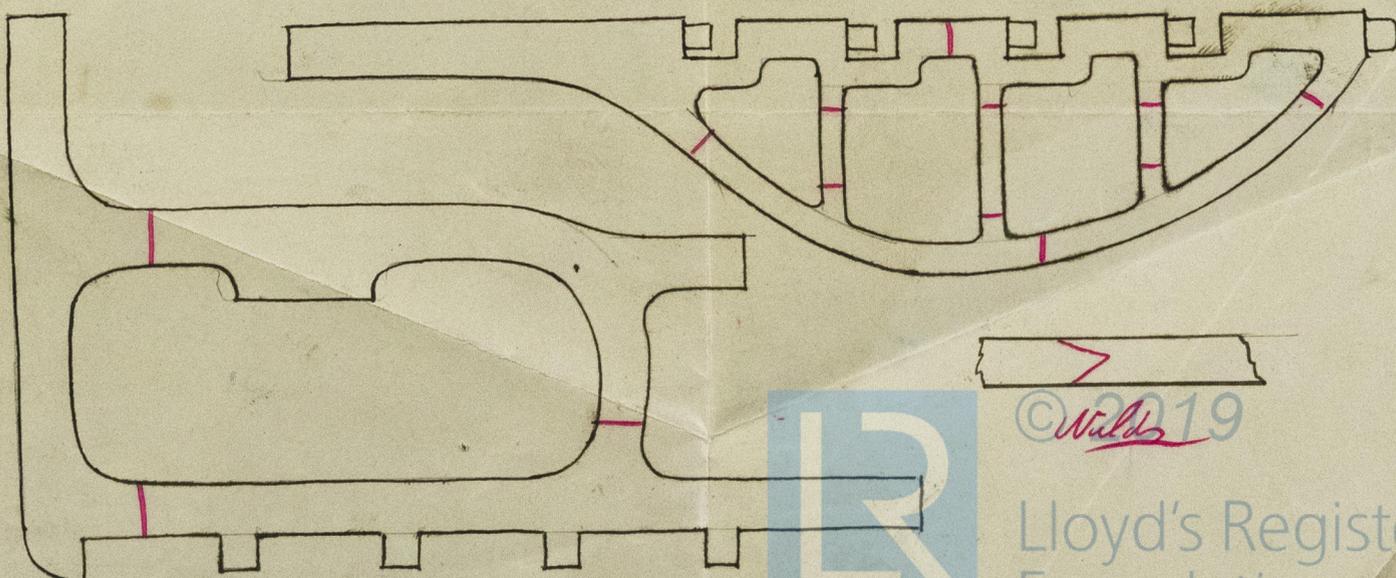

© Walds 2019

Lloyd's Register
Foundation

* If of Iron, state whether scrap or puddled iron.

80.

Re. Ship forgings
on Stern & Rudder
frame,

2nd May 1891

"Ardamhor"

Bel Apt 3975



© 2019

Lloyd's Register
Foundation