



"Adanmkor"
Bel Rpt 3975

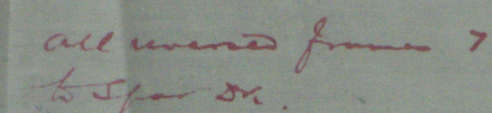

note:- A longitudinal section & deck plans, will be submitted hereafter, shewing arrangement of Web Girders, Heavy Beams & Deck Plating amidships. ✕

Em. 11-10-90

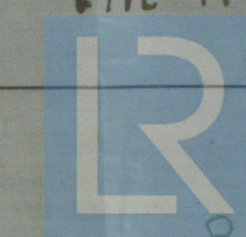

85221-0031

11-10-60






Longitudinal
80

Adanmhor

Adanmhor

Del. Rpt 3975


08



© 2019

Lloyd's Register
Foundation