


Del Rpt 3975

Adammhor
Bel Rpt 3975

Adammhor
Bel Rpt 3975

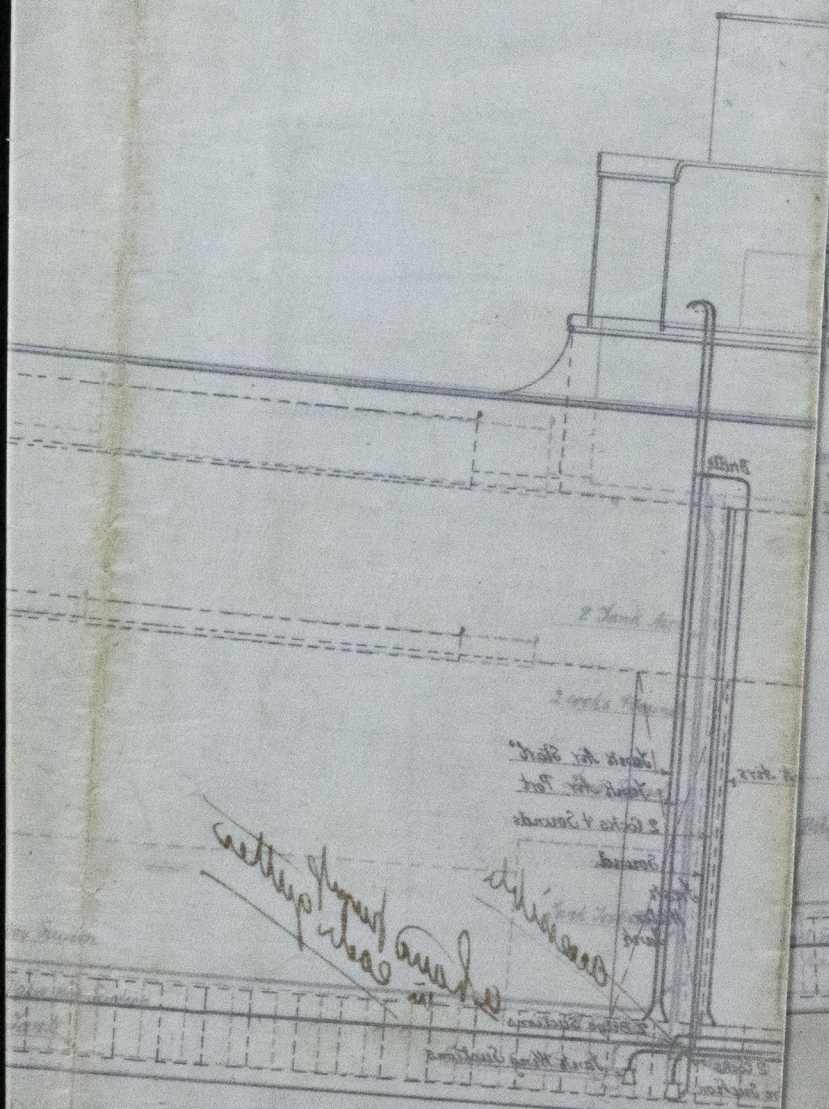

© 2019

Lloyd's Register
Foundation