

Ltr. 9/7/91

30116 251 10 11


1703 240 + 241

PUMPING ARRANGEMENT  
SOUTH SIDE

3th July  
1891

S.S. Chesire

Bel Rpt No 3970

 

M.L.  
9.7.91




240 + 241

Pump plan

240 S. S. "Cheshire"

Bel. Rpt 3970

Seang Choo

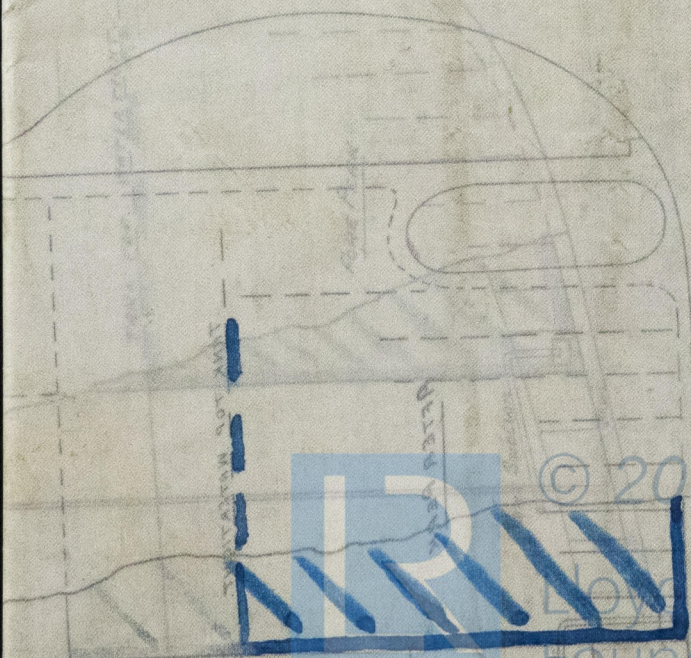

© 2019

Lloyd's Register  
Foundation