


26. 8. 91.

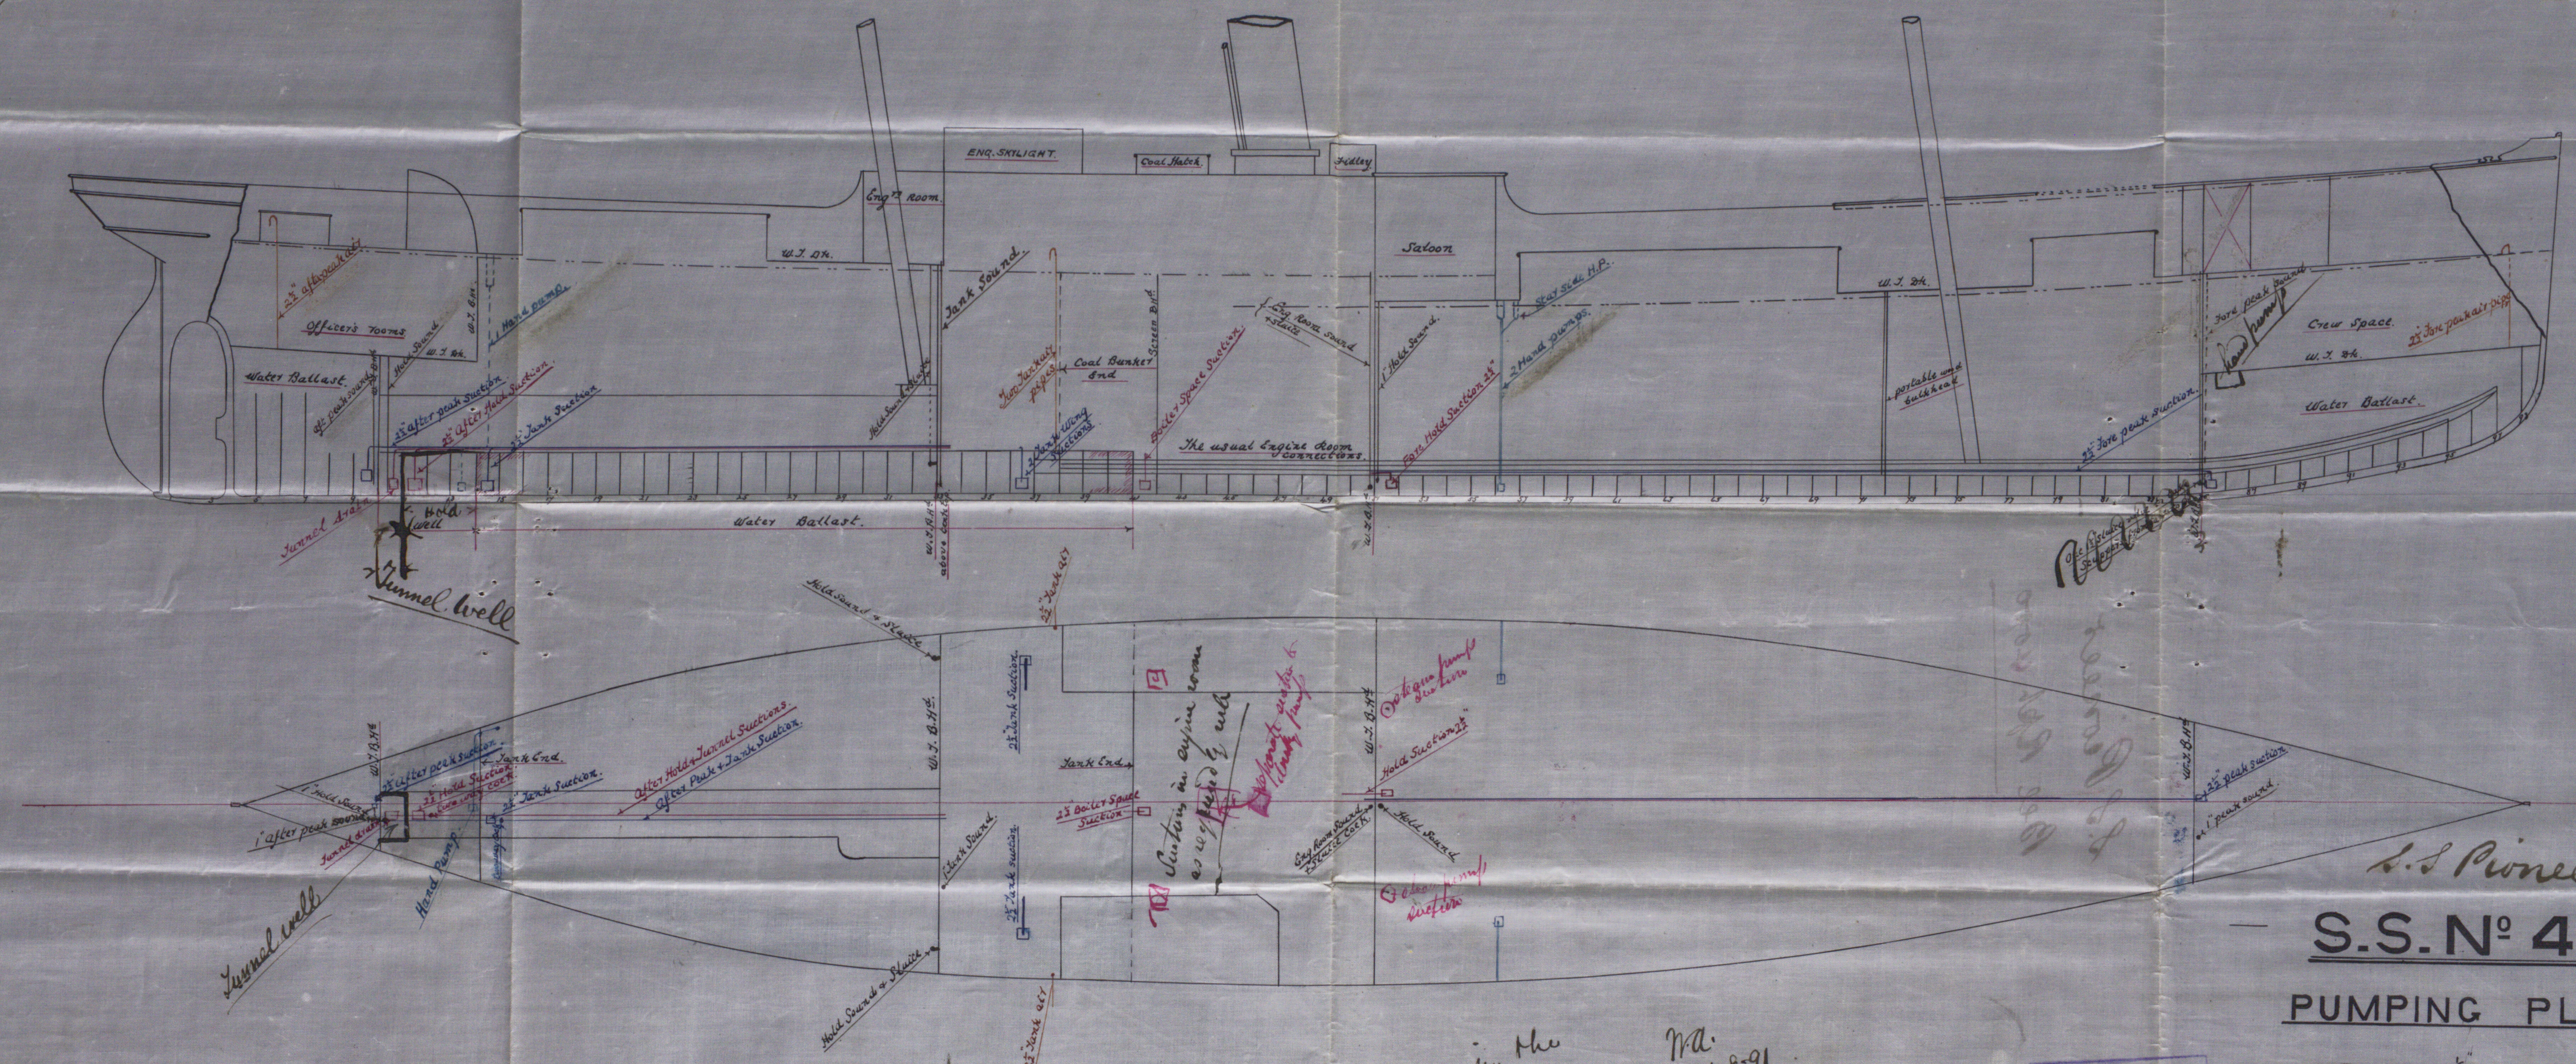

Stues in the machinery space
breechings dispensed
with at owners request
M.L.

na.
21. 8-91
26. 8-91

MACILWAINE & MACCOLL
LIMITED
17-2220. 15-8-91
SHIP BUILDERS & ENGINEERS

S.S. Pioneer
S.S. N° 48.
PUMPING PLAN
SCALE 1/8" = 1 FOOT.
Hold and Tank Suctions 2 1/2" dia. lead.

S.S. Pioneer
Bell Rpt 4000

© 2019

Lloyd's Register
Foundation