


9.04 Breadths ^{12.83} 13.02 Depths to Upper Deck. 16.87 ⁵ Depths to Middle Deck

^{ny}Freeboard Rpt. Bel. No 4048.

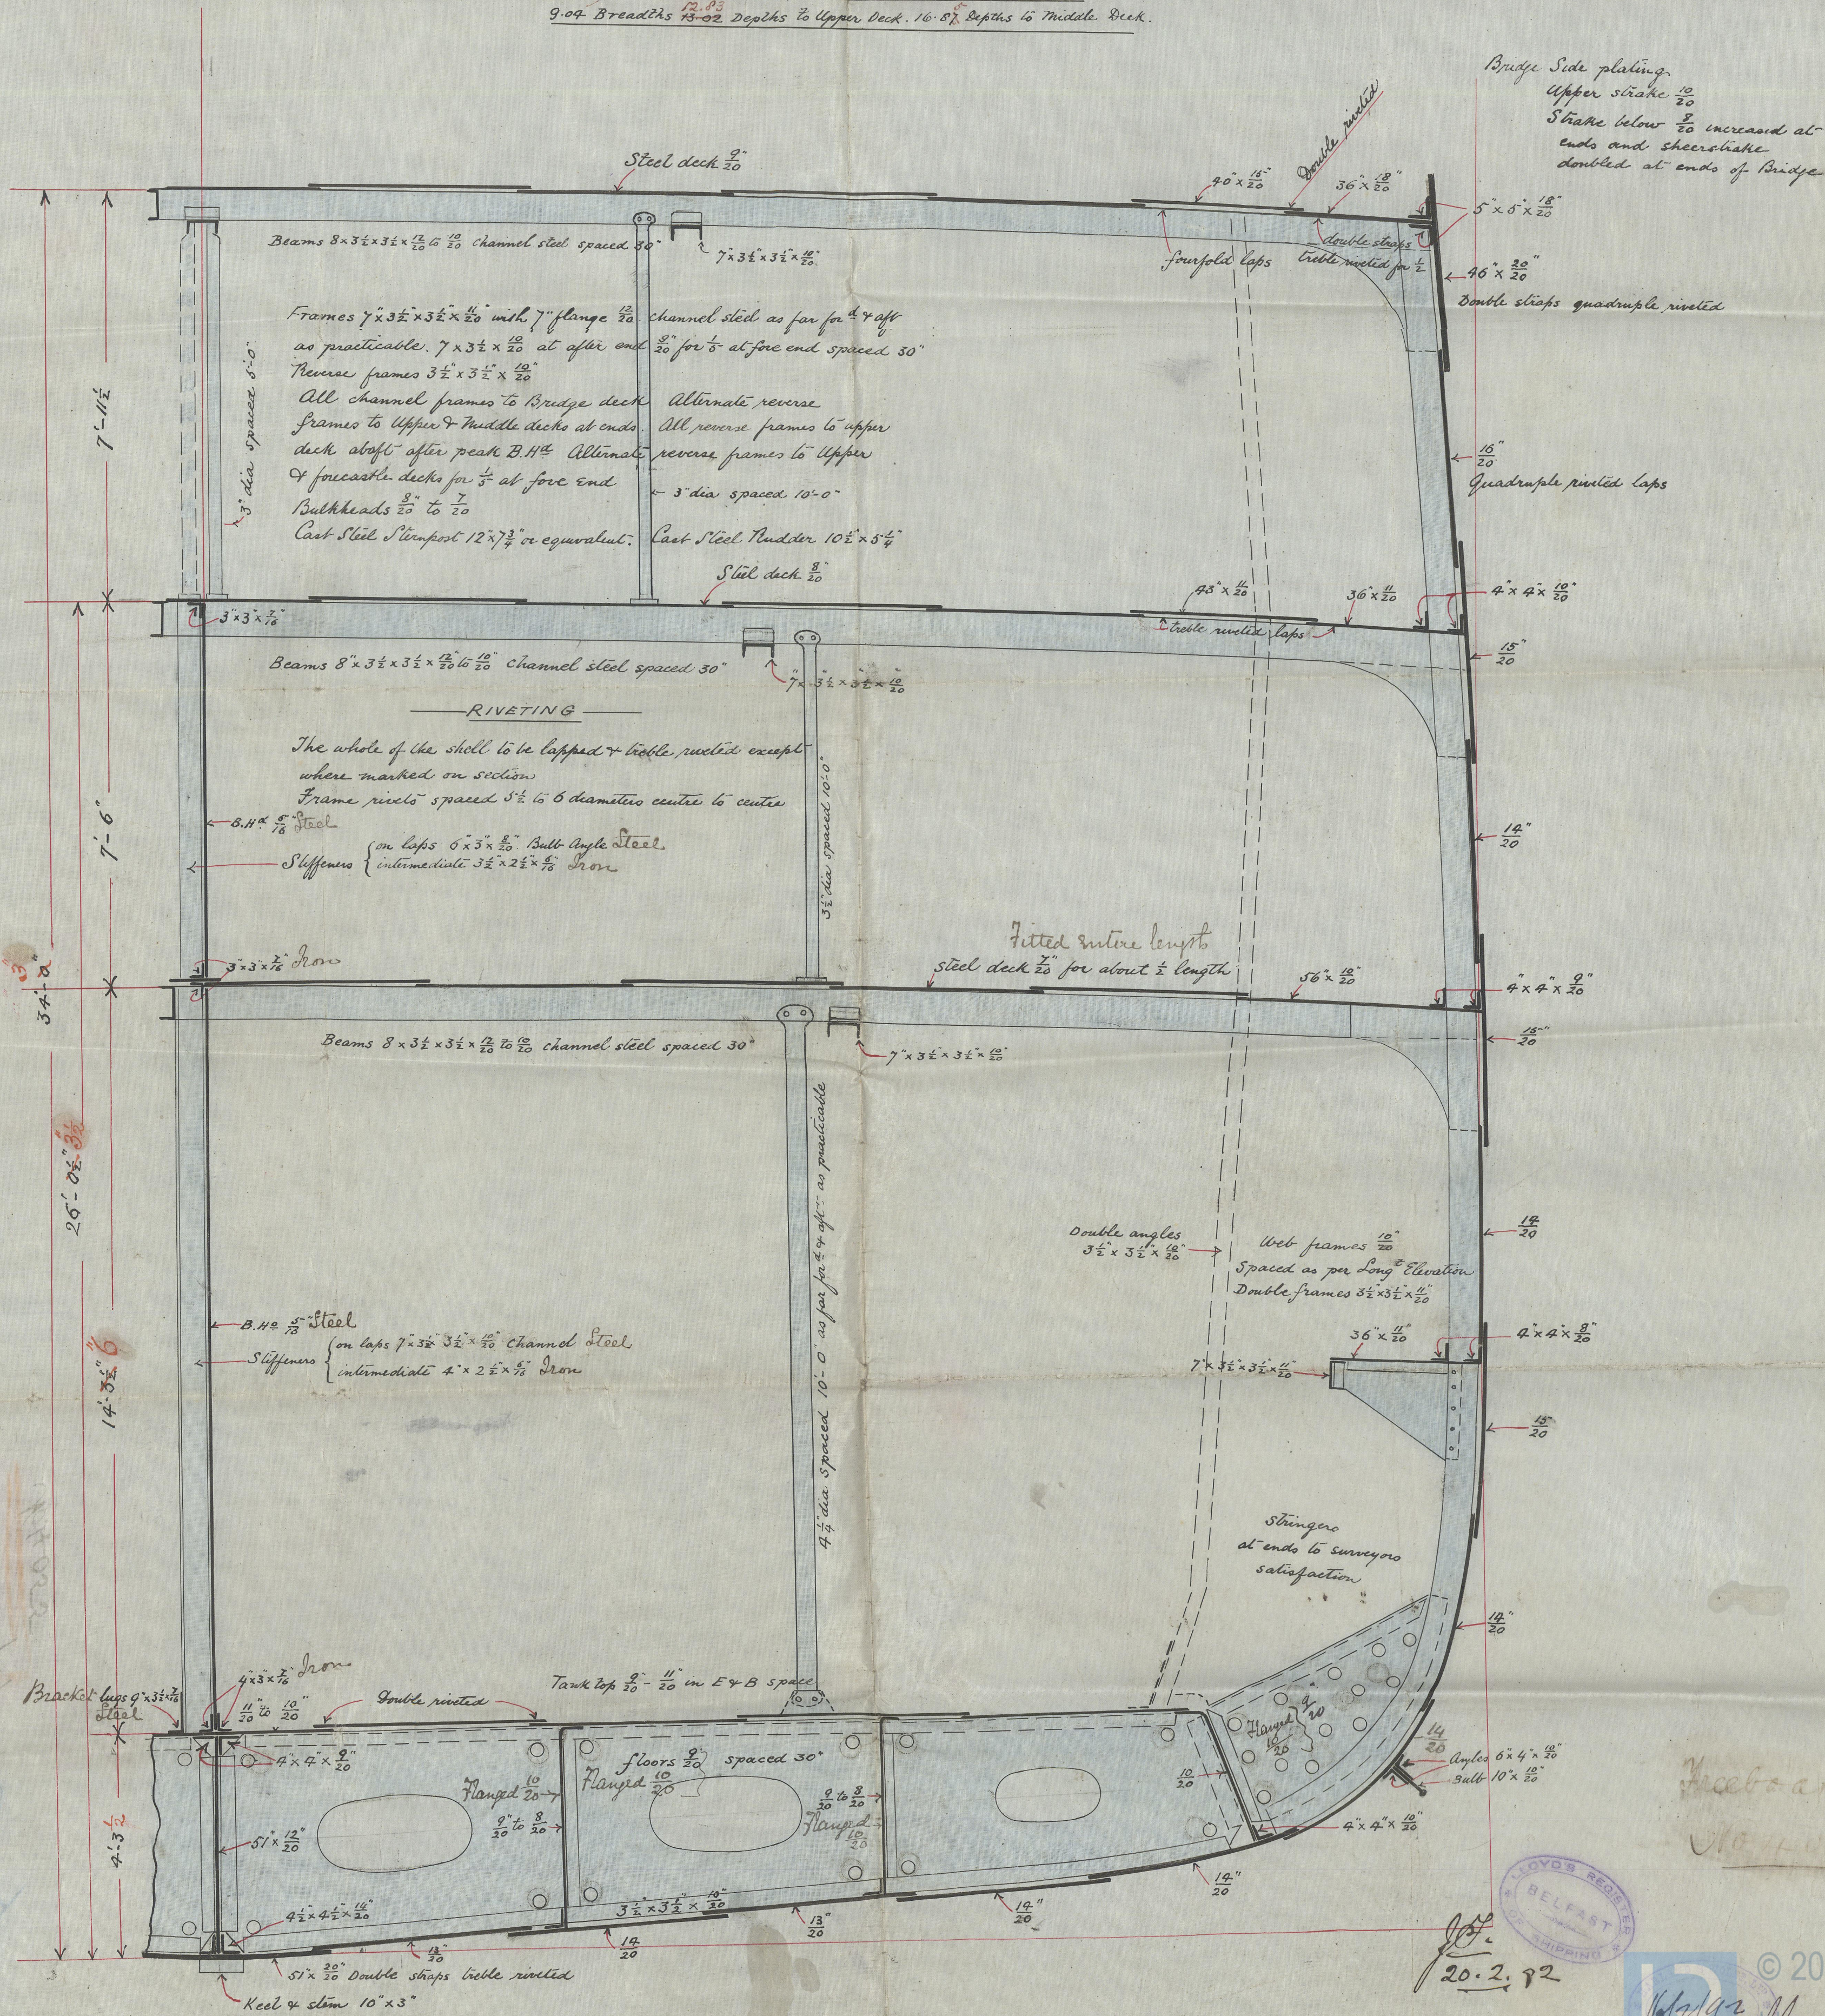

№ 40448

20.2.92

© 2021
Lloyd's Register
Foundation

Freeboard Rpt. Bel. No.
4048.

247 Copy
Bel. First Entry Rpt
No. 4055

2100-0732








© 2021
Lloyd's Register
Foundation