


2 1/2  
10

SCALE  $\frac{1}{2}$  INCH = ONE FOOT.

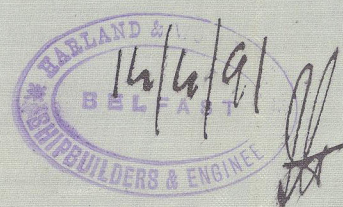

PM  
18/4/91



Main

247

Boiler plan  
(approved)

---

First Entry Rpt

Ref. No 4055

BEL00-0015



© 2021

Lloyd's Register  
Foundation