


12.12.91.


N° 89 Sailing Ship.

Head skewing bowsprit & bowsprit connection to deck.

Scale  $\frac{1}{4}$  inch = one foot.

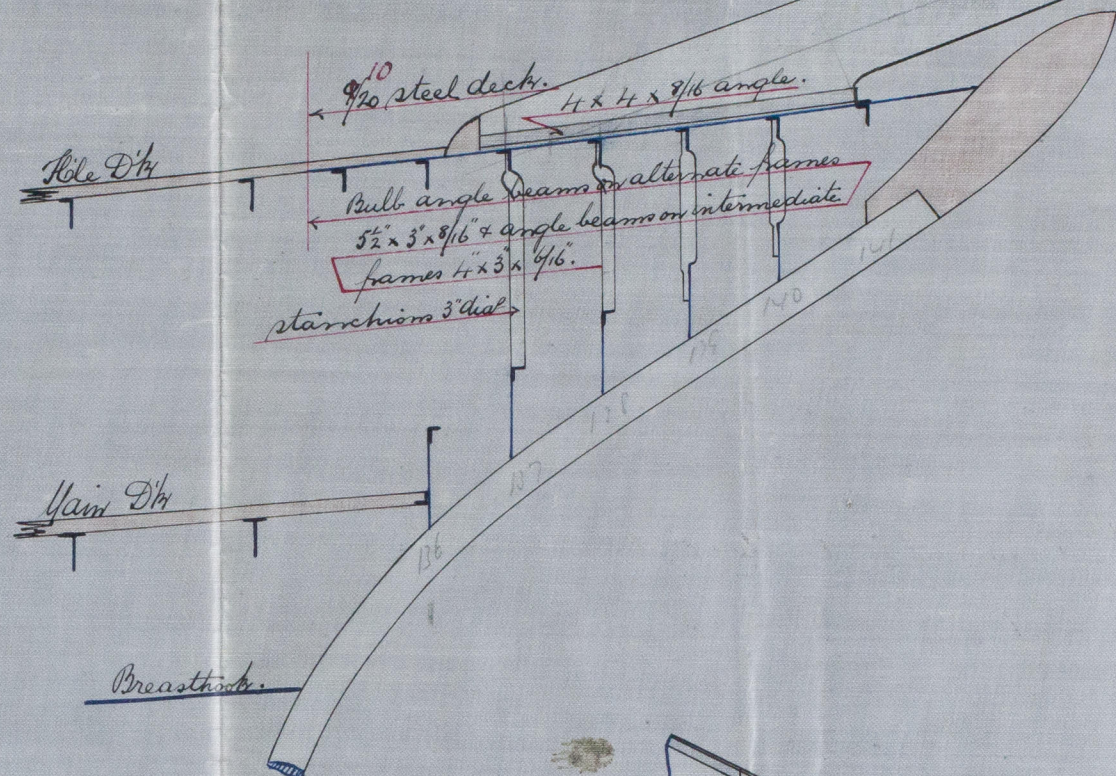


Elevation of Head.

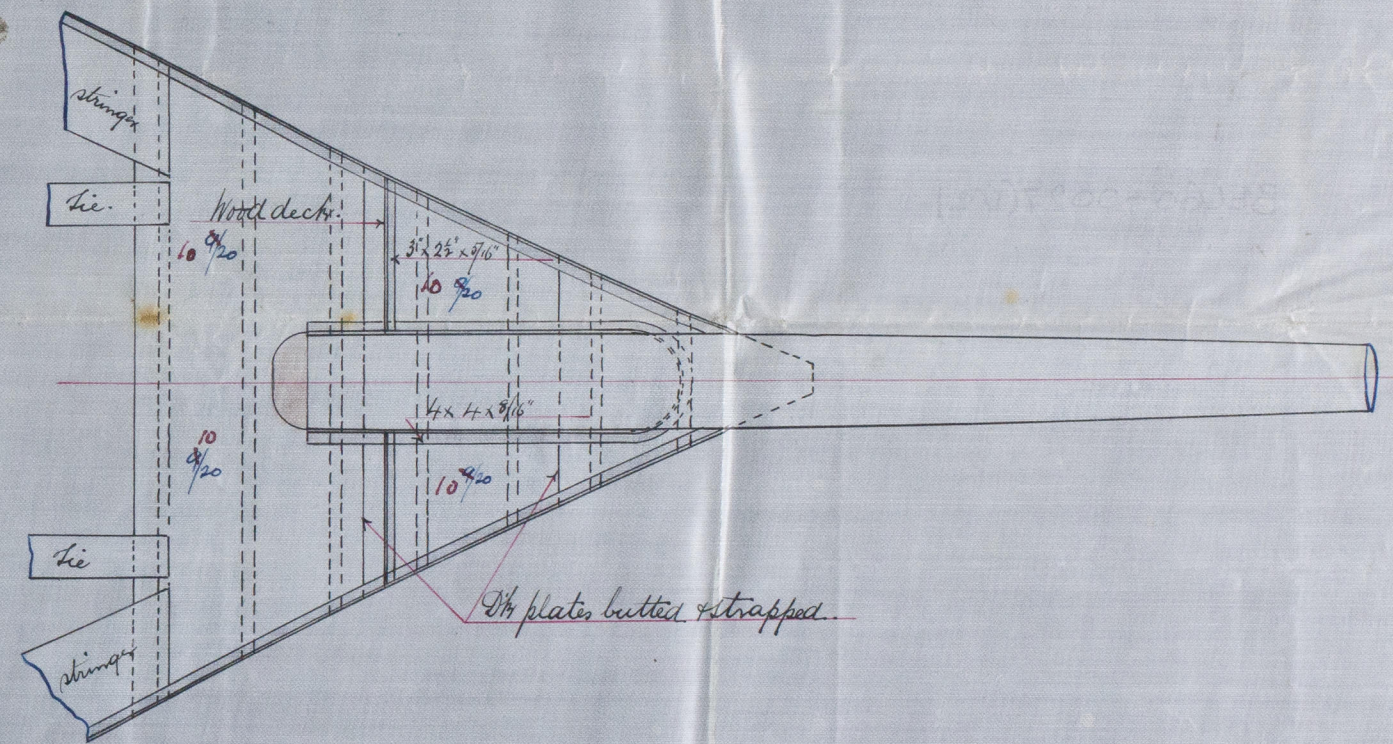


Deck Plan.

Plan of Bowsprit.

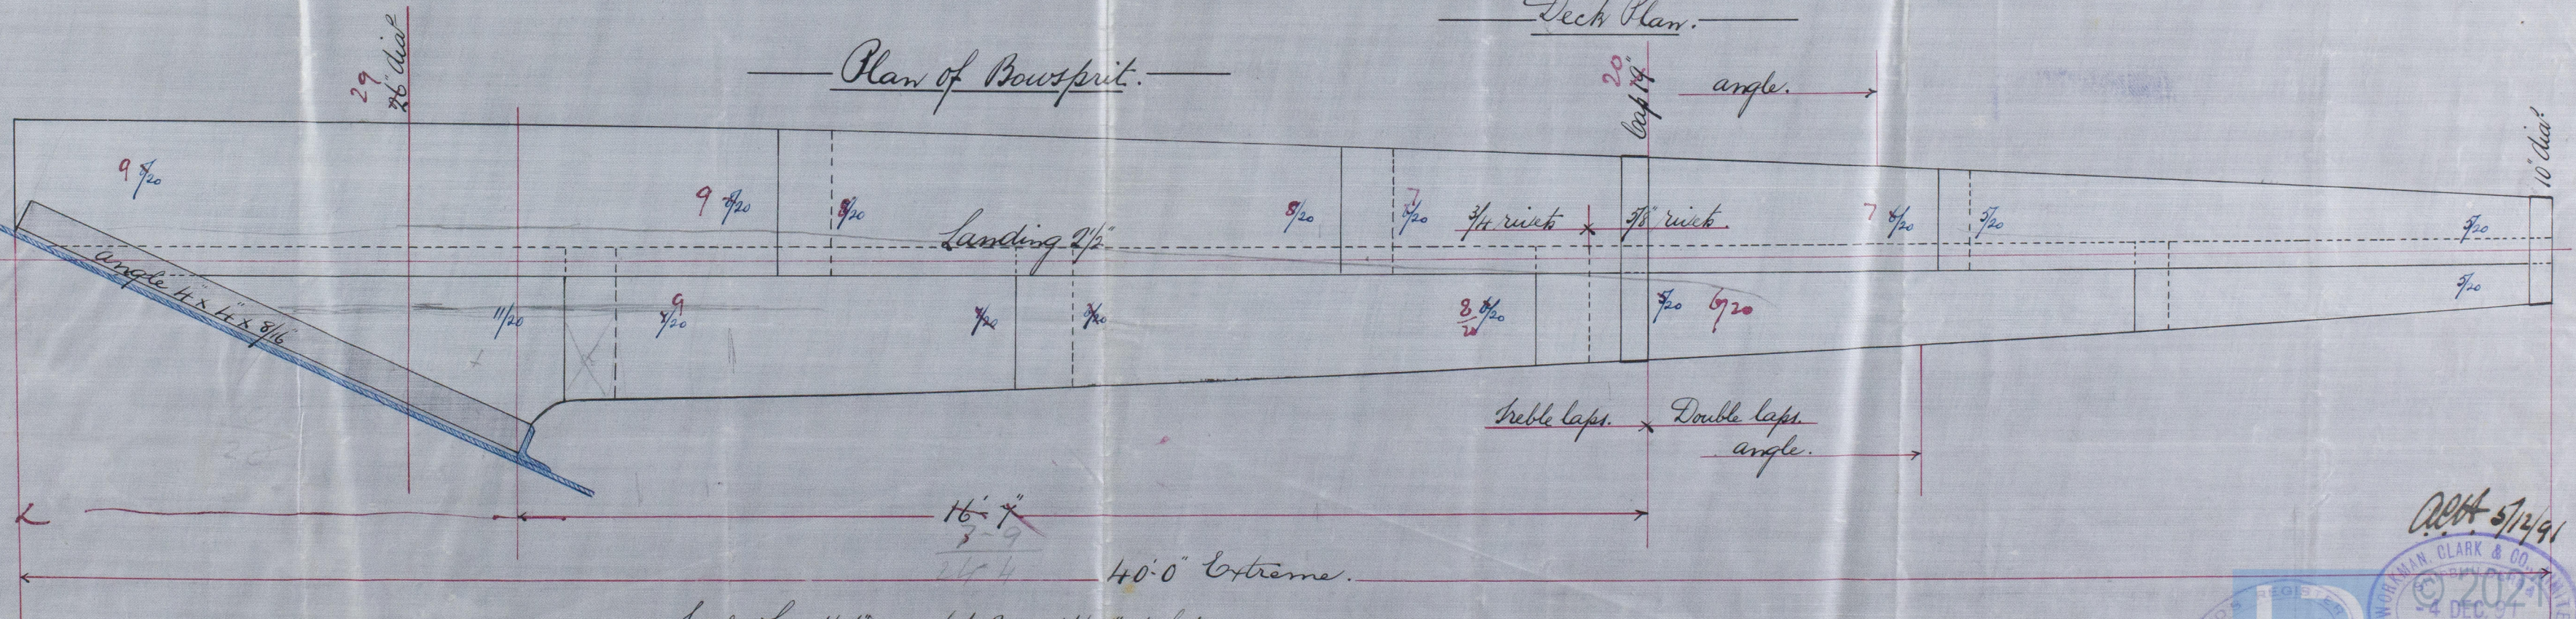

Scale. Length  $\frac{1}{2}$  = one foot. Breadth  $\frac{1}{4}$  = one foot.

3 plates in the round  
4 angles  $4 \times 3 \frac{1}{2} \times 9/20$   
& diaphragm plate.

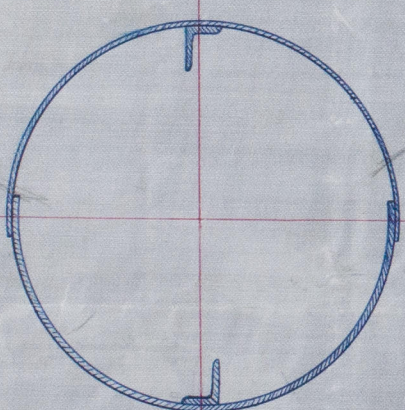




Section



89  
First Entry Report  
Bel No. 4058.



BEL60-0027(1/2)

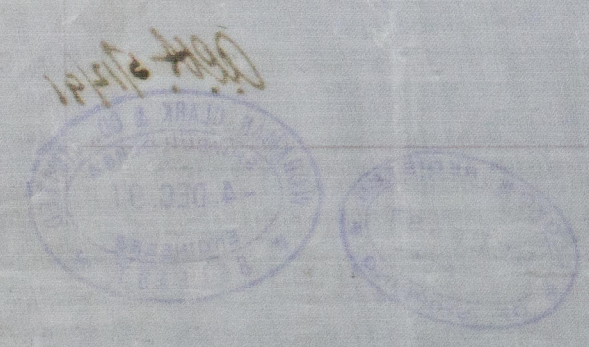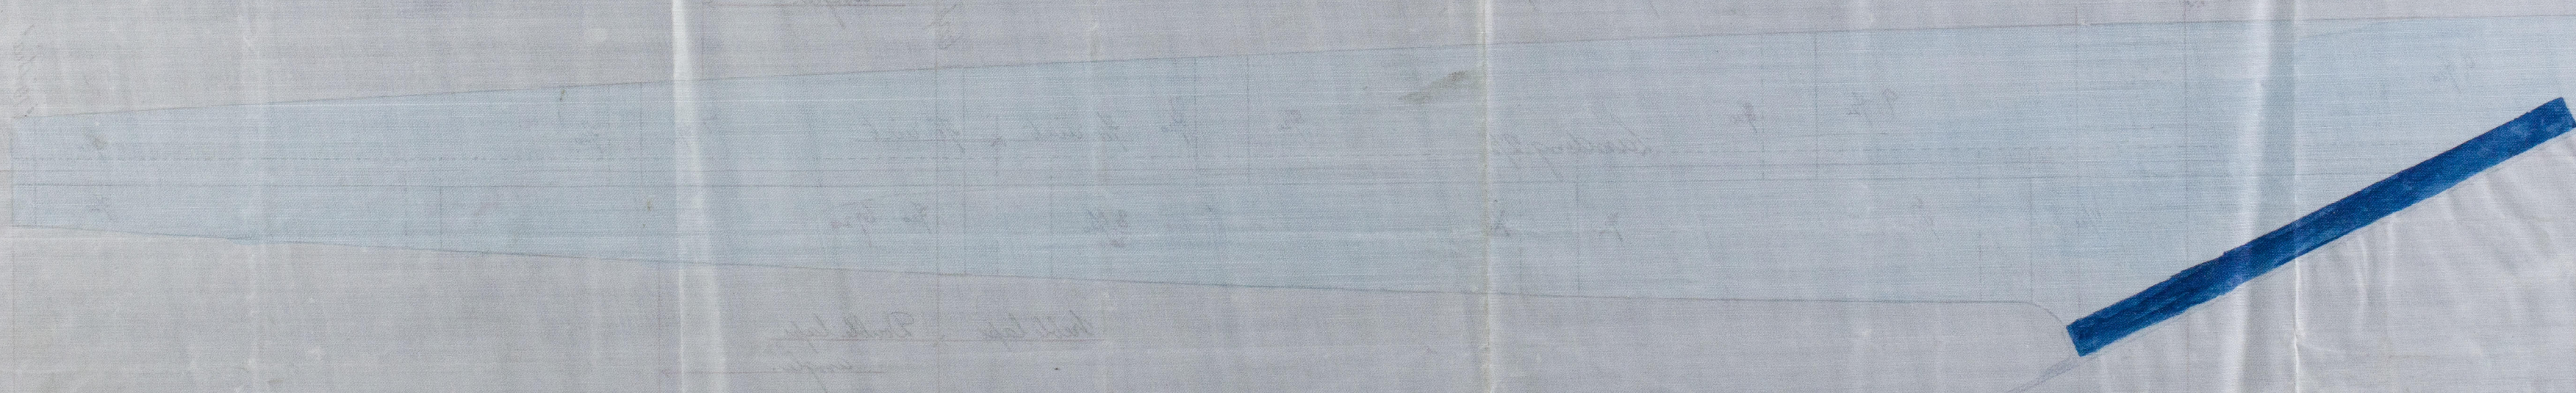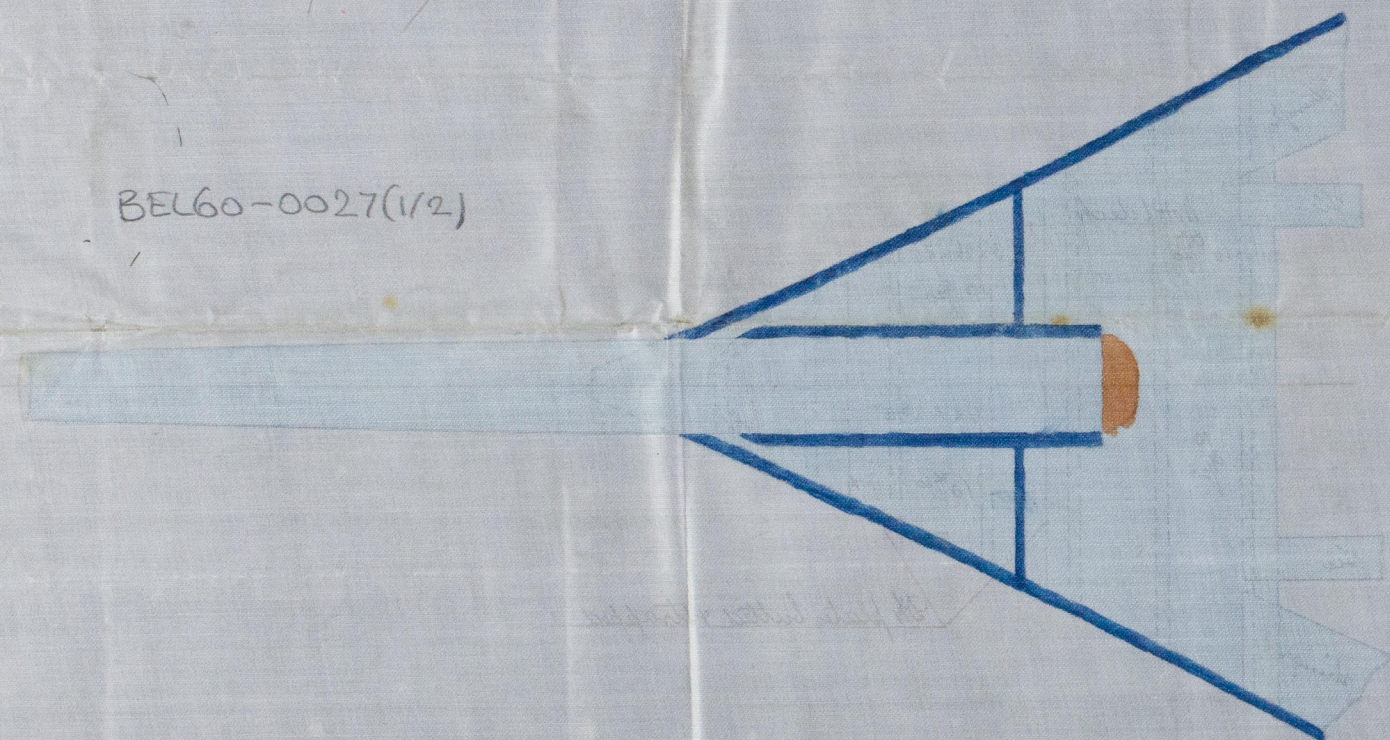

17-01-91



BEL60-0027(212)

For Enclosure to

Messrs. *Lloyd's Surveysors*