



Sections in way of Bowsprit N° 89 Sailing Ship.

Scale $\frac{1}{4}$ inch = one foot.


12.12.91.

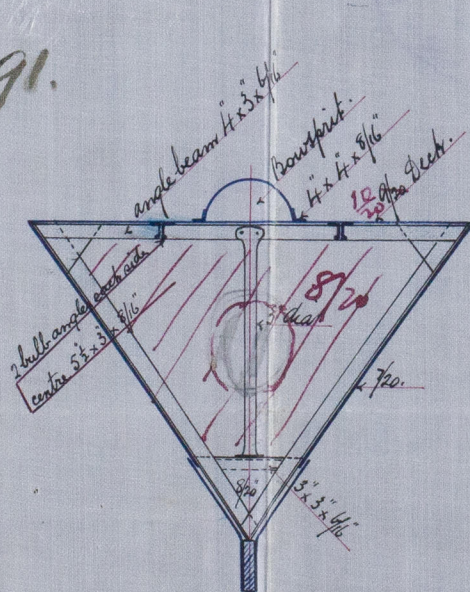

Steel of Bowsprit.

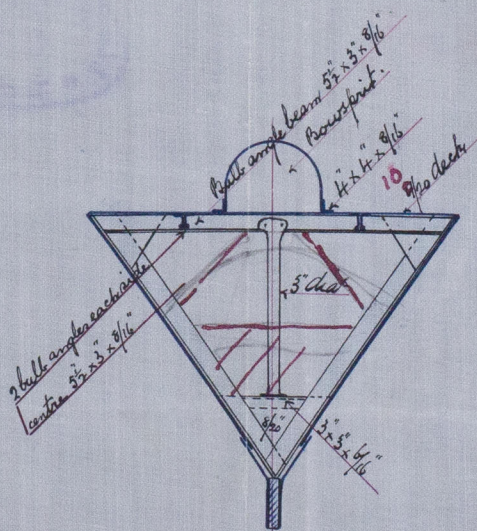

1st frame forward of heel.

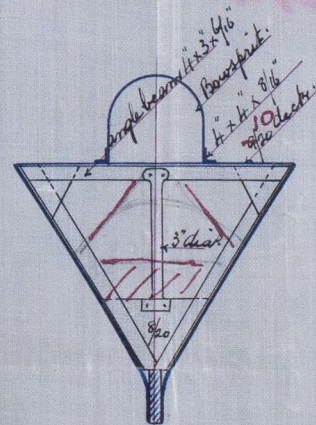

2nd frame forward of heel.



Lloyd's Register
Foundation




BEL60-0028(1/2)

BEL60-0028(1/2)

89

First Entry Rpt Bel.

No. 4058

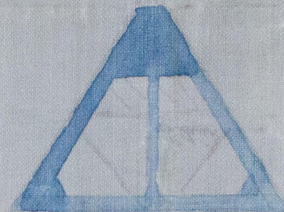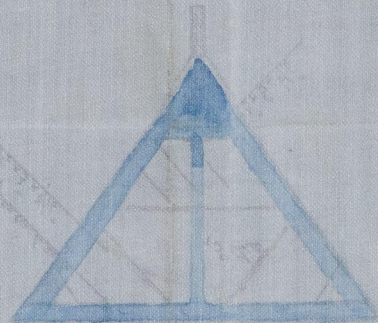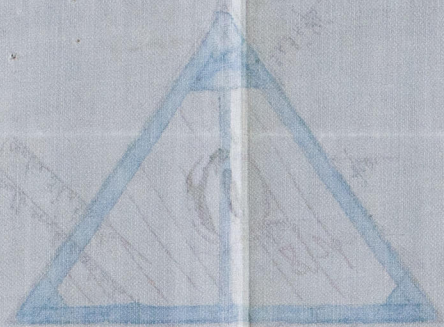

© 2021

Lloyd's Register
Foundation

BEL60-0028C2121

For Enclosure to

Messrs.

Lloyd's Surveyors