


# — CAST STEEL RUDDER —

— FOR S.S. 249 —

— SCALE  $\frac{1}{2}$ " = ONE FOOT —


For Messrs. Harland & Wolff.  
Belfast.

FITTED STEEL BOLTS.

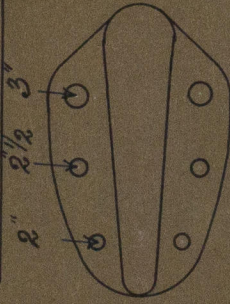

PLAN OF COUPLING.


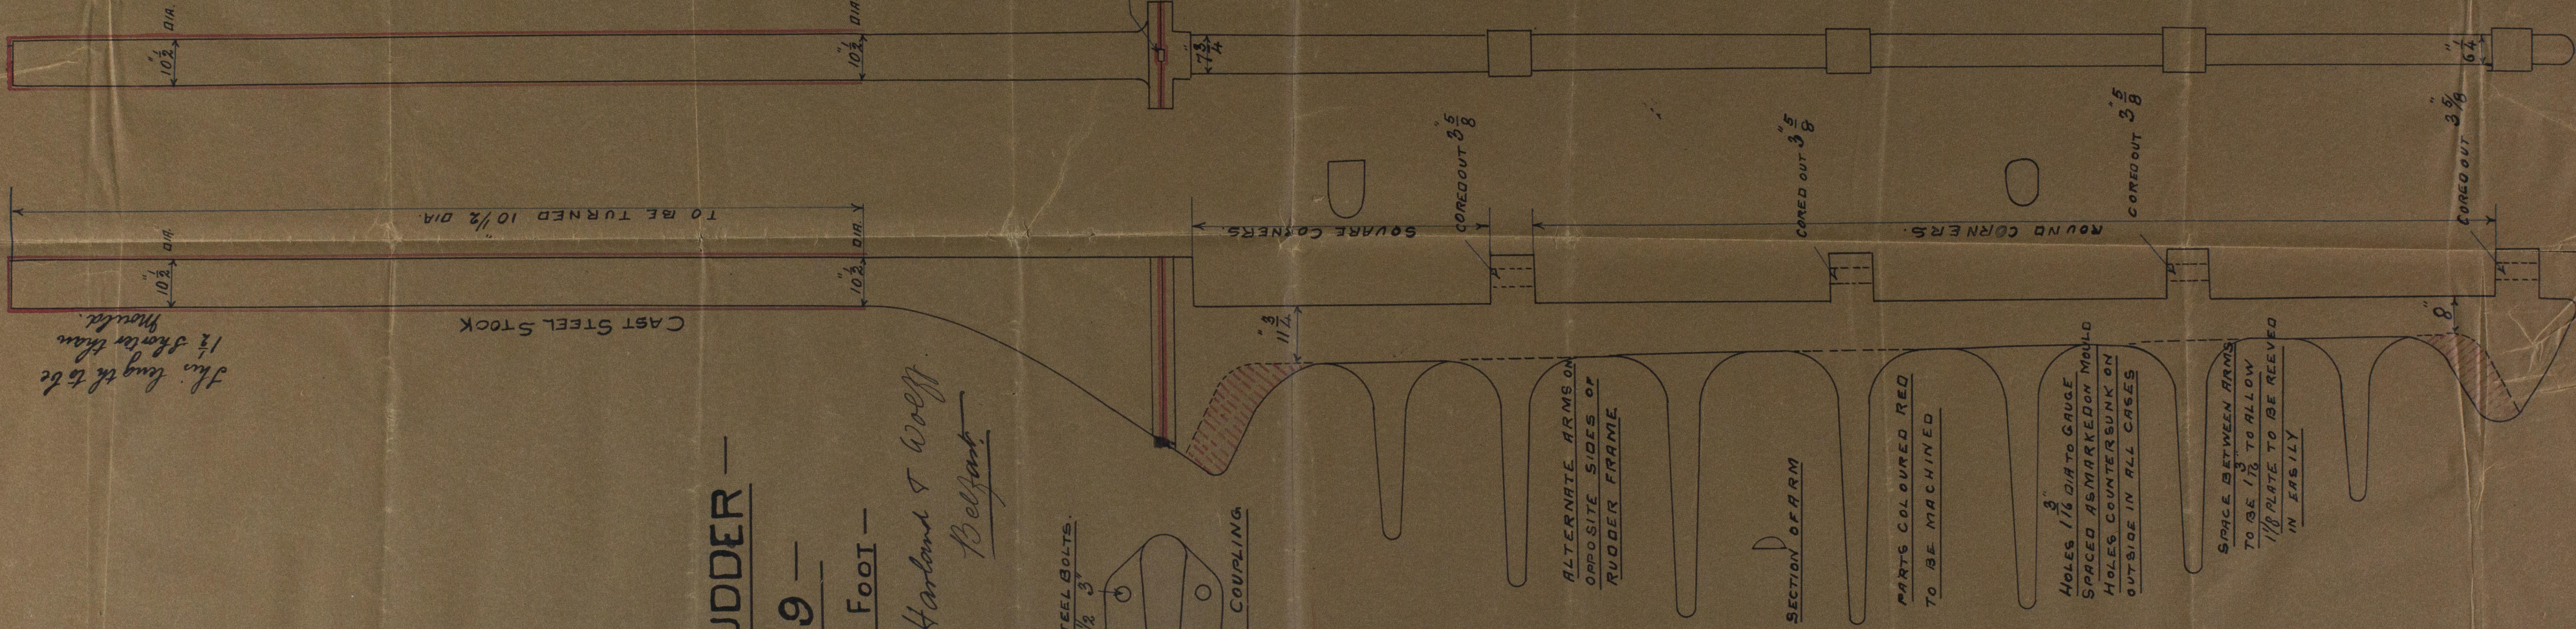

NOTE WORK TO Mould IN PREFERENCE TO TRACING



© 2019

Lloyd's Register Foundation

