






249

Mohawk

1800-09138

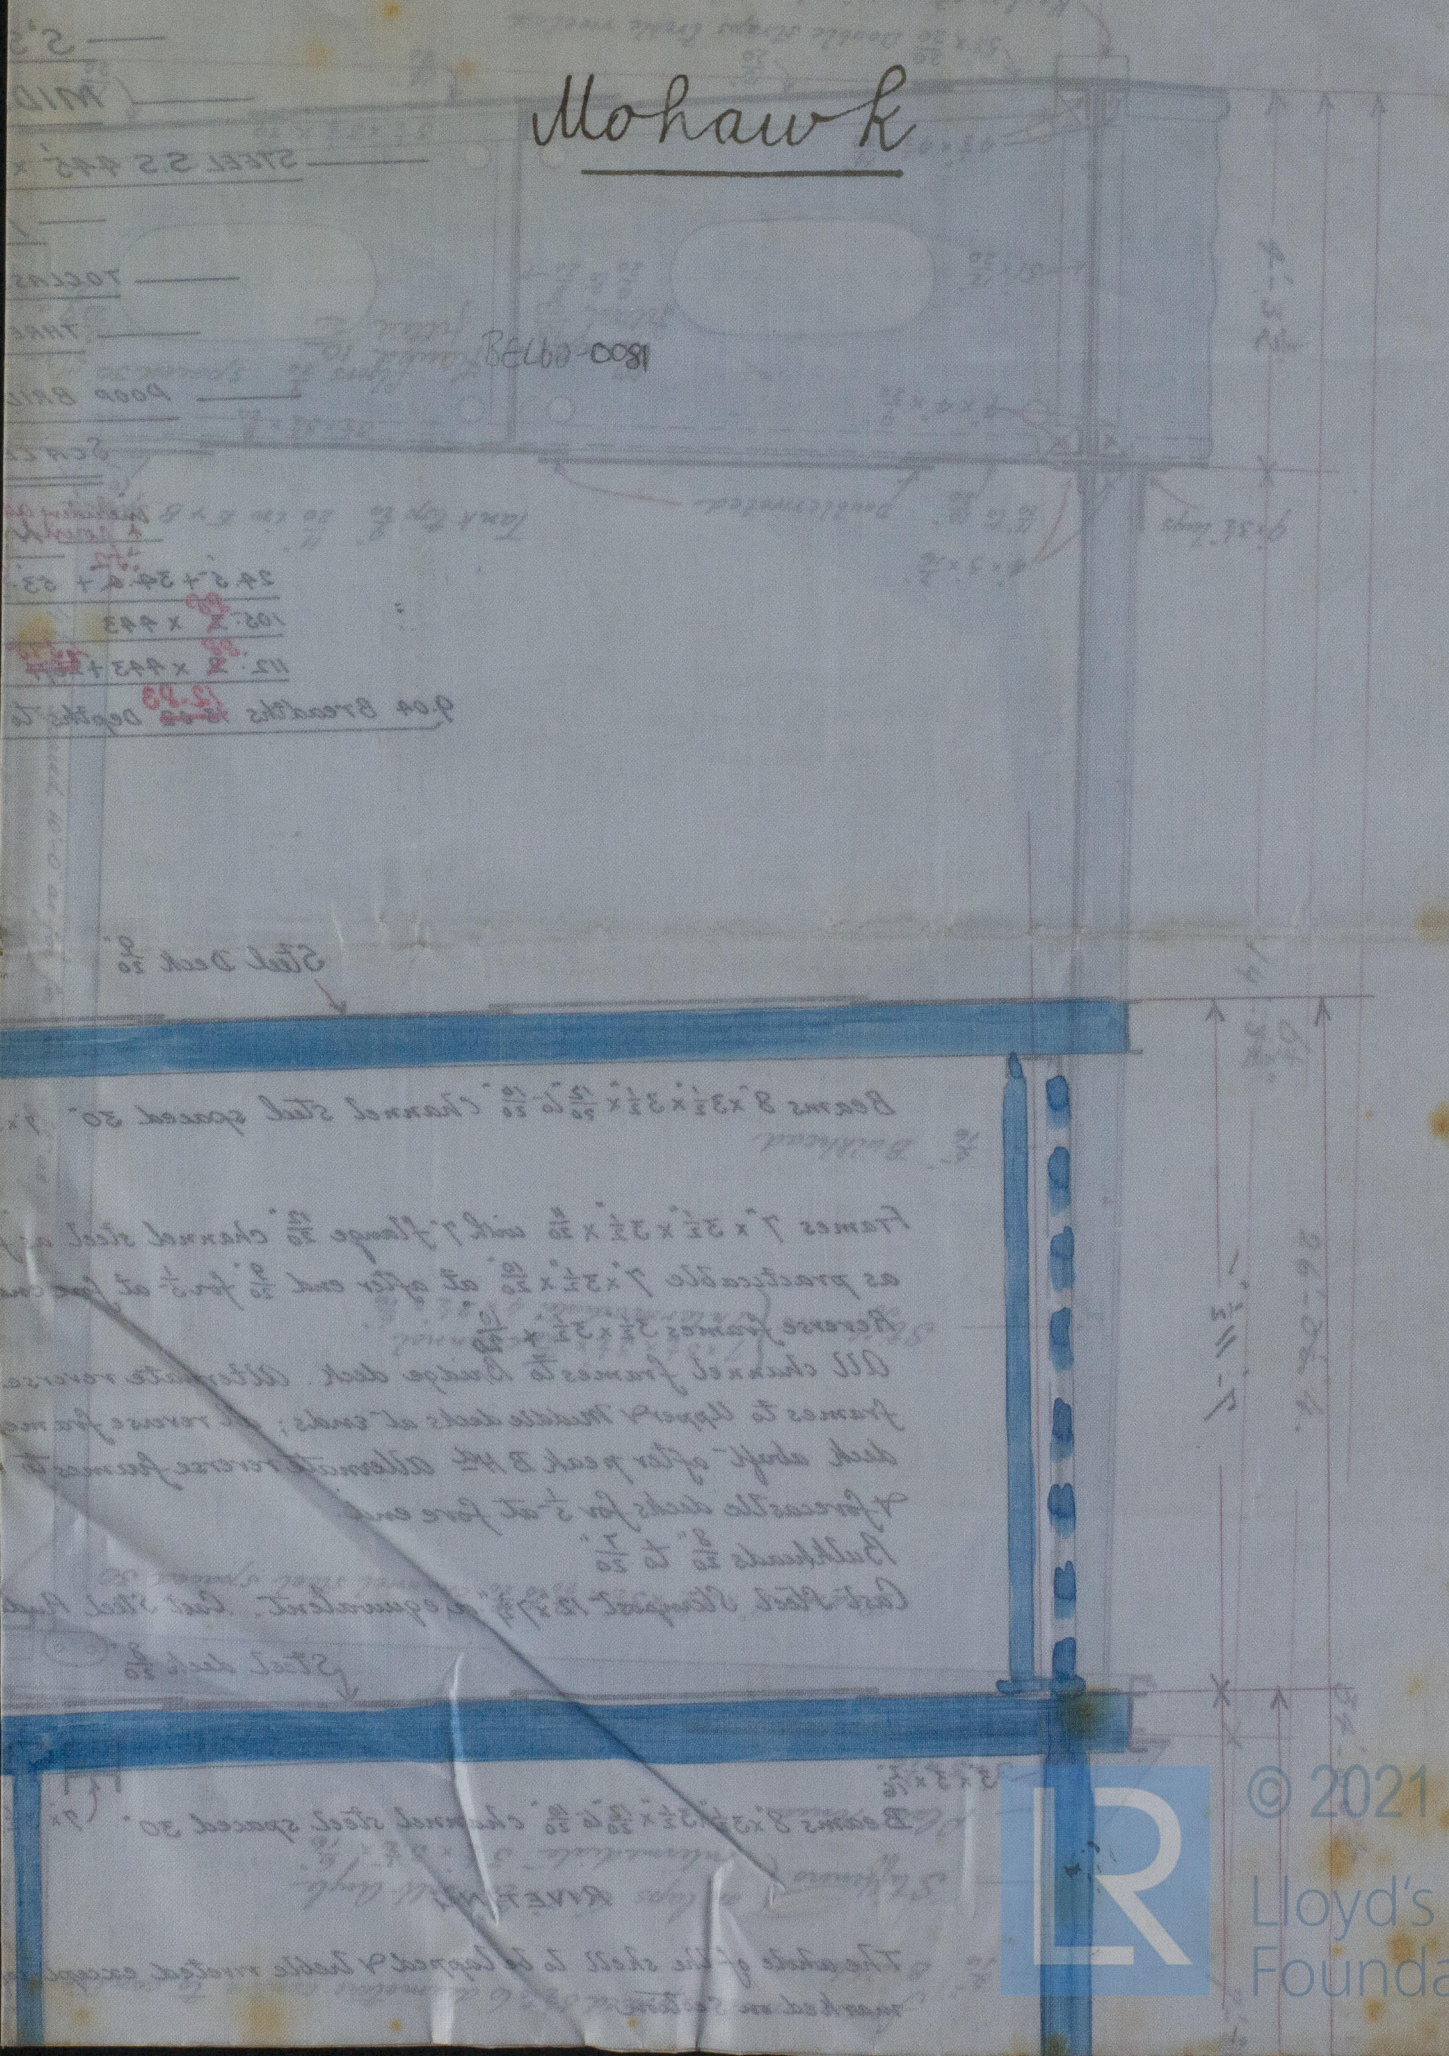

© 2021

Lloyd's Register  
Foundation



