



90  
Crown of Germany

BelRpt 5002

BEL60-01032

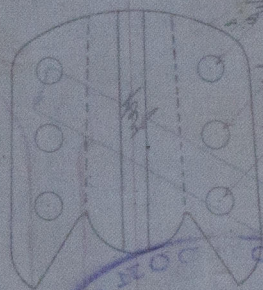

STANDARD

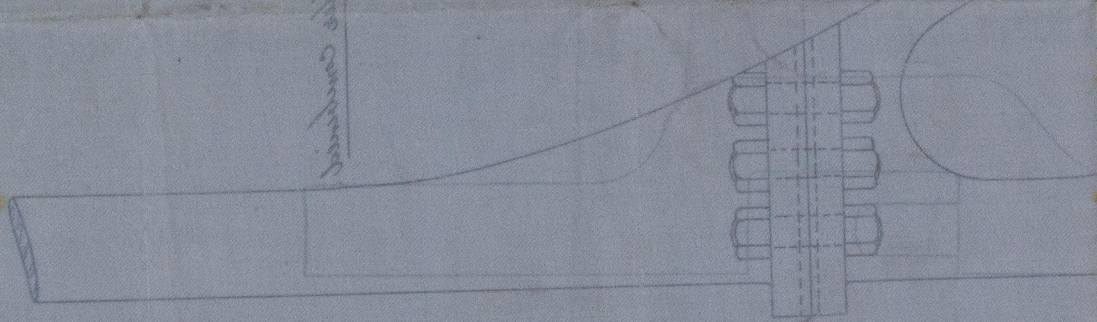

26/12/92




© 2019

Lloyd's Register  
Foundation



7.3.92

 Scale 1 inch = 1 foot.

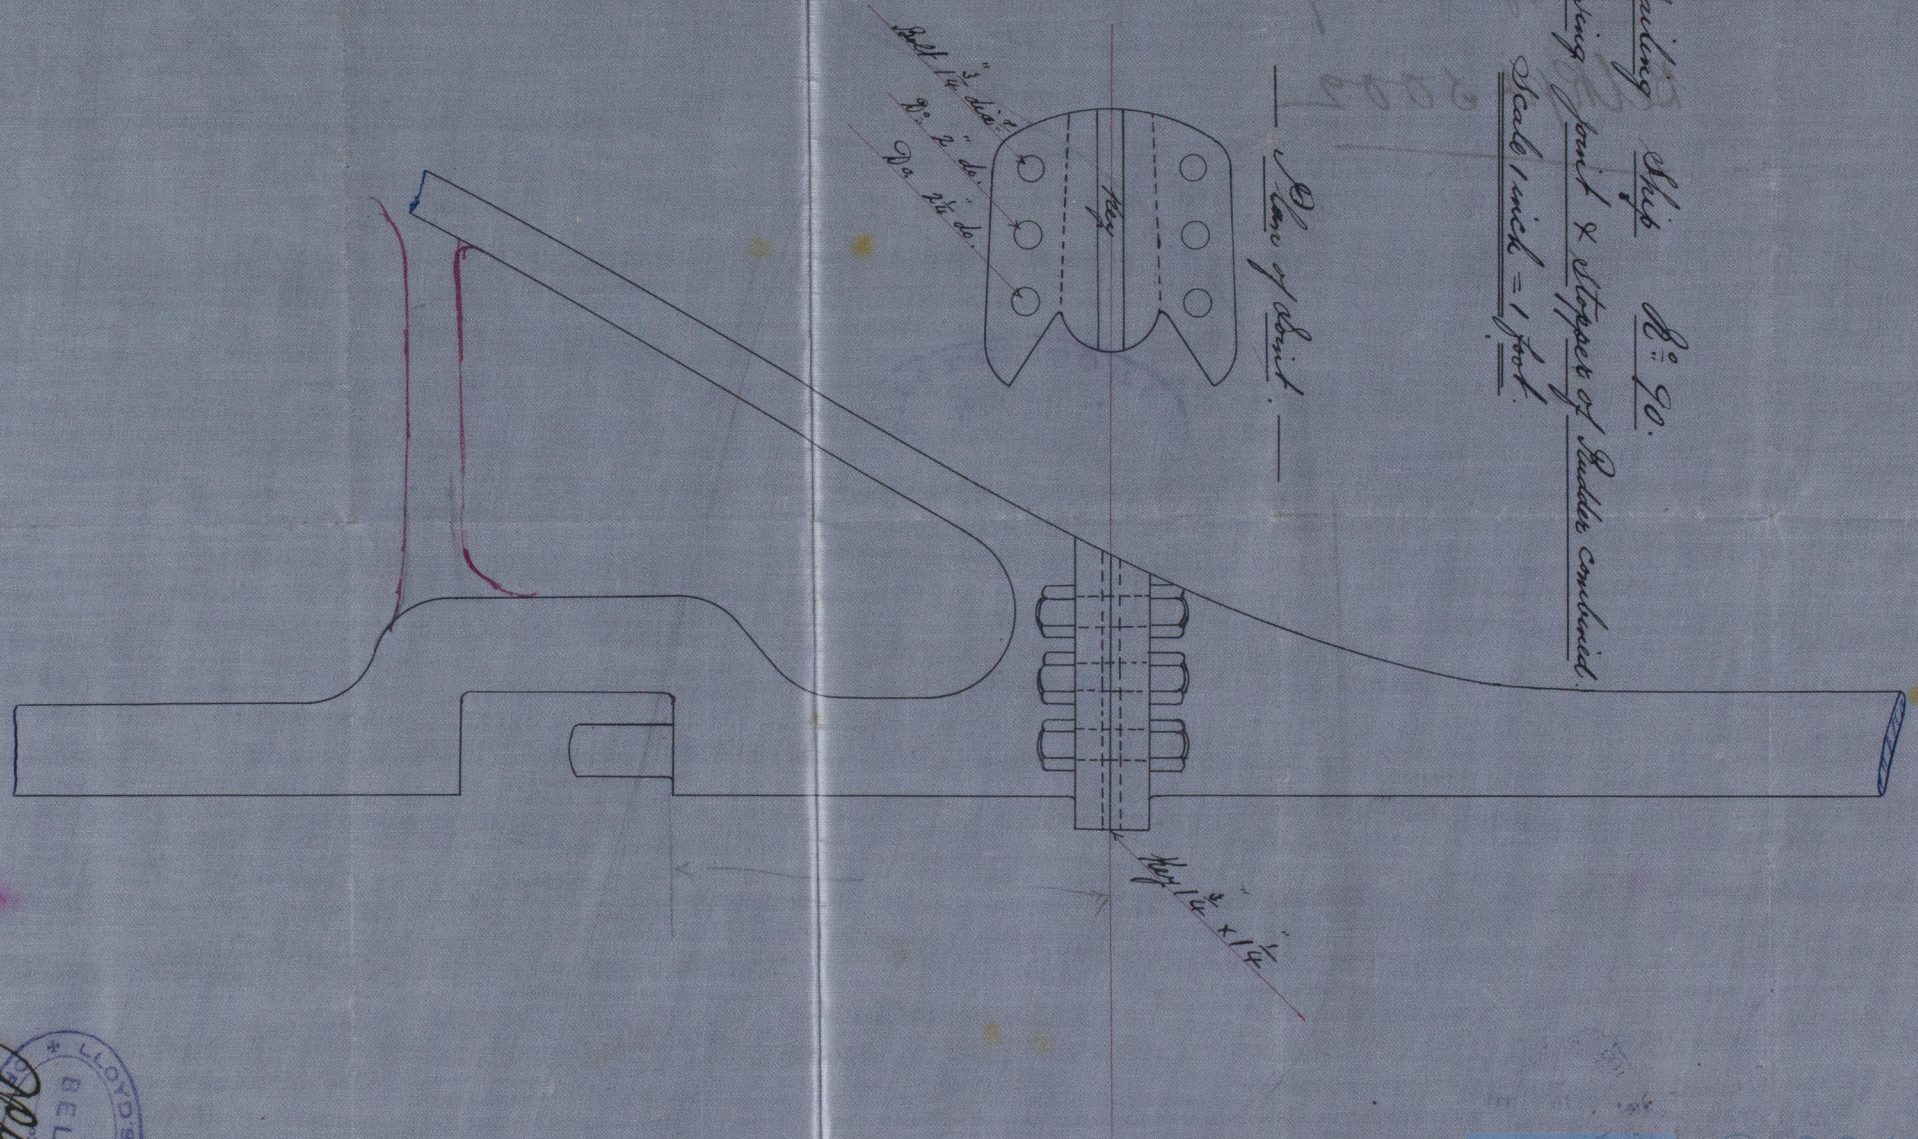

WORKMAN, CLARK & CO. LIMITED  
 SHIPBUILDERS & ENGINEERS  
 BELFAST  
 3-MAR-92

LLOYD'S REGISTER  
 BELFAST  
 9/3/92



© 2019  
 Lloyd's Register  
 Foundation

BL60-0103