

Received at Belfast Office, 11th June 1892

Lloyd's Register of British and Foreign Shipping.

(Report on Vessel No. _____ Port _____)

No. 3548 SHIP FORGINGS ~~OR CASTINGS.~~

The words FORGINGS or CASTINGS, IRON or STEEL, should be struck out as may be required.

I have to report that the undermentioned Iron ~~or Steel~~ Forgings ~~or Castings~~, manufactured by The Portland Forge Coy of Kilmarnock for the Vessel No. 93, being built by Messrs Workman Clark & Co of Belfast have been inspected by me as set forth below, and found to be, so far as can be seen, Sound & efficient

Mark on Forgings.


Lloyd's
No. 3548
H. H.




William Hamilton
Glasgow
9/6/92

	STERN FRAME.	RUDDER FRAME.	STEM.
Material*	/	Scrap iron	/
How made		Forged	
Dimensions		1/2 to 3/4	
Progress on Inspection		Forging & smithing	
Dates when Inspected		1.6.8.21/4/92 2.6.10.16 19.23/6/92 2.4.7.9/6/92	

SKETCHES OF FRAMES SHEWING POSITION AND DESCRIPTION OF WELDS OF FORGINGS, OR PARTICULARS OF TESTS APPLIED TO CASTINGS.

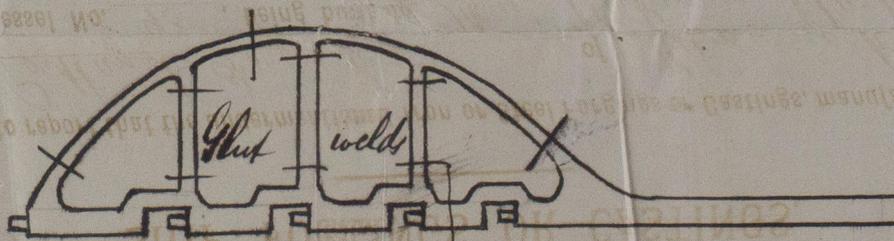

Scarf weld

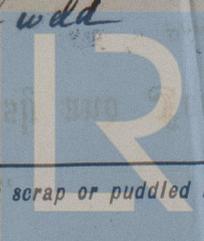

© 2019
Lloyd's Register
Foundation

* If of Iron, state whether scrap or puddled Iron.

93

"Jorgings on

Rudder frame

11th June 1892

"Goodrich"

"First Entry Pkt.

Bel. No. 4-124



AWA



© 2019

Lloyd's Register
Foundation