



— Steel Yards N^o 93 Sailing Barque.
— Scale $\frac{1}{2}$ = one foot —

Goodrich
just sent
Del. Nov 12


Fore, Main, & Wizen. Lower Yards.

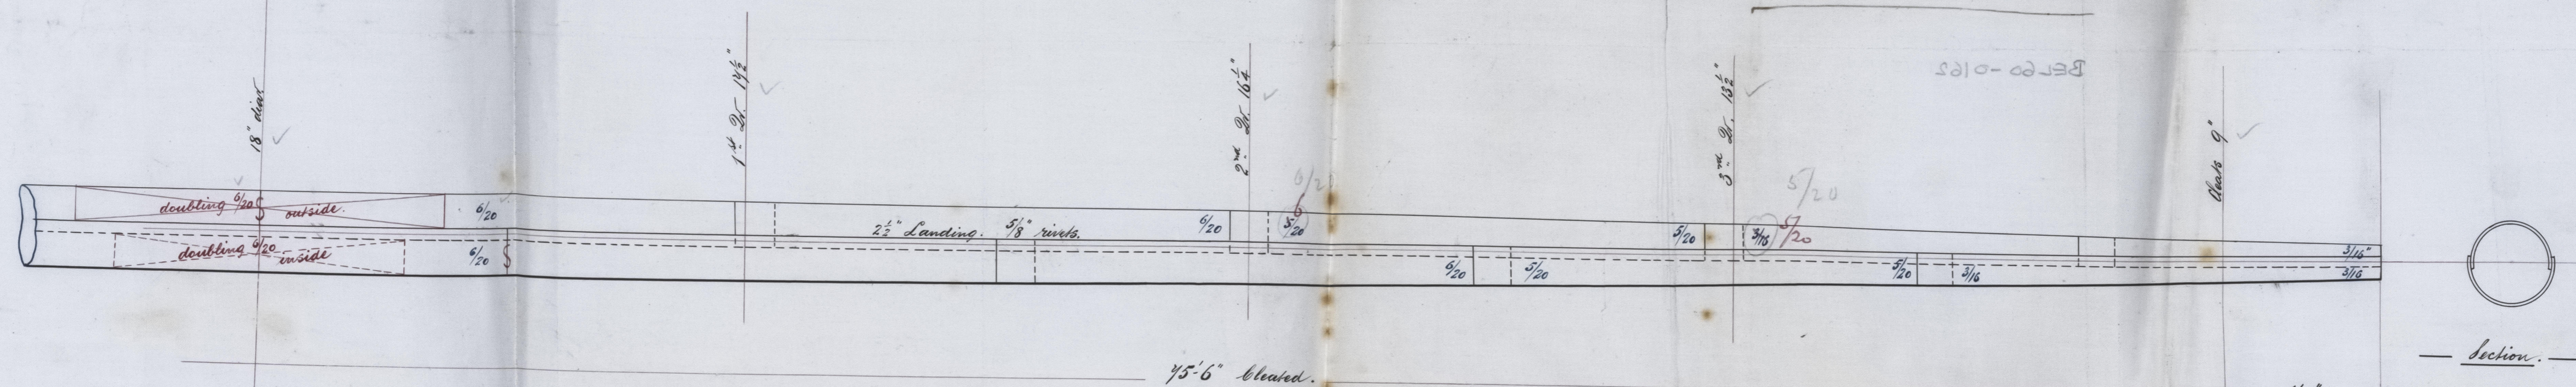


Fore, Main, & Mizzen Lower Topsail Yards.

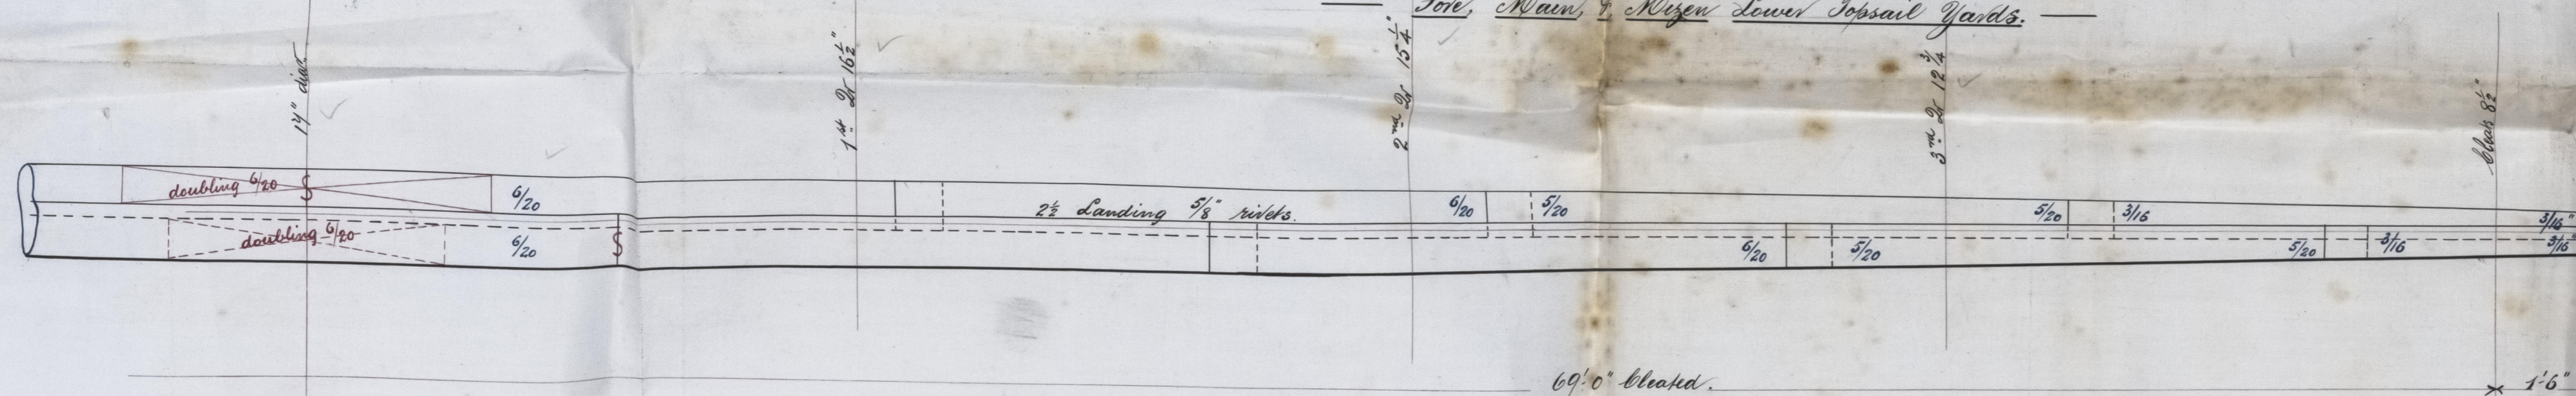

Upper Topsail Yards.

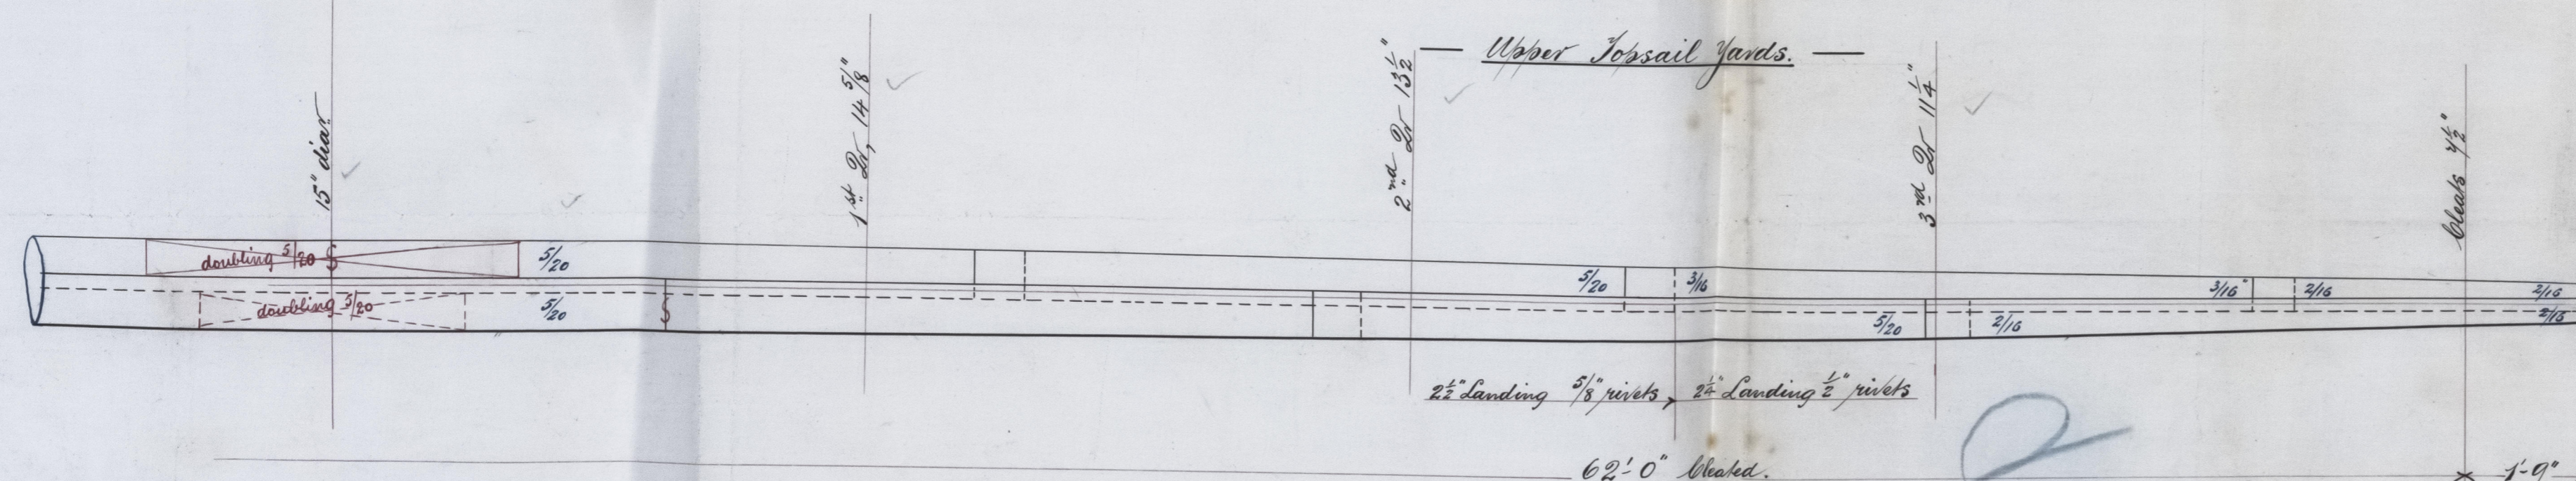


— All Laps and Butts Tieble. —

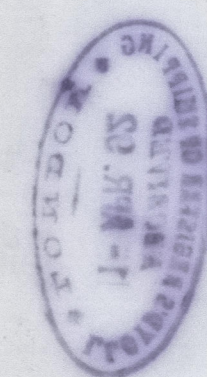


Goodrich
your truly
J. W. Foster


— Fore, Main, & Wizen. Lower Yards. —

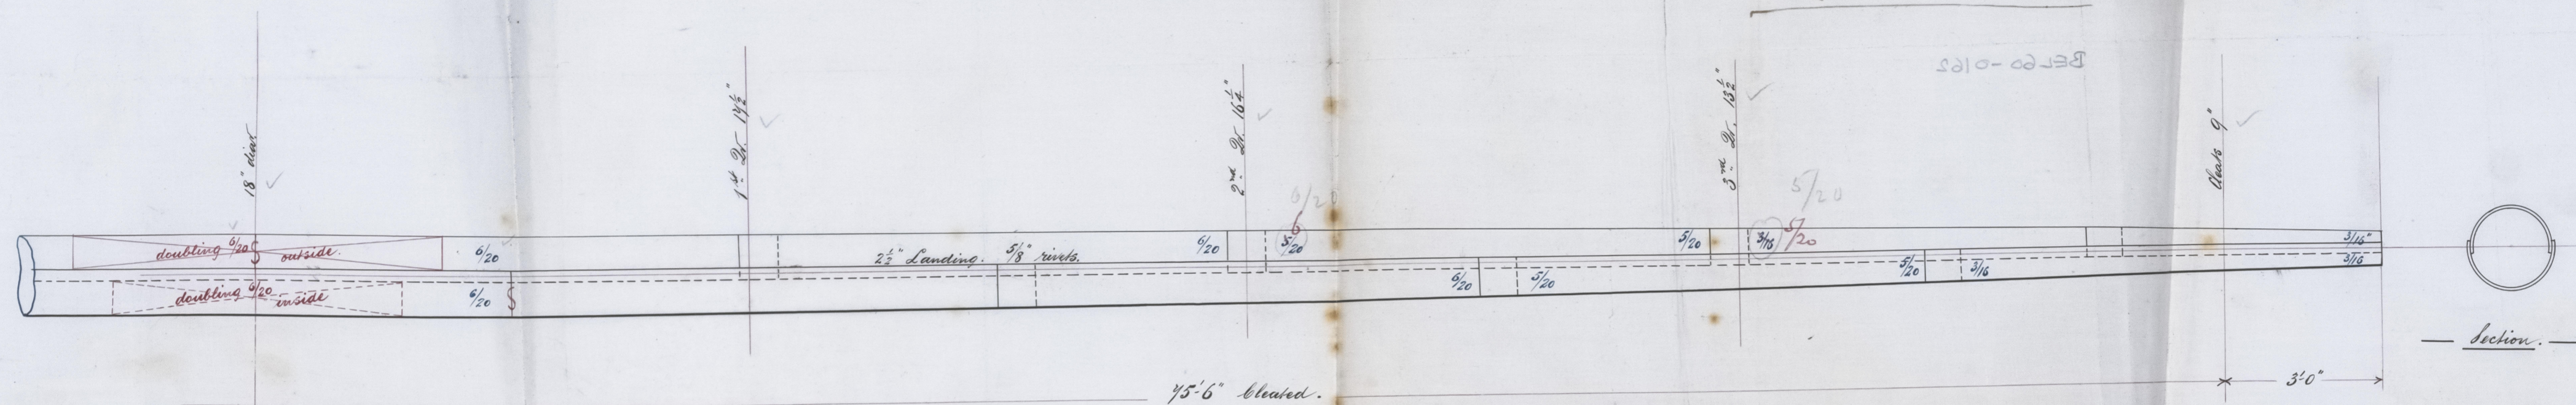


Fore, Main, & Mizzen Lower Topsail Yards.

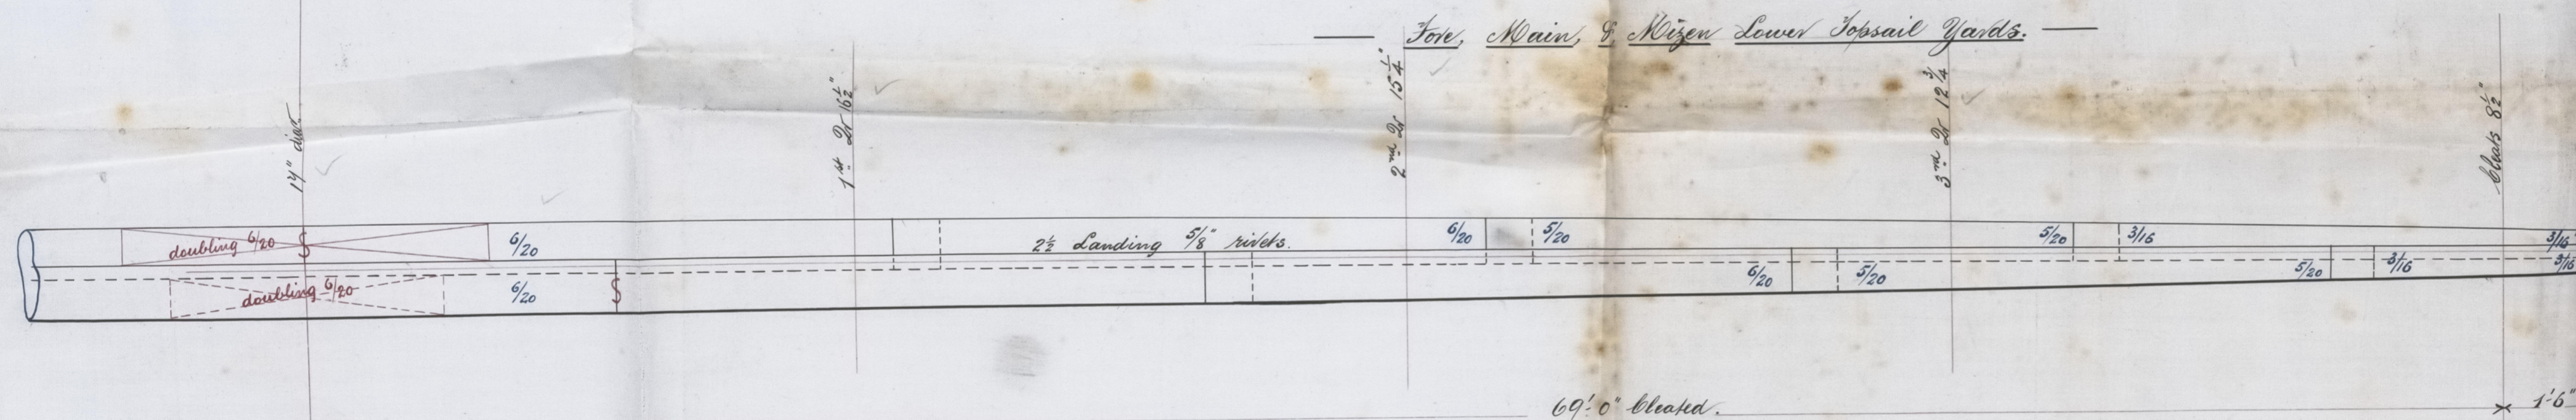

Upper Topsail Yards.

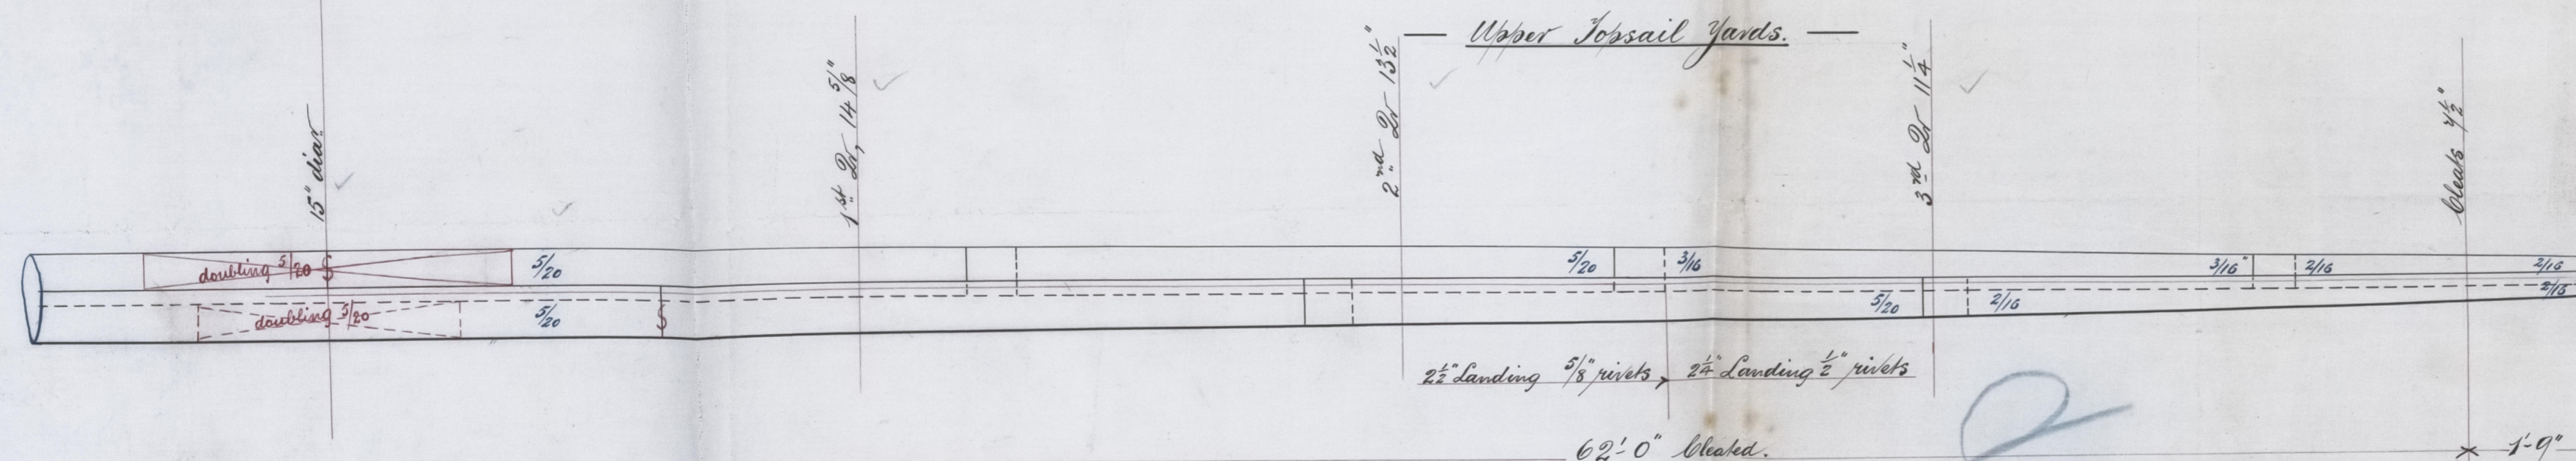

— All Laps and Butts Tieble. —

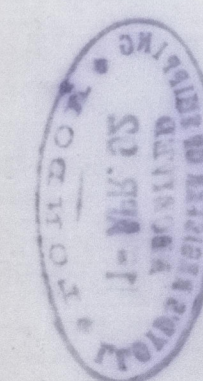

Goodrich

First Entry

Bel. No 4124

Belgo-0162

Sheet Goodrich Bel. No 4124

For Goodrich Bel. No 4124



© 2021

Lloyd's Register
Foundation