


Apr. 27. 9. 92

 

S.S. No 256  
PUMPING ARRANGEMENT  
SCALE 1/4" = 1 FOOT

arranged  
pump  
to  
be  
used  
in  
case  
of  
emergency


M.A.  
26.9.92

13/10/92  
24.9.92


13/10/92



Sagamore  
256  
 Bel. First Entry  
 Report No. 4192  
 Pump arrangt.

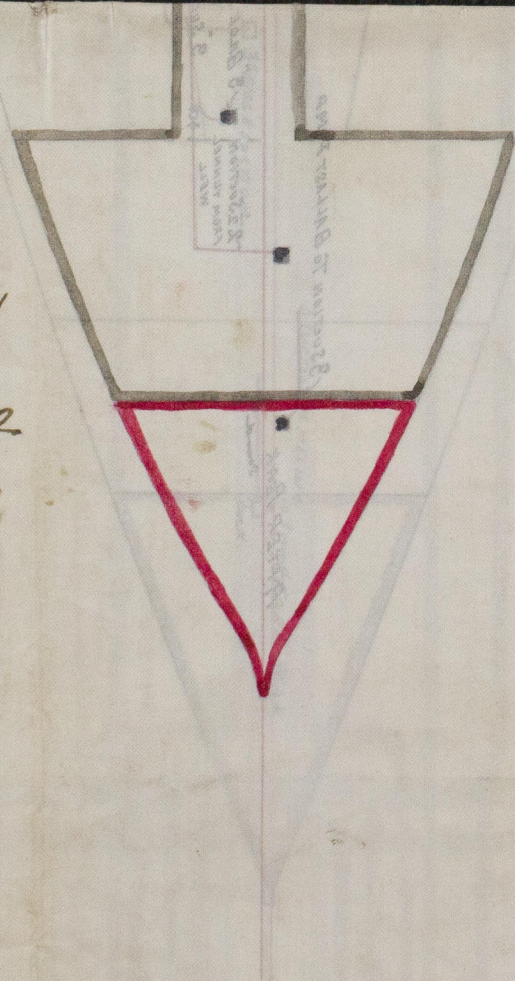

S.S. No 256 —  
 PUMPING ARRANGEMENT —  
 Scale 1/4 in = 1 ft

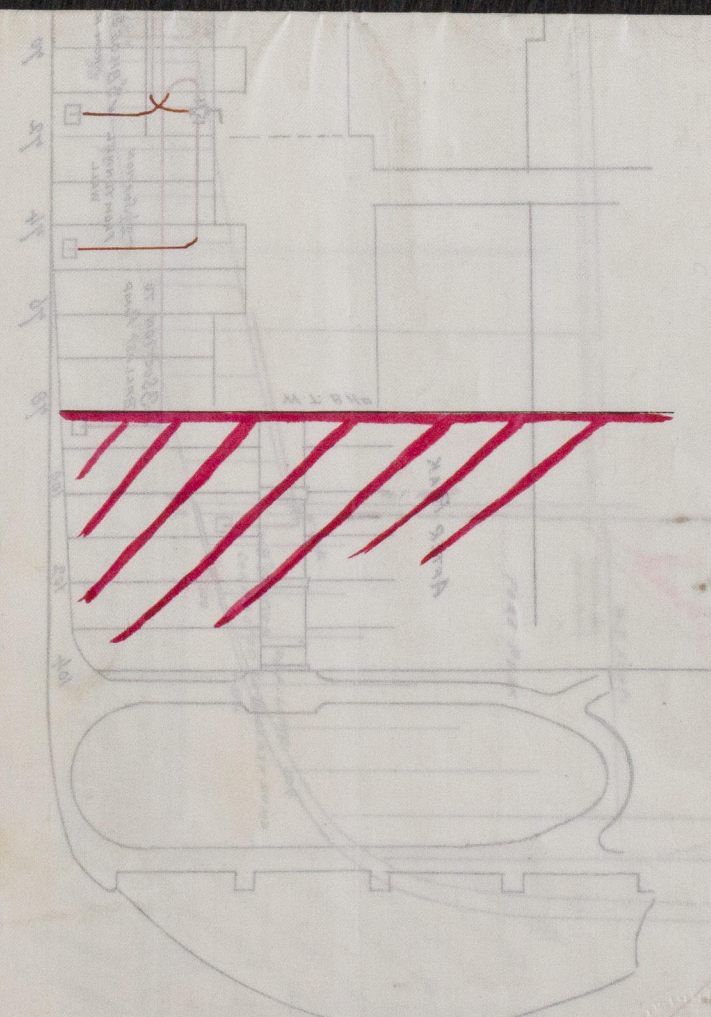

© 2020  
 Lloyd's Register  
 Foundation

PL 61-0021

BR 61-0021