


Chr. 27.9.92

 

— N° 257 —
PUMPING ARRANGEMENT
Scale 1/8" = One Foot

Bilge suction, bilge injection and separate suction to the donkey pump be fitted as required by the rules

3 bilge suction & main donkey pump
1 separate bilge suction to donkey
2 bilge injections

A = Bilge suction to main & donkey pump
B = Bilge injection
C = Separate bilge suction to donkey pump

All 1 1/2 inch lines omitted with Owners consent

M.A.
26.9.92



A.L.D.
24.9.92

23/9/92

25
Islam

Bel First Entry

Report No 4195

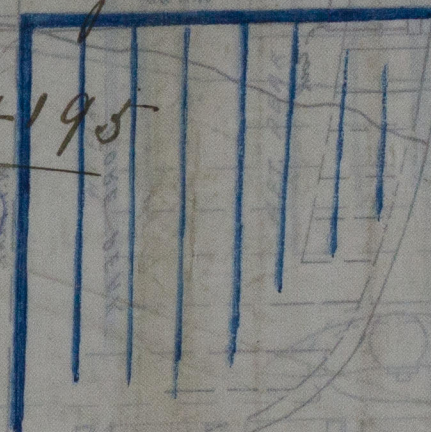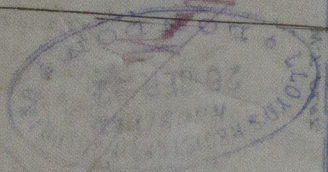

— PUMPING ARRANGEMENT —
— Case 1/2 One Foot —
— No 524 —



© 2020

Lloyd's Register
Foundation

BEL61-0044