


For Enclosure to
Messrs. *Lloyd's Surveyors*

Dr: 17.6.92

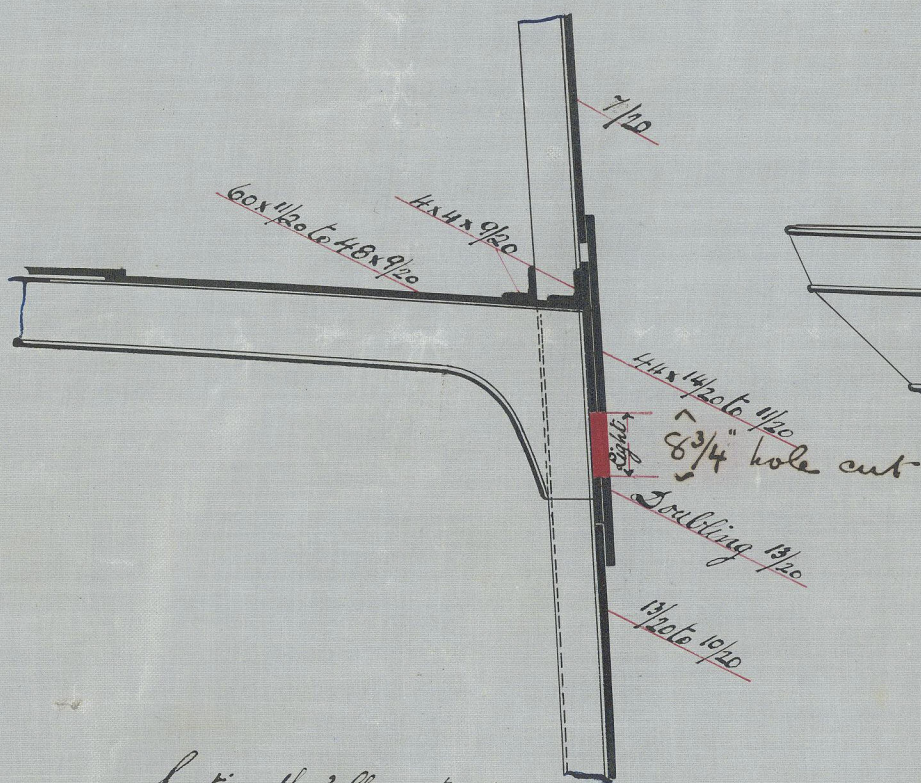

Section thro' Sheer Strake


Scale $1/2$ = one foot



© 2020

Lloyd's Register
Foundation

BEL 61 - 0056

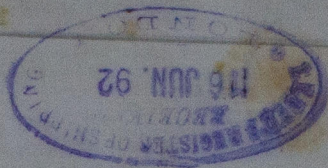

Saul
Bel Fire
No

Directly

16



© 2020

Lloyd's Register
Foundation