

On 16.5.92

— No 91 S.S. —





Sketch showing proposed arrangement for Stepping

Masts on deck



Scale $\frac{1}{4}$ inch = One foot

Fore Mast

Main Mast

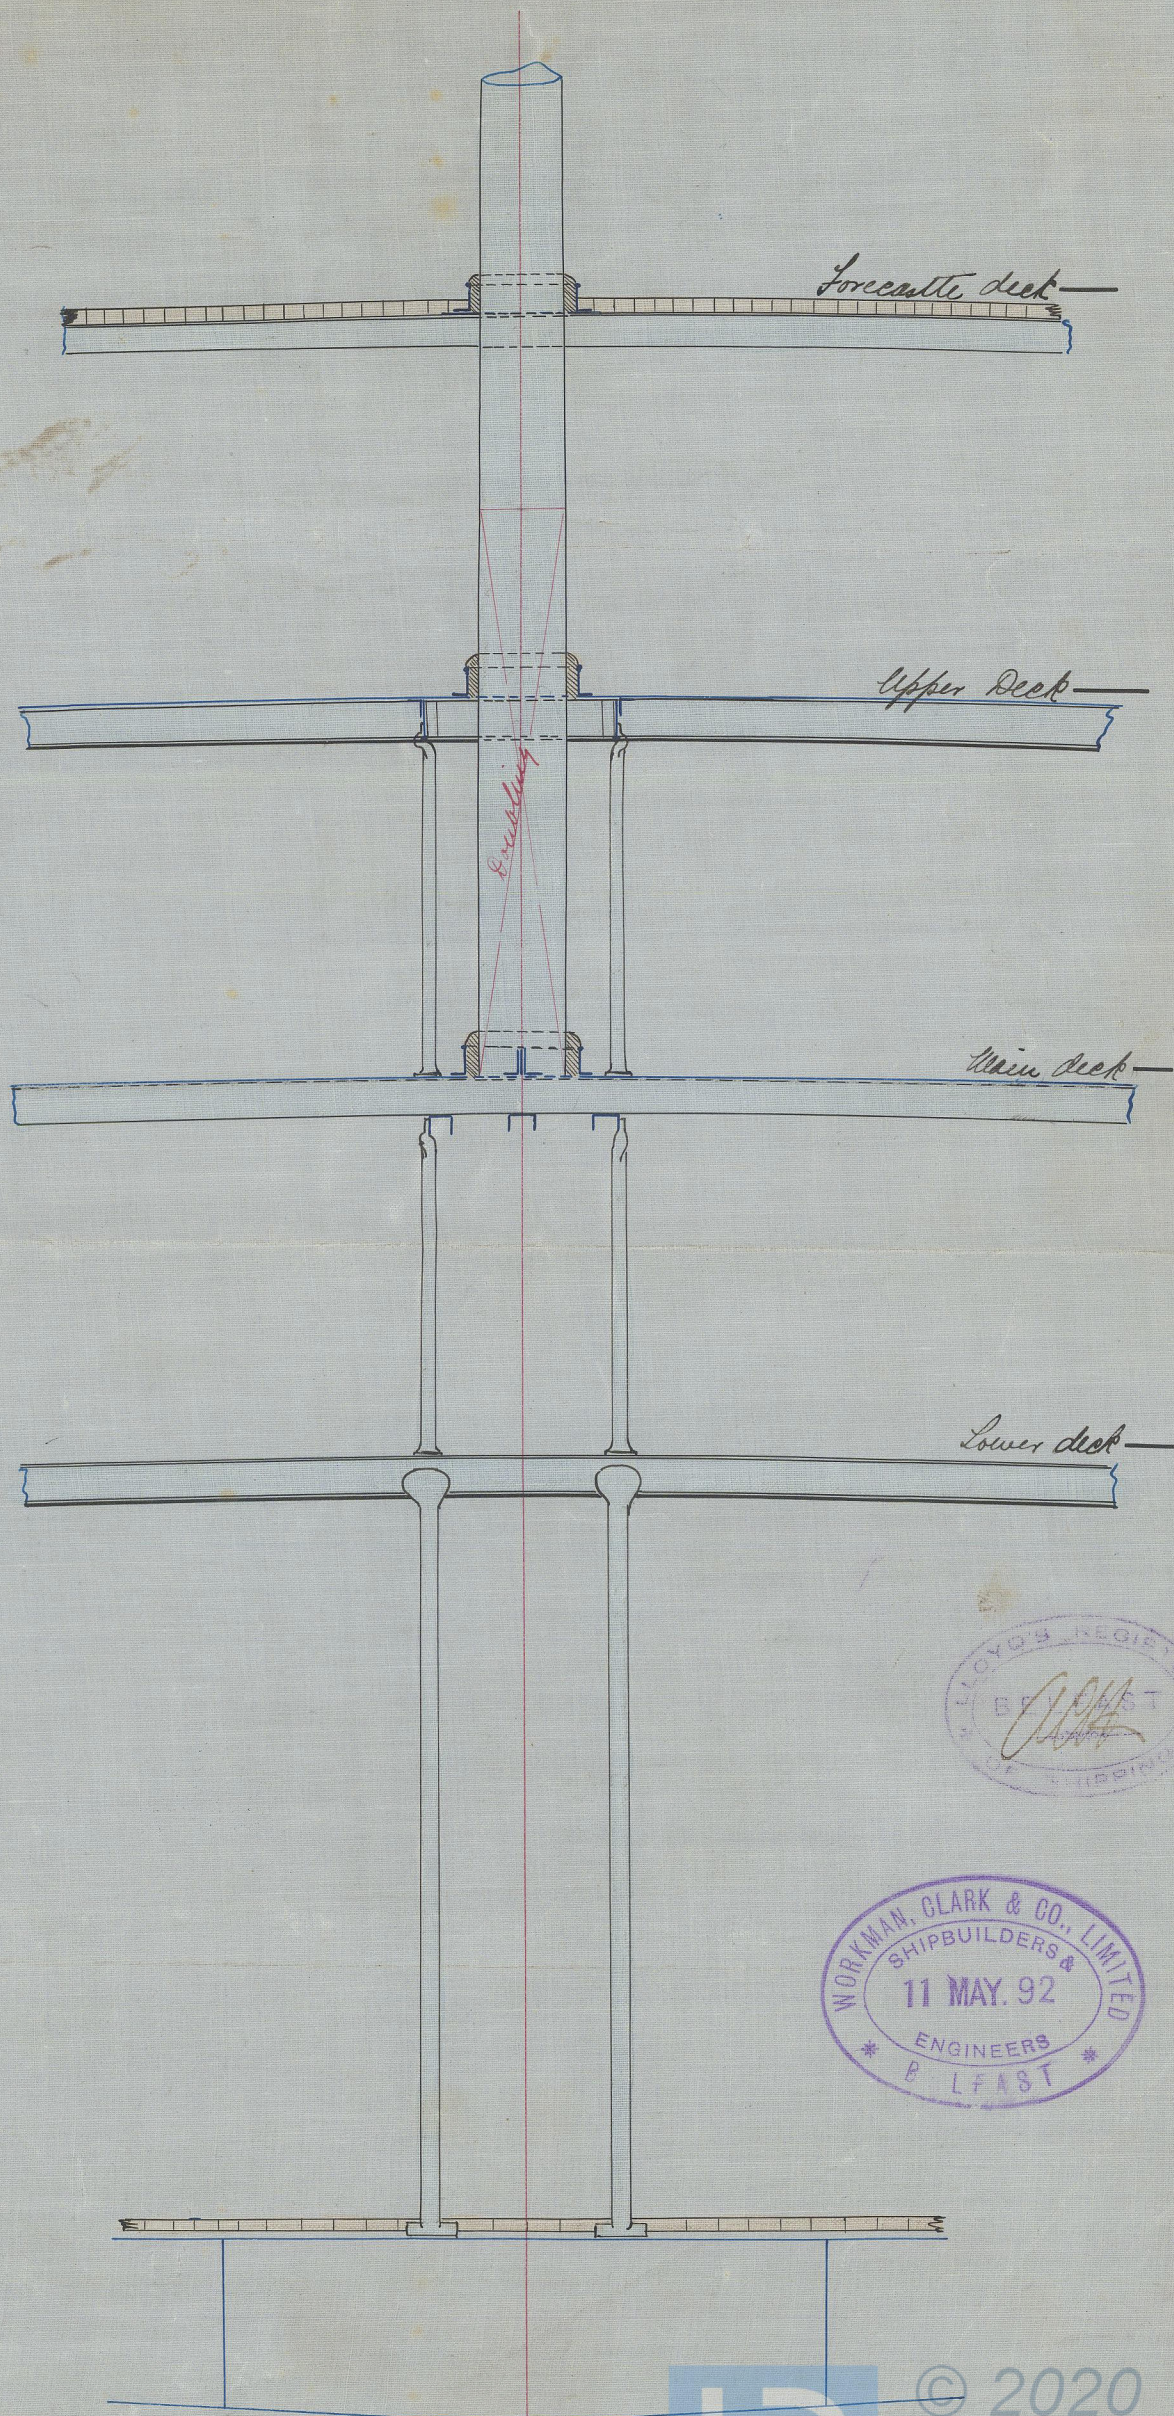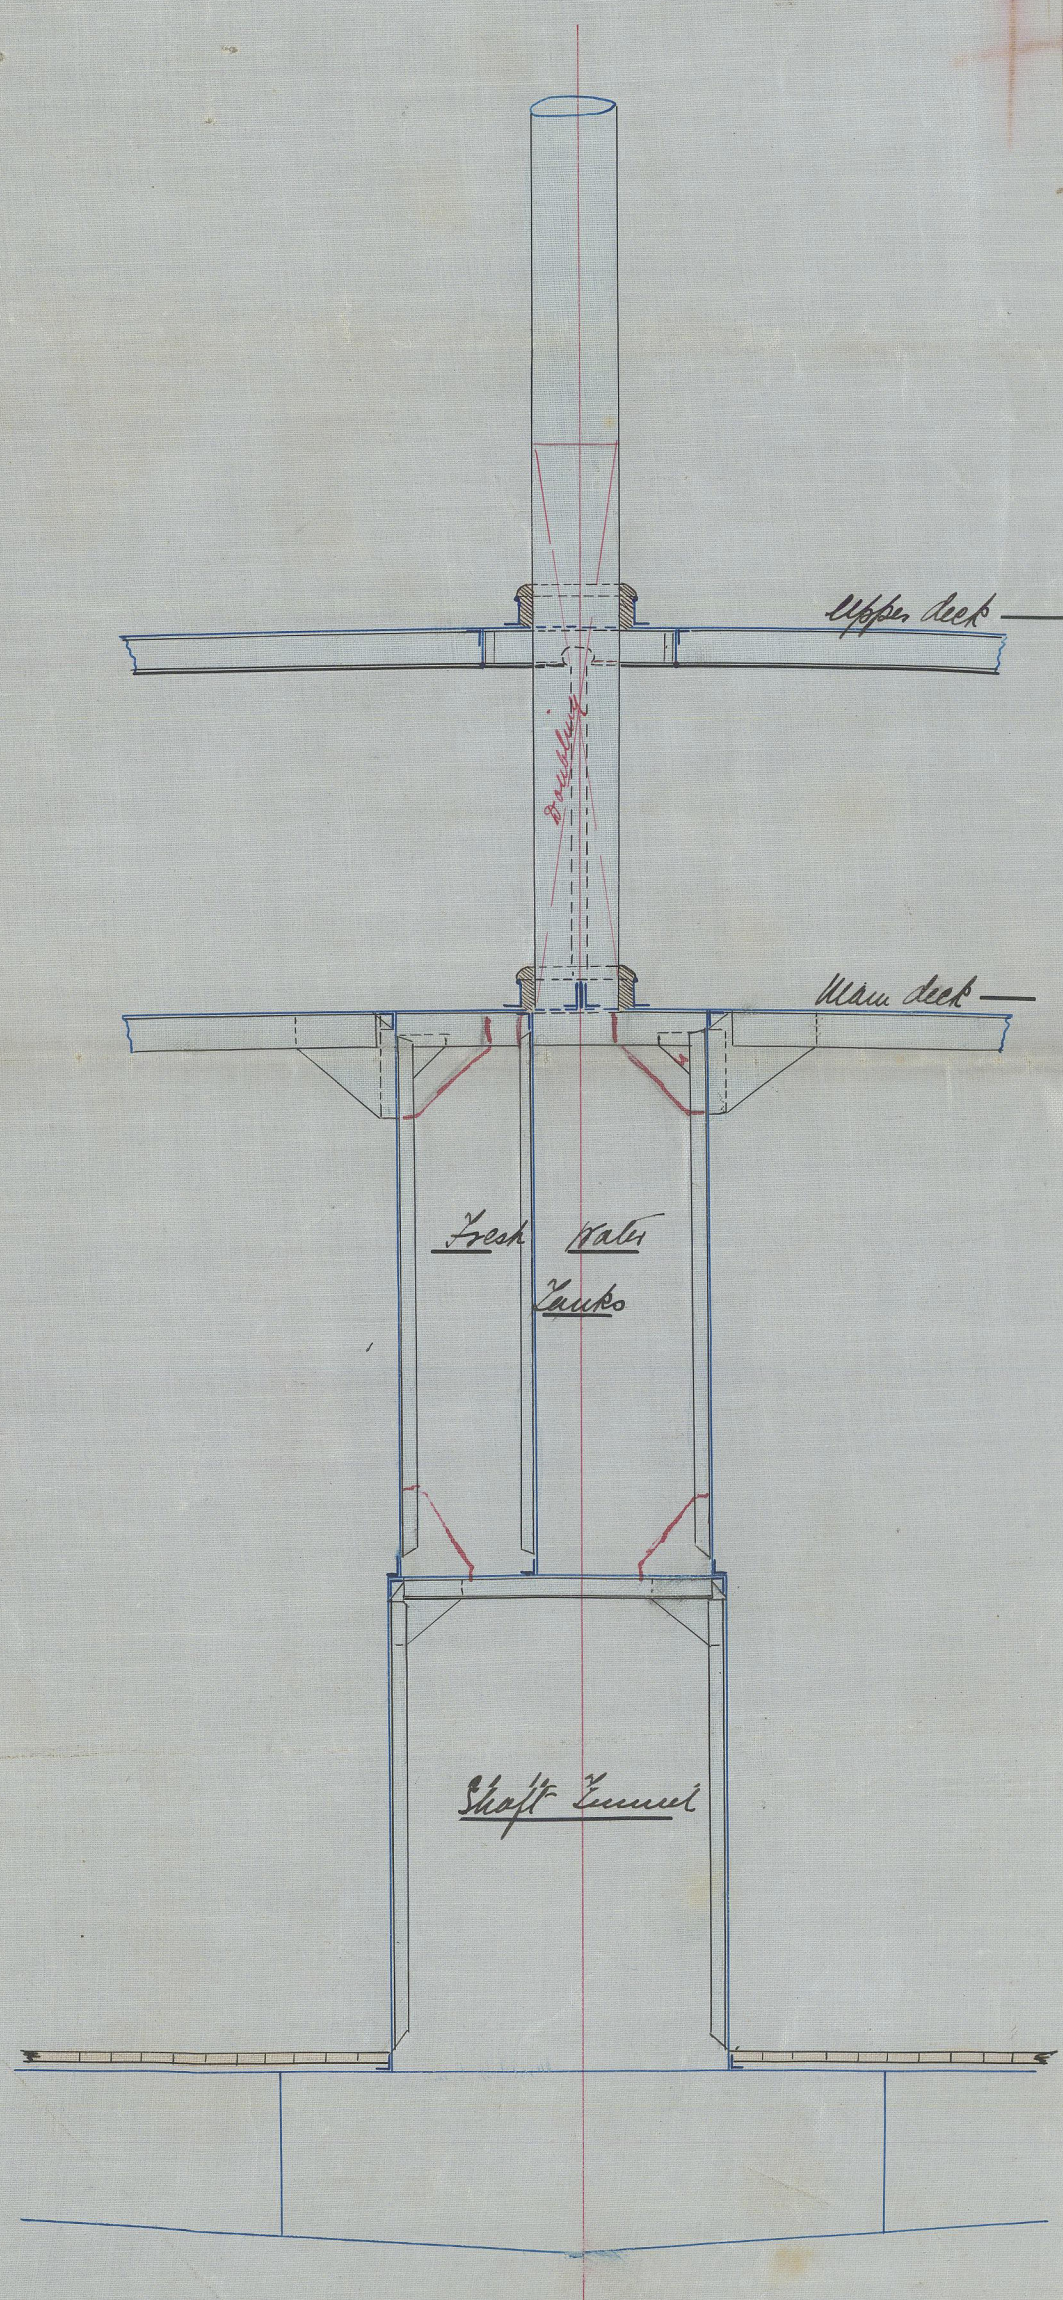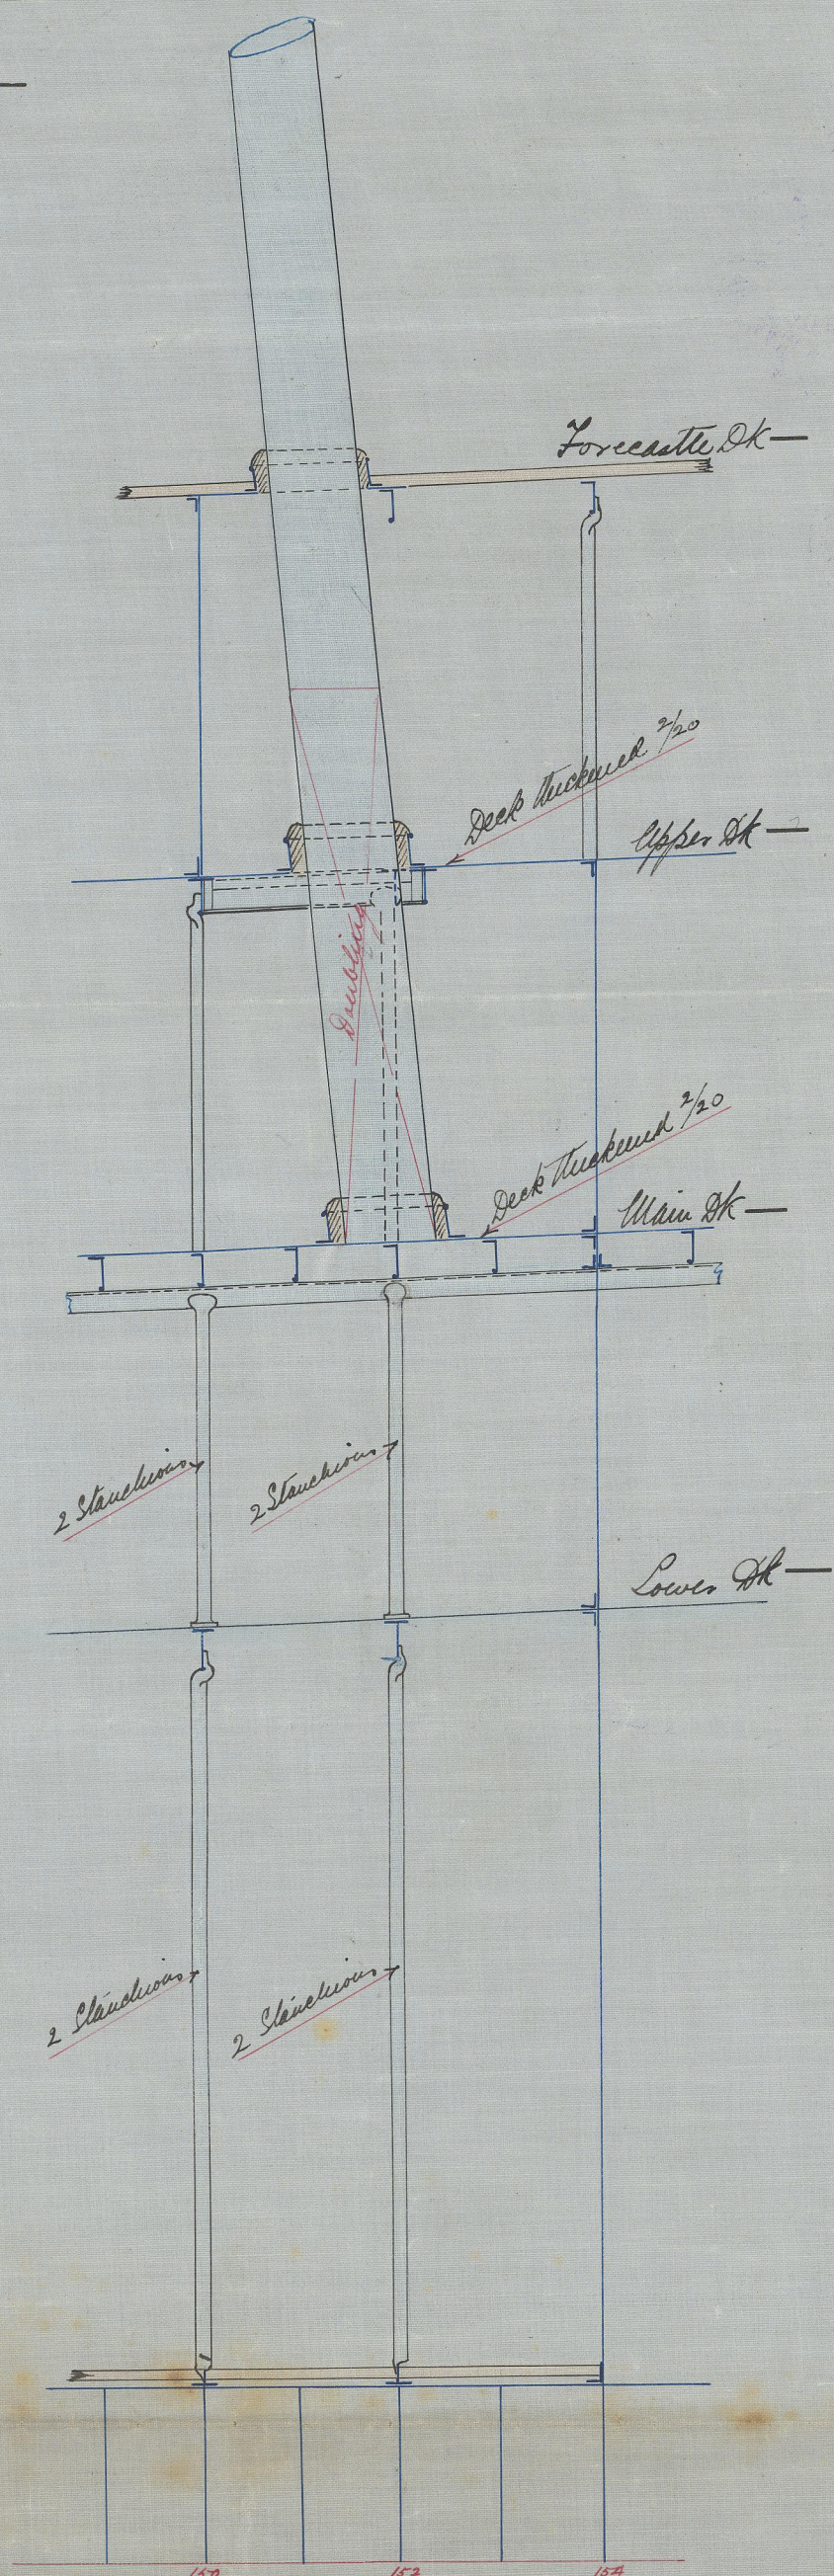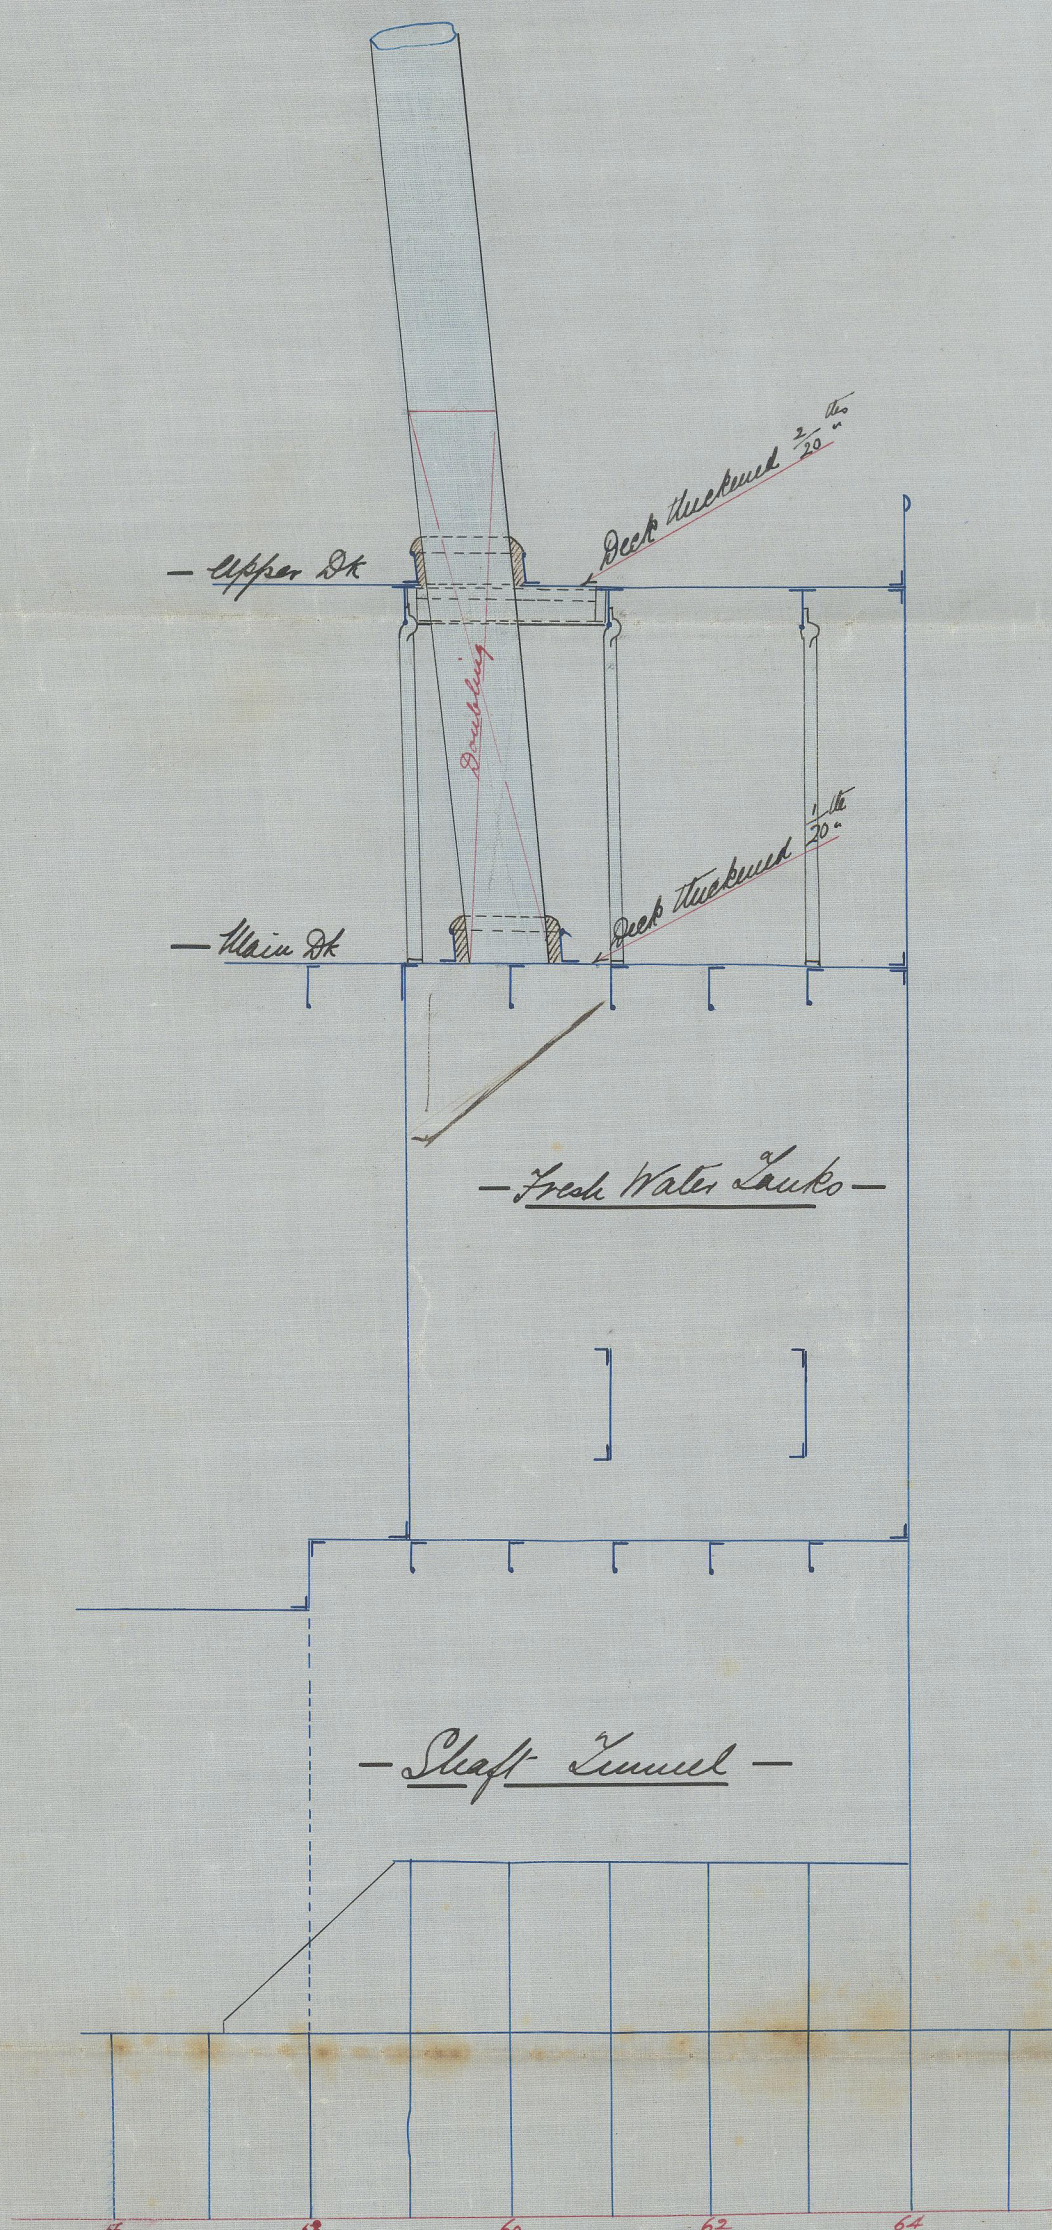


1200 1250
100 102 104

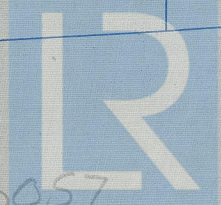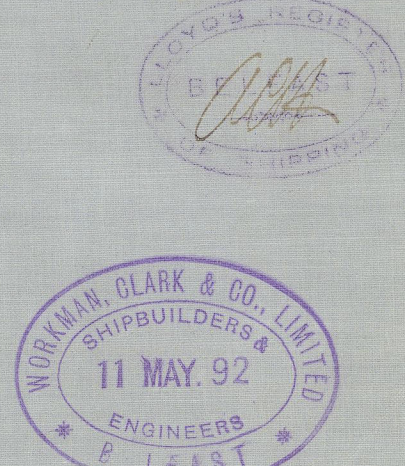

Bel 61-0057

Southern Cross
Bel. First Entry
Rpt No. 4157

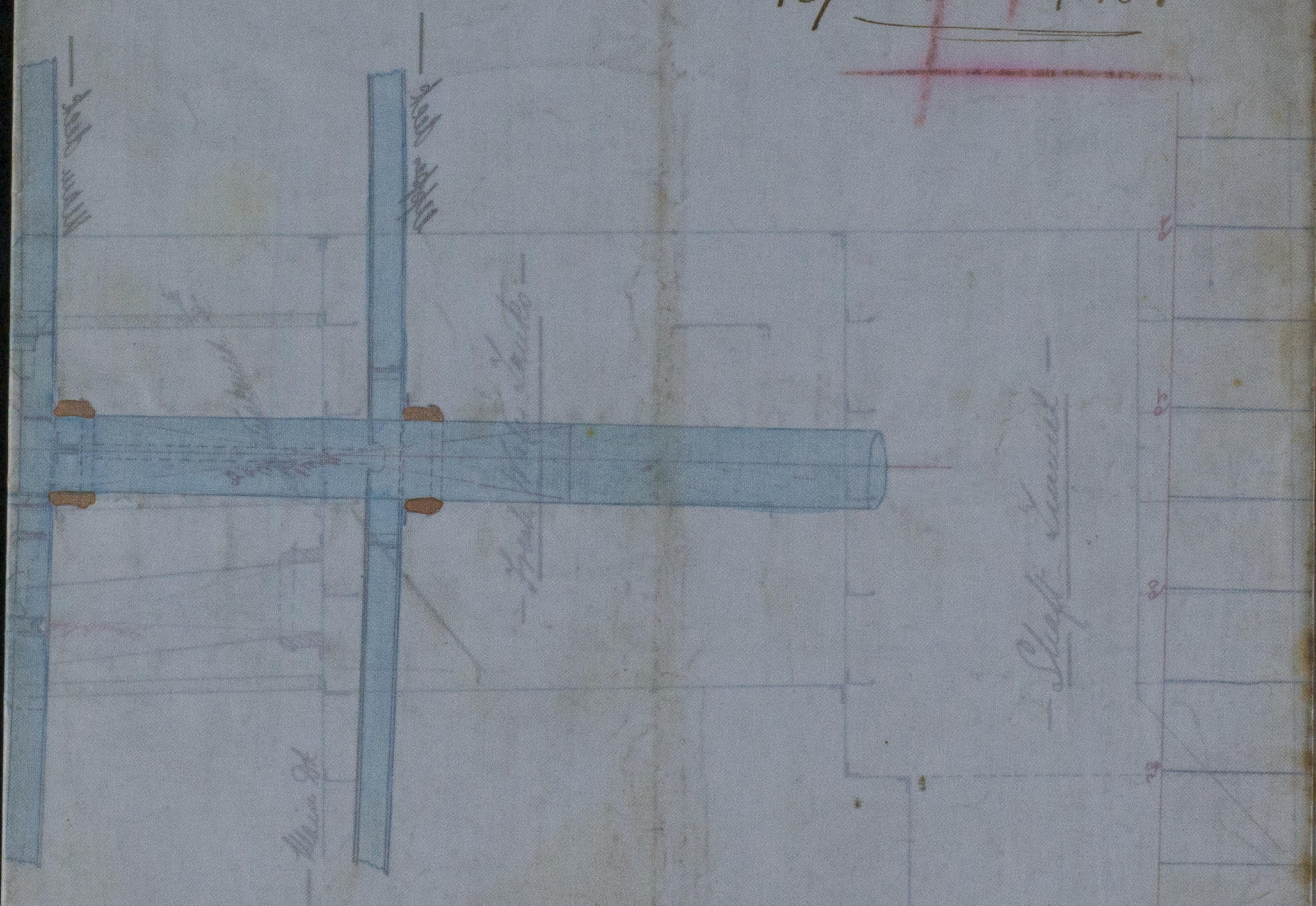

LR

© 2020

Lloyd's Register
Foundation