



5. 9. 91

Section thro' Engine & Boiler Space N^o 91 S.S.
Scale 1/2 inch = 1 foot.

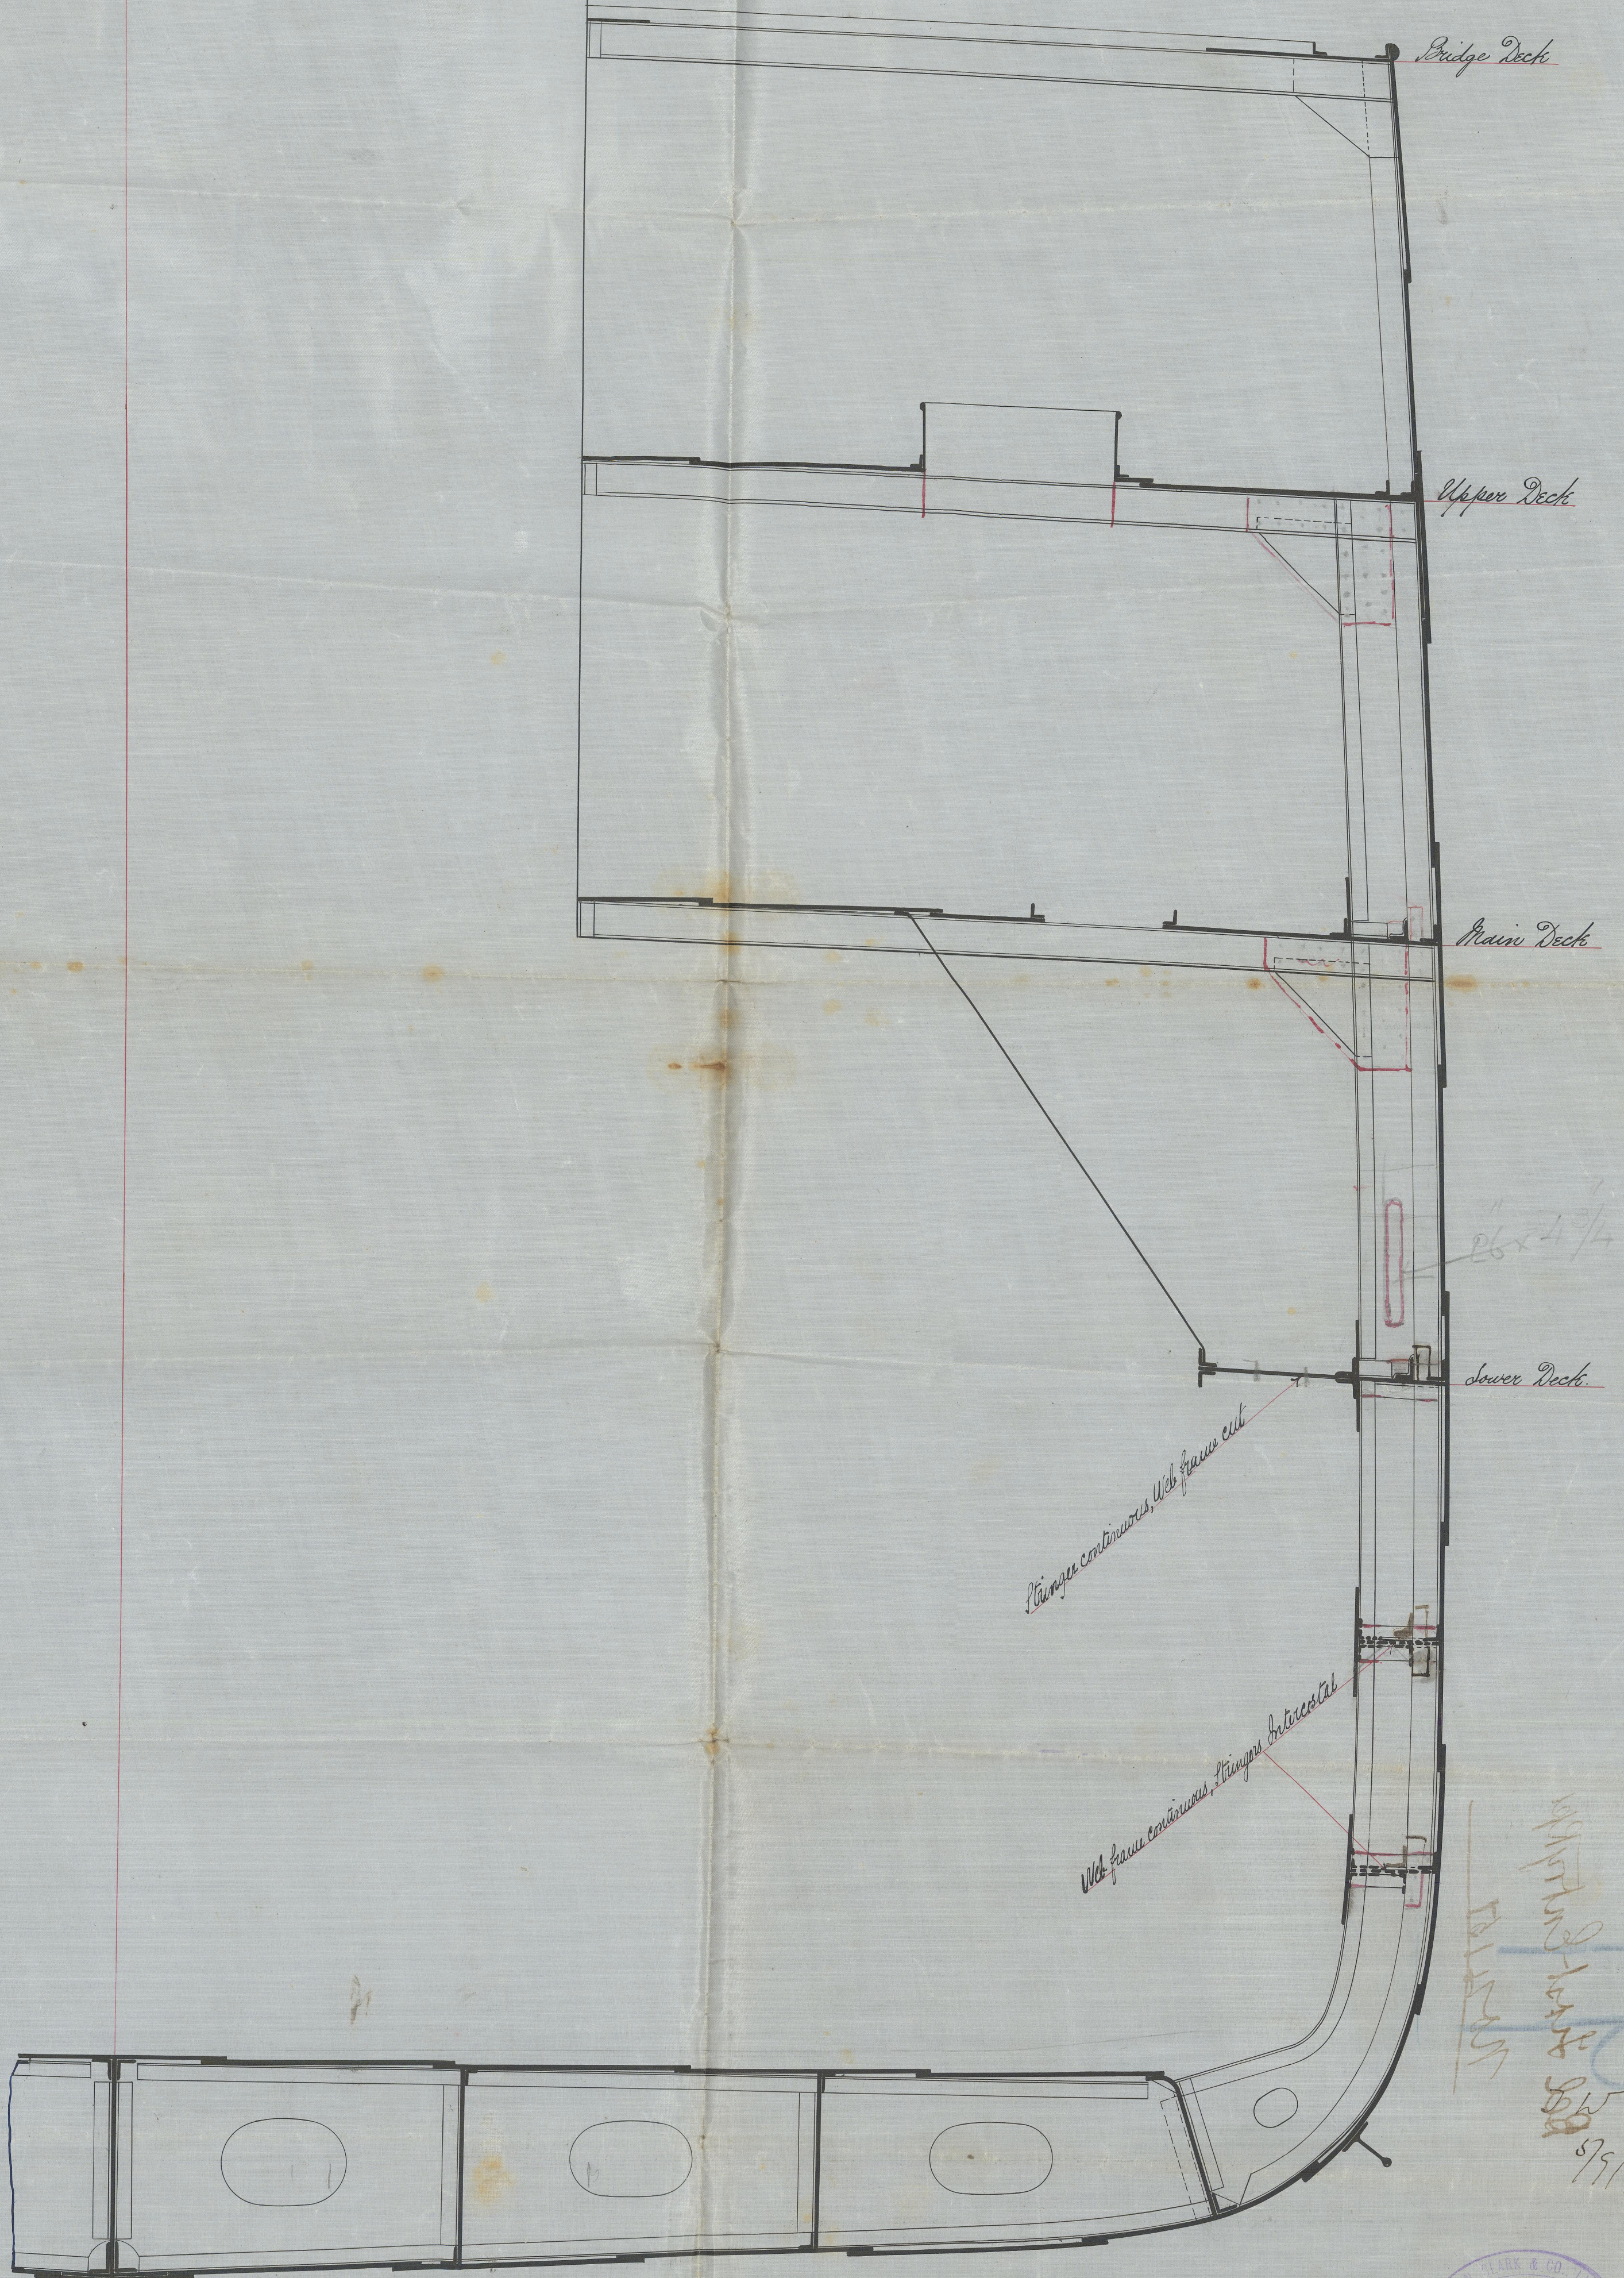

W. H. Clark & Co. Ltd.
15 SEP 91
9/9/91

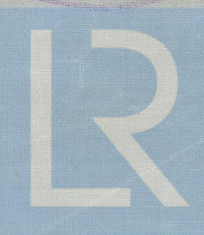

© 2020
Lloyd's Register
Foundation

BEL-0061

BEL61-0061

Southern Cross

Bel First Entry Rpt

No 2157



Sketch of the structure of the space R: 9188





© 2020

Lloyd's Register
Foundation