


17.8.91

Side Elevation of No. ⁹¹ ~~90~~ S.S.
Scale 1/8" = one foot

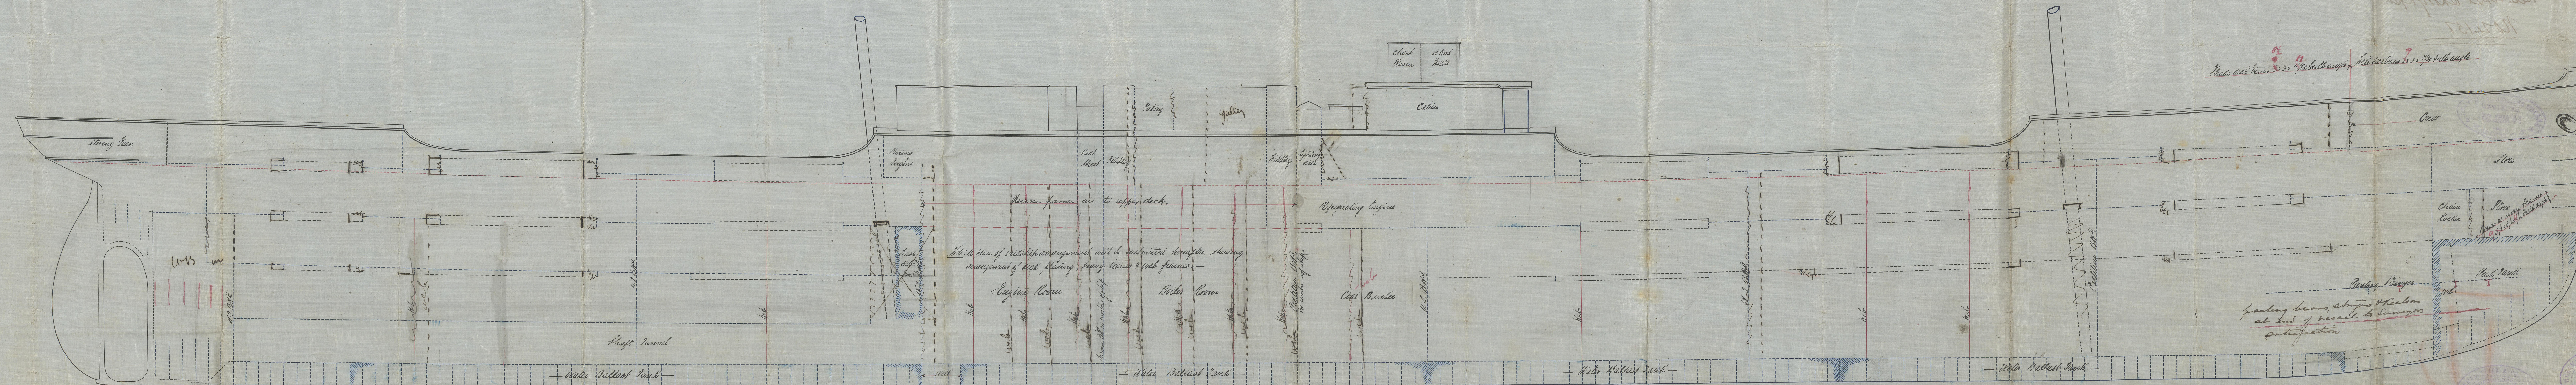

Shade deck beams $8 \times 3 \frac{1}{2} \times 19$ ¹¹/₁₆ *bull angle* * *Hill deck beam* $7 \times 3 \times 17$ ⁷/₁₆ *bull angle*



241-0064



No 4157
Bel. First Entry Rpt

No 4147
Bel. Second Rpt
Southern Cross



© 2020

Lloyd's Register
Foundation