

17.8.91.
9.9.91.
22.9.91


Midship Section No. 90 S.S.

Southern Cross

Class 100. A.1. 3 decks. Steel.

Scale 1/2" = one foot.

Dimensions	1/2 Breadth 23.91	Proportions	Depth to Upper Lt. 11.8
"	Girth 53.50 52.96	"	" Main " 15.5
"	Depth 33.50 33.56	"	Breadths 8.3
	$110.50 - 7 = 103.5$		$103.5 + 398.08 = 41,201$ Plating &c.
	110.43		$103.43 \times 398.12 = 41,177$

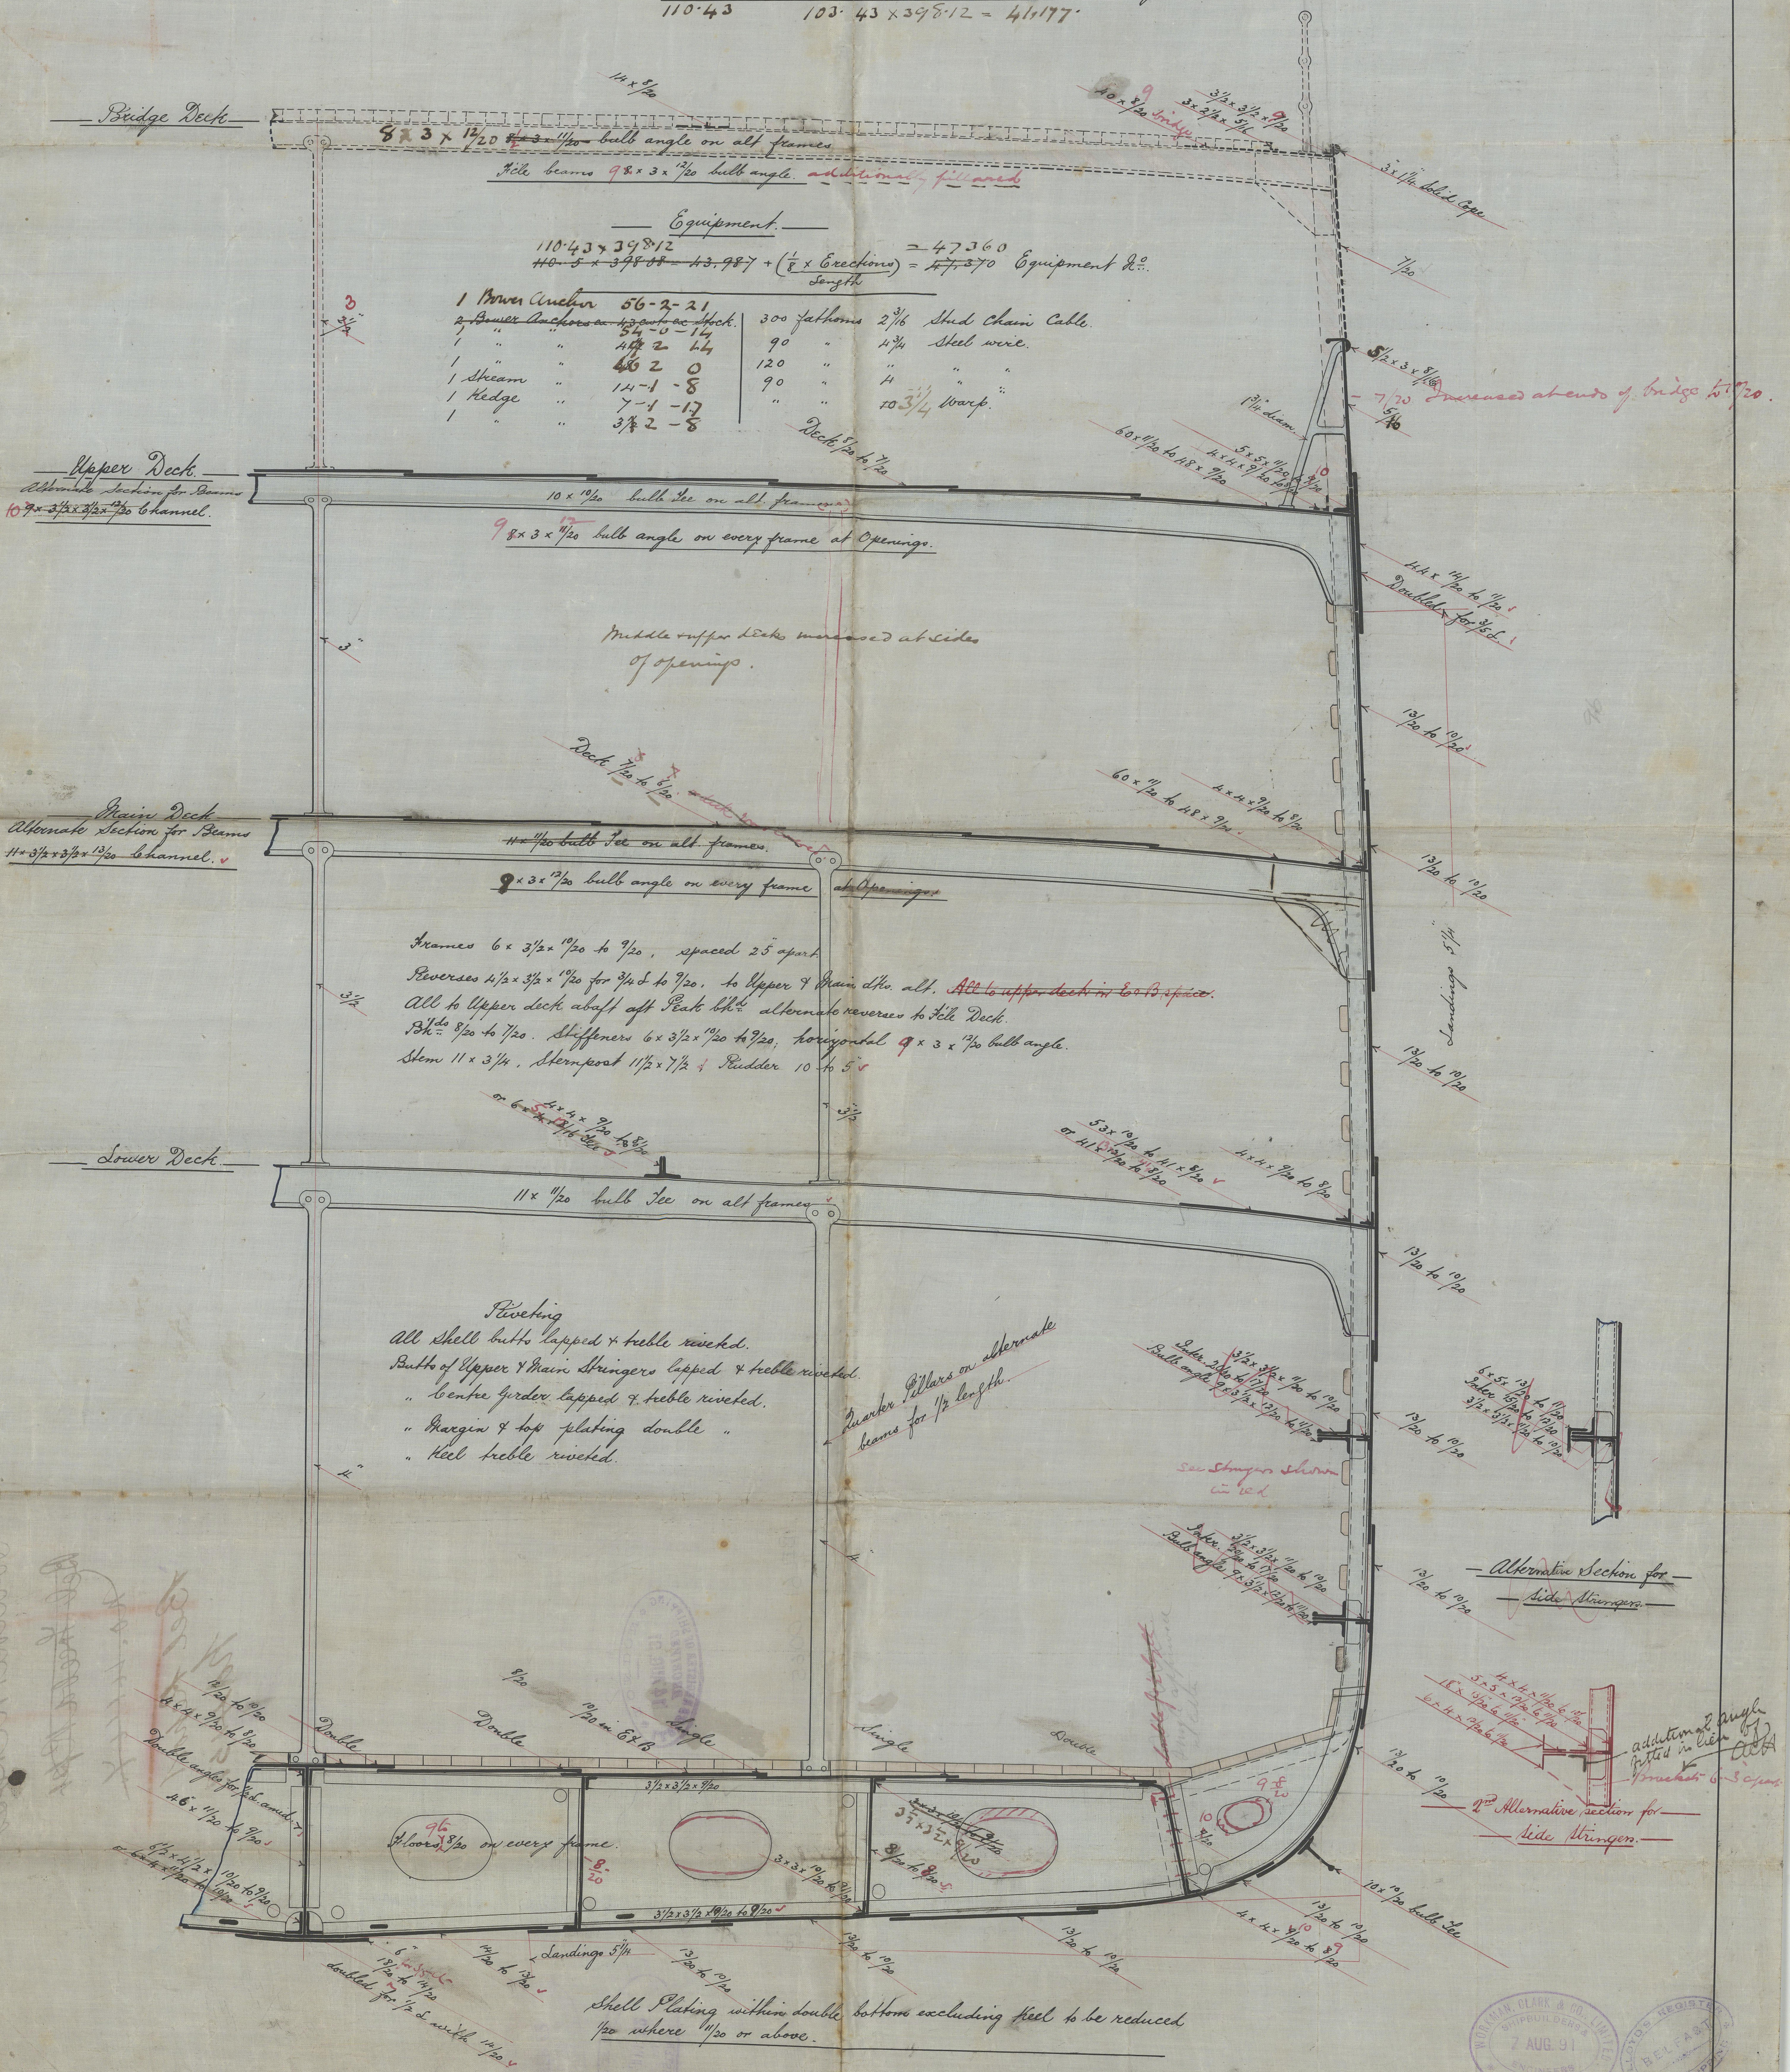

WIMAN, CLARK & CO. LTD.
SHIPBUILDERS
2 AUG. 91
ENGINEERS
© 2020


Southern Cross

~~Bel Greba Rpt~~

~~No. 4147~~

Bel Report

No 4151

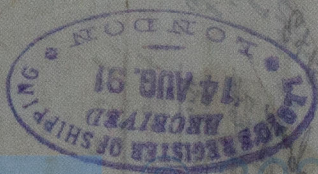

© 2020

Lloyd's Register
Foundation

BE 61-0065