


Nº 270


Ch 10-11-92

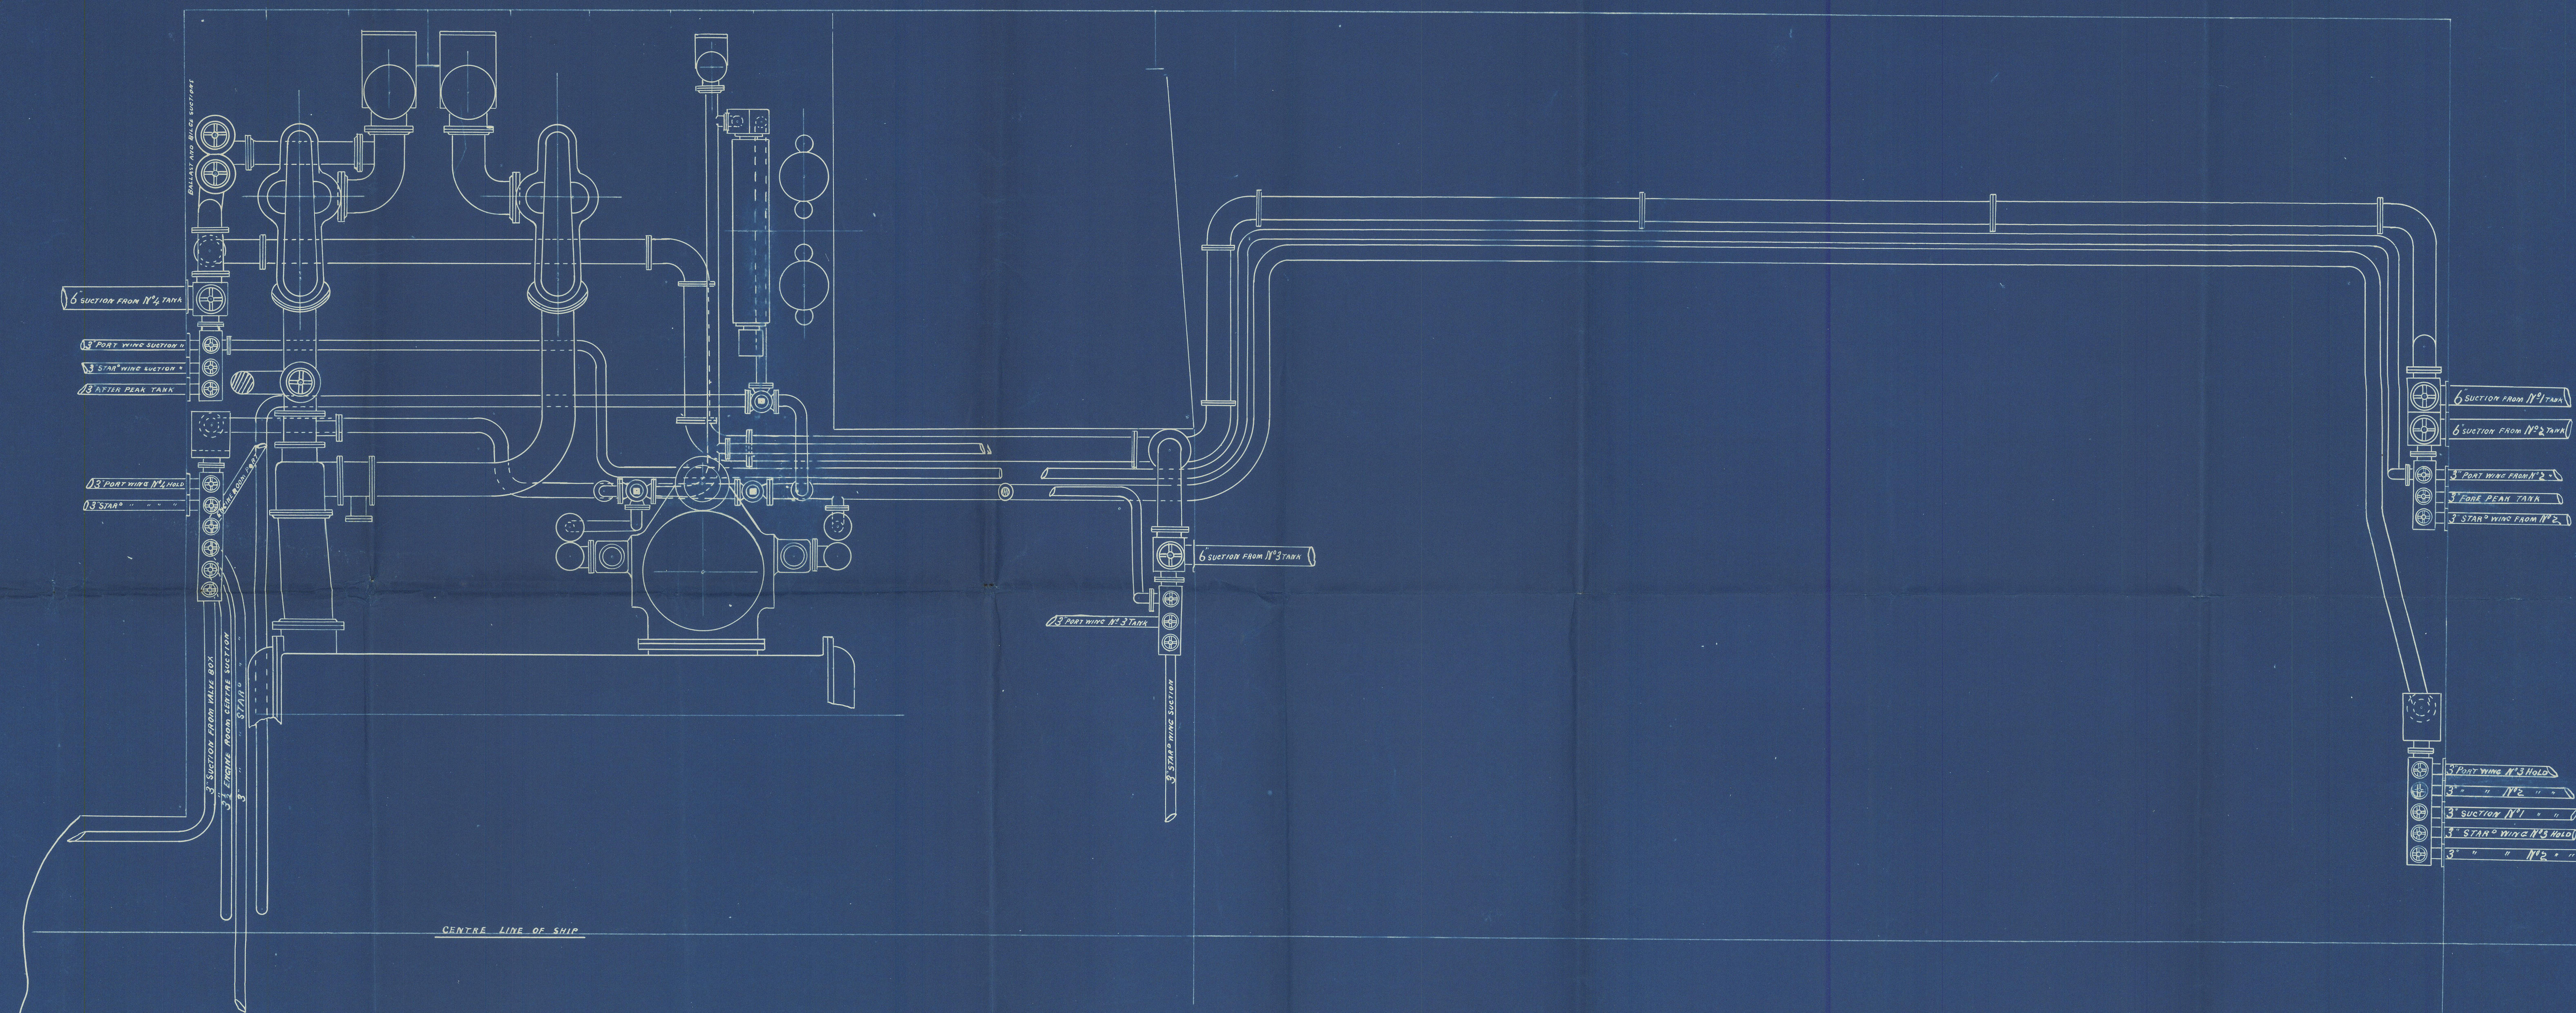

— Bilge and Ballast Arrangement. —
" SS N° 91. " ENG^s N° 1

scale 1/2" = 1 foot

13th
11/11/92

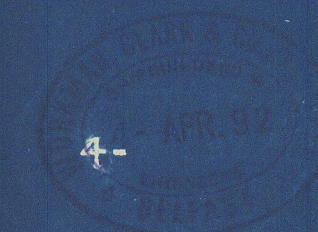

Lloyd's Register
 BEL61-0066

91

No. 7

E. R. Pumping

Southern
Cross

Bel Rpt no
4157



© 2020

Lloyd's Register
Foundation

BEL-61-0066