

— Scale $\frac{1}{8}$ inch = 1 foot —

Under Dr. & Income 2115
Less $\frac{1}{5}$ 423.
1692

waterman
york bank
200
1844


Size	Breaking Load
4 1/4	38 tons
3 1/2	26 -
3	19 -
2 1/4	11 -

For BEL 61-0087 (1/2)
Enclosure to

Messrs. *Lloyds Lagers*

Ln: 11-7-92
3-8-92
23-8-92

BPL

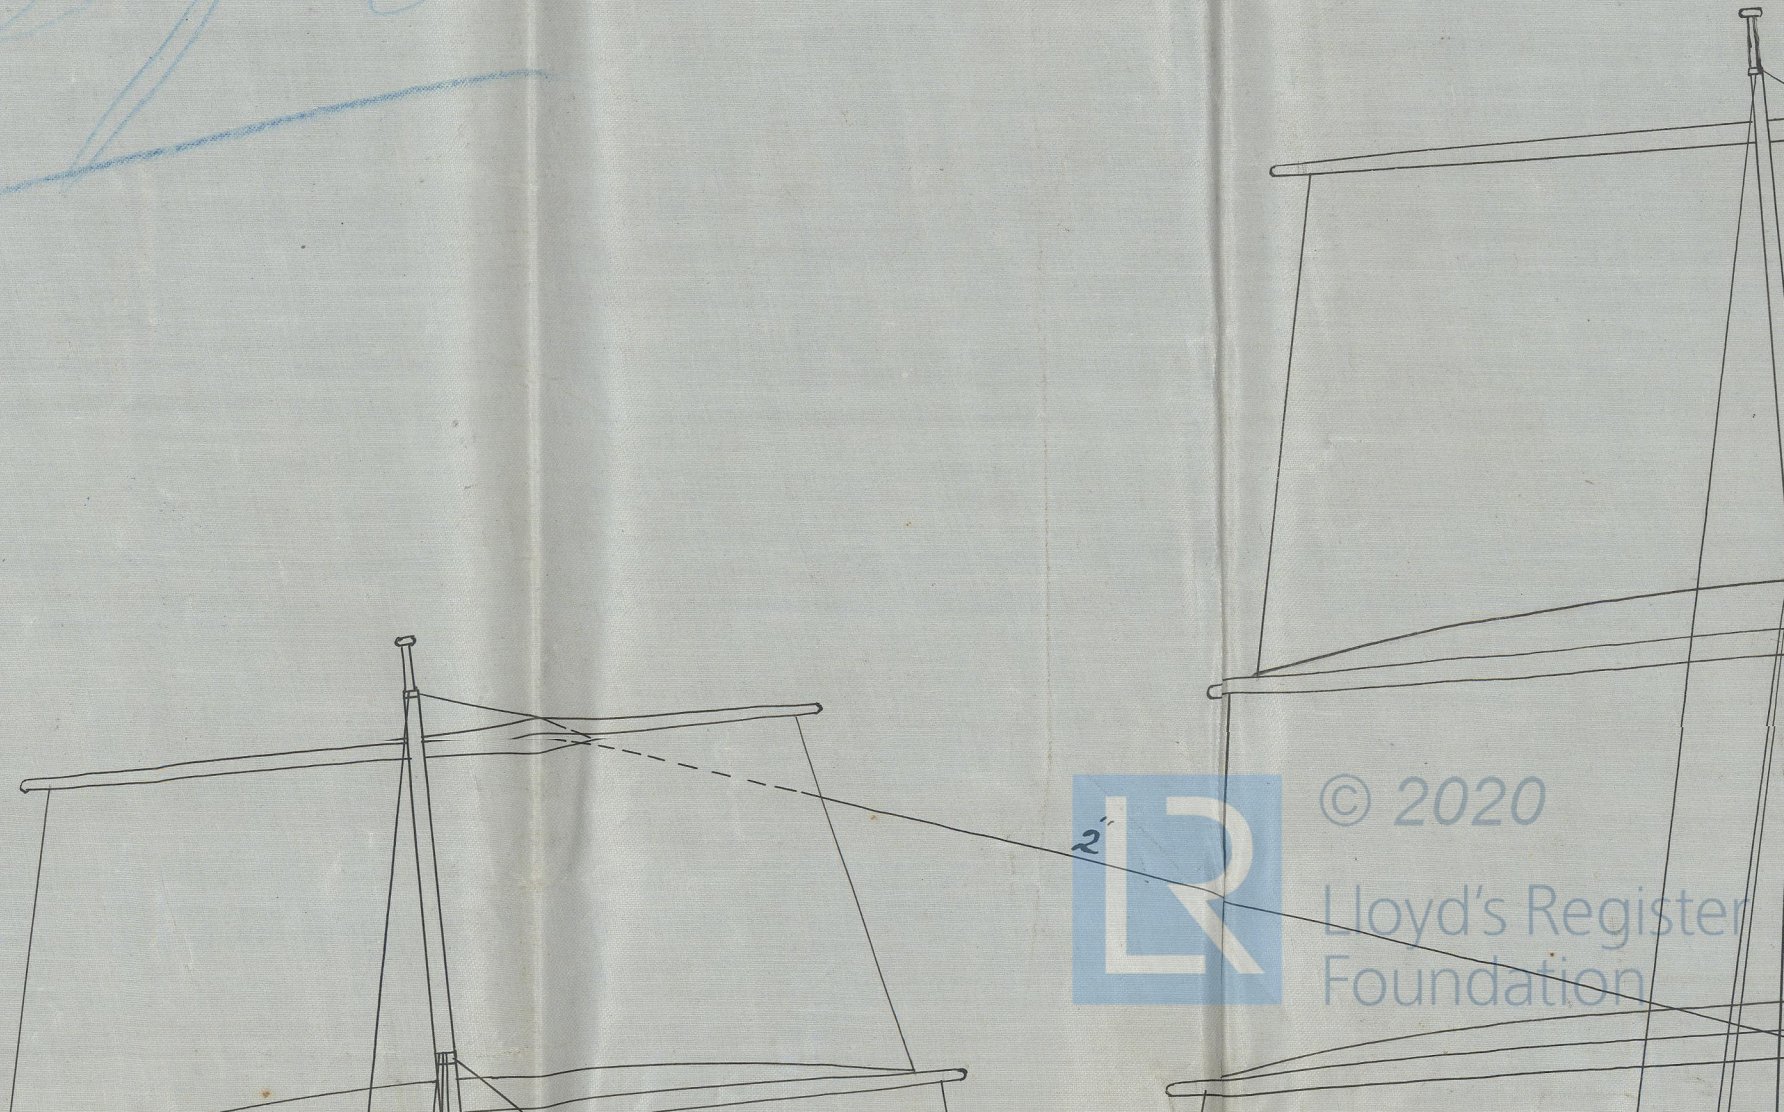

© 2020

Lloyd's Register
Foundation

1 - dim 8 inch -

97

Lauroston

Bel. First Entry

Rpt. no. 4198



© 2020

Lloyd's Register
Foundation
(12) - (12/12)