


Outline Midship Section N<sup>o</sup> 97 Sailing Ship

Scale  $\frac{1}{2}$ " = one foot.

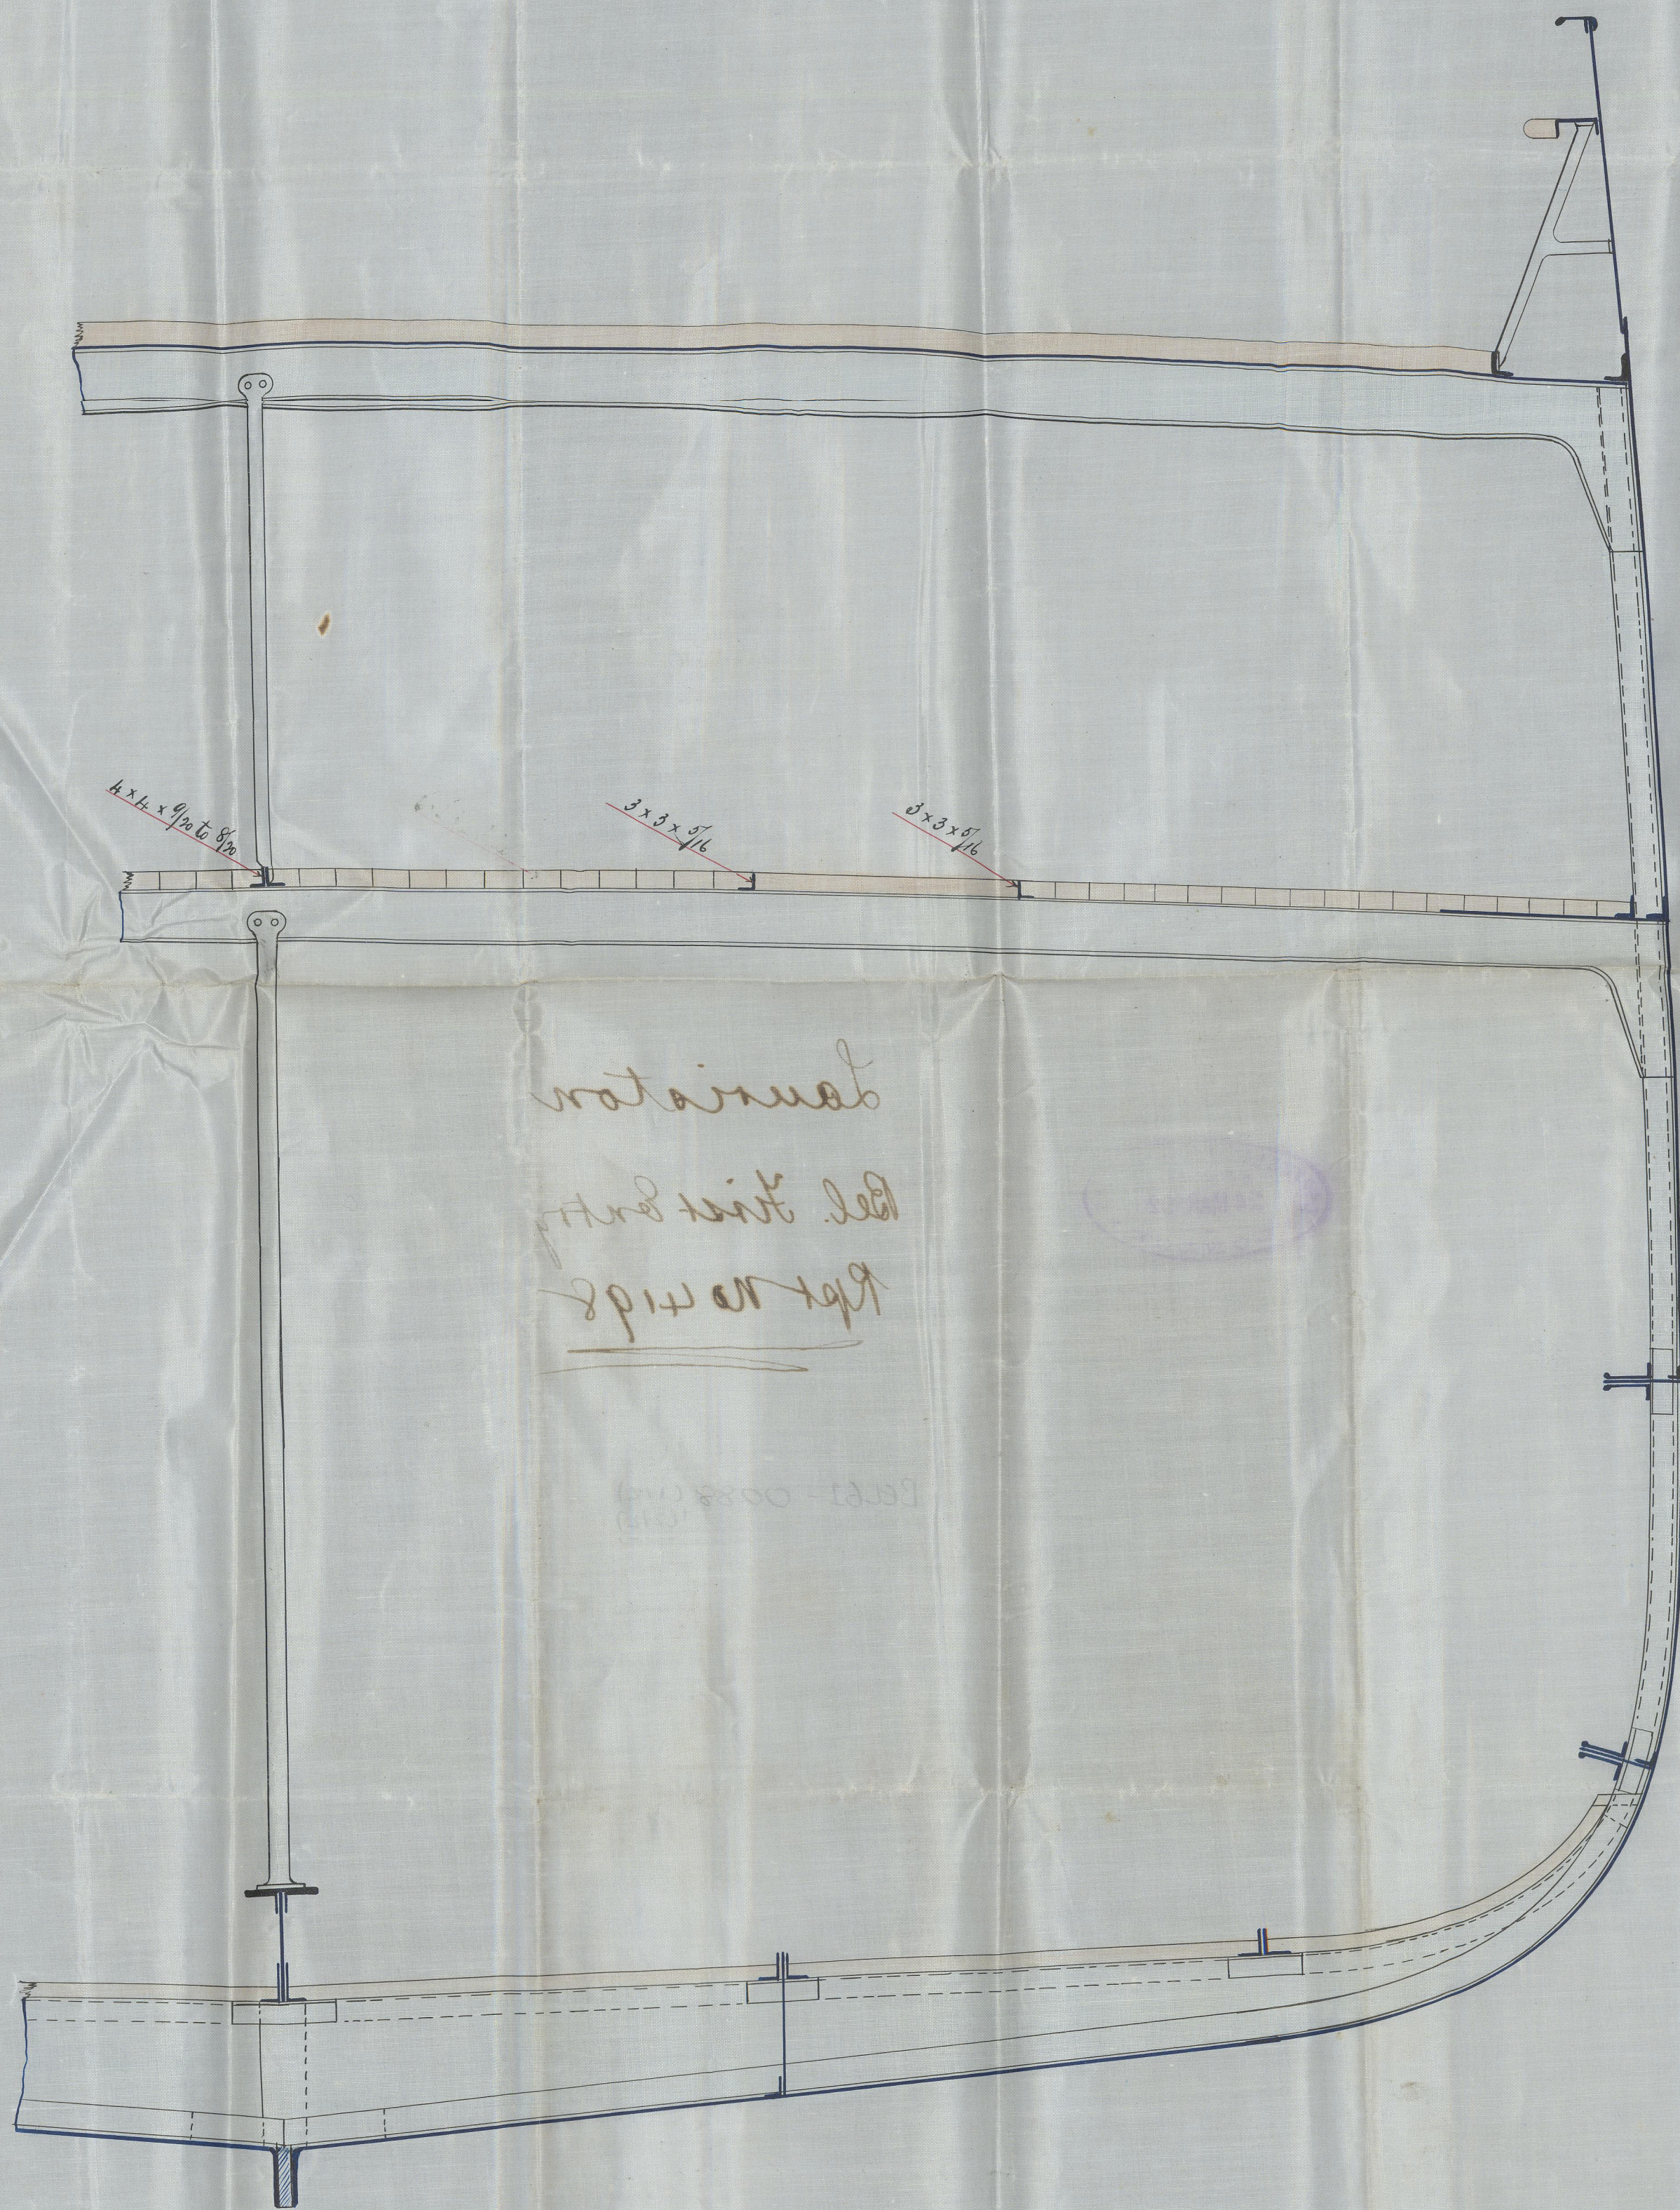

rotational  
first trial

1000 - 1000

J.M.  
20/3/92

LLOYD'S REGISTER  
BELFAST  
OF SHIPBUILDERS

23/3/92

WORKMAN, CLARK & CO., LIMITED  
SHIPBUILDERS  
22 MAR. 92  
ENGINEERS  
BELFAST

L

© 2020

Lloyd's Register  
Foundation



BEL 61-0088  
For Enclosure to (1/2)

Messrs. *Lloyd's Register*

~ Outline Midship Section N<sup>o</sup> 97 Sailing Ship ~

~ Scale 1/2" = one foot. ~



© 2020

Lloyd's Register  
Foundation




Lauriston

Bel. First Entry

Rpt No 4198

BEL61 - 0088 (1/2)  
+ (2/2)

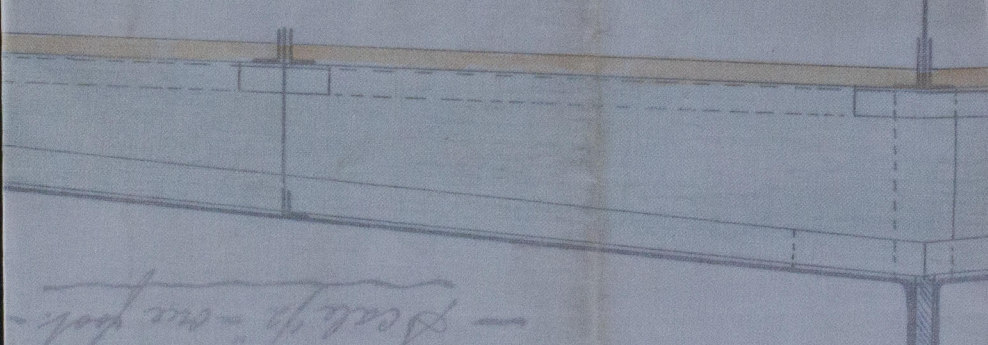


Outline Midship Section No. 4198



© 2020

Lloyd's Register  
Foundation