


No 706


See  
List: 20:11:92

# No 5 MAIN BOILERS

~ Sketch showing doubling plate in lieu of stay ~

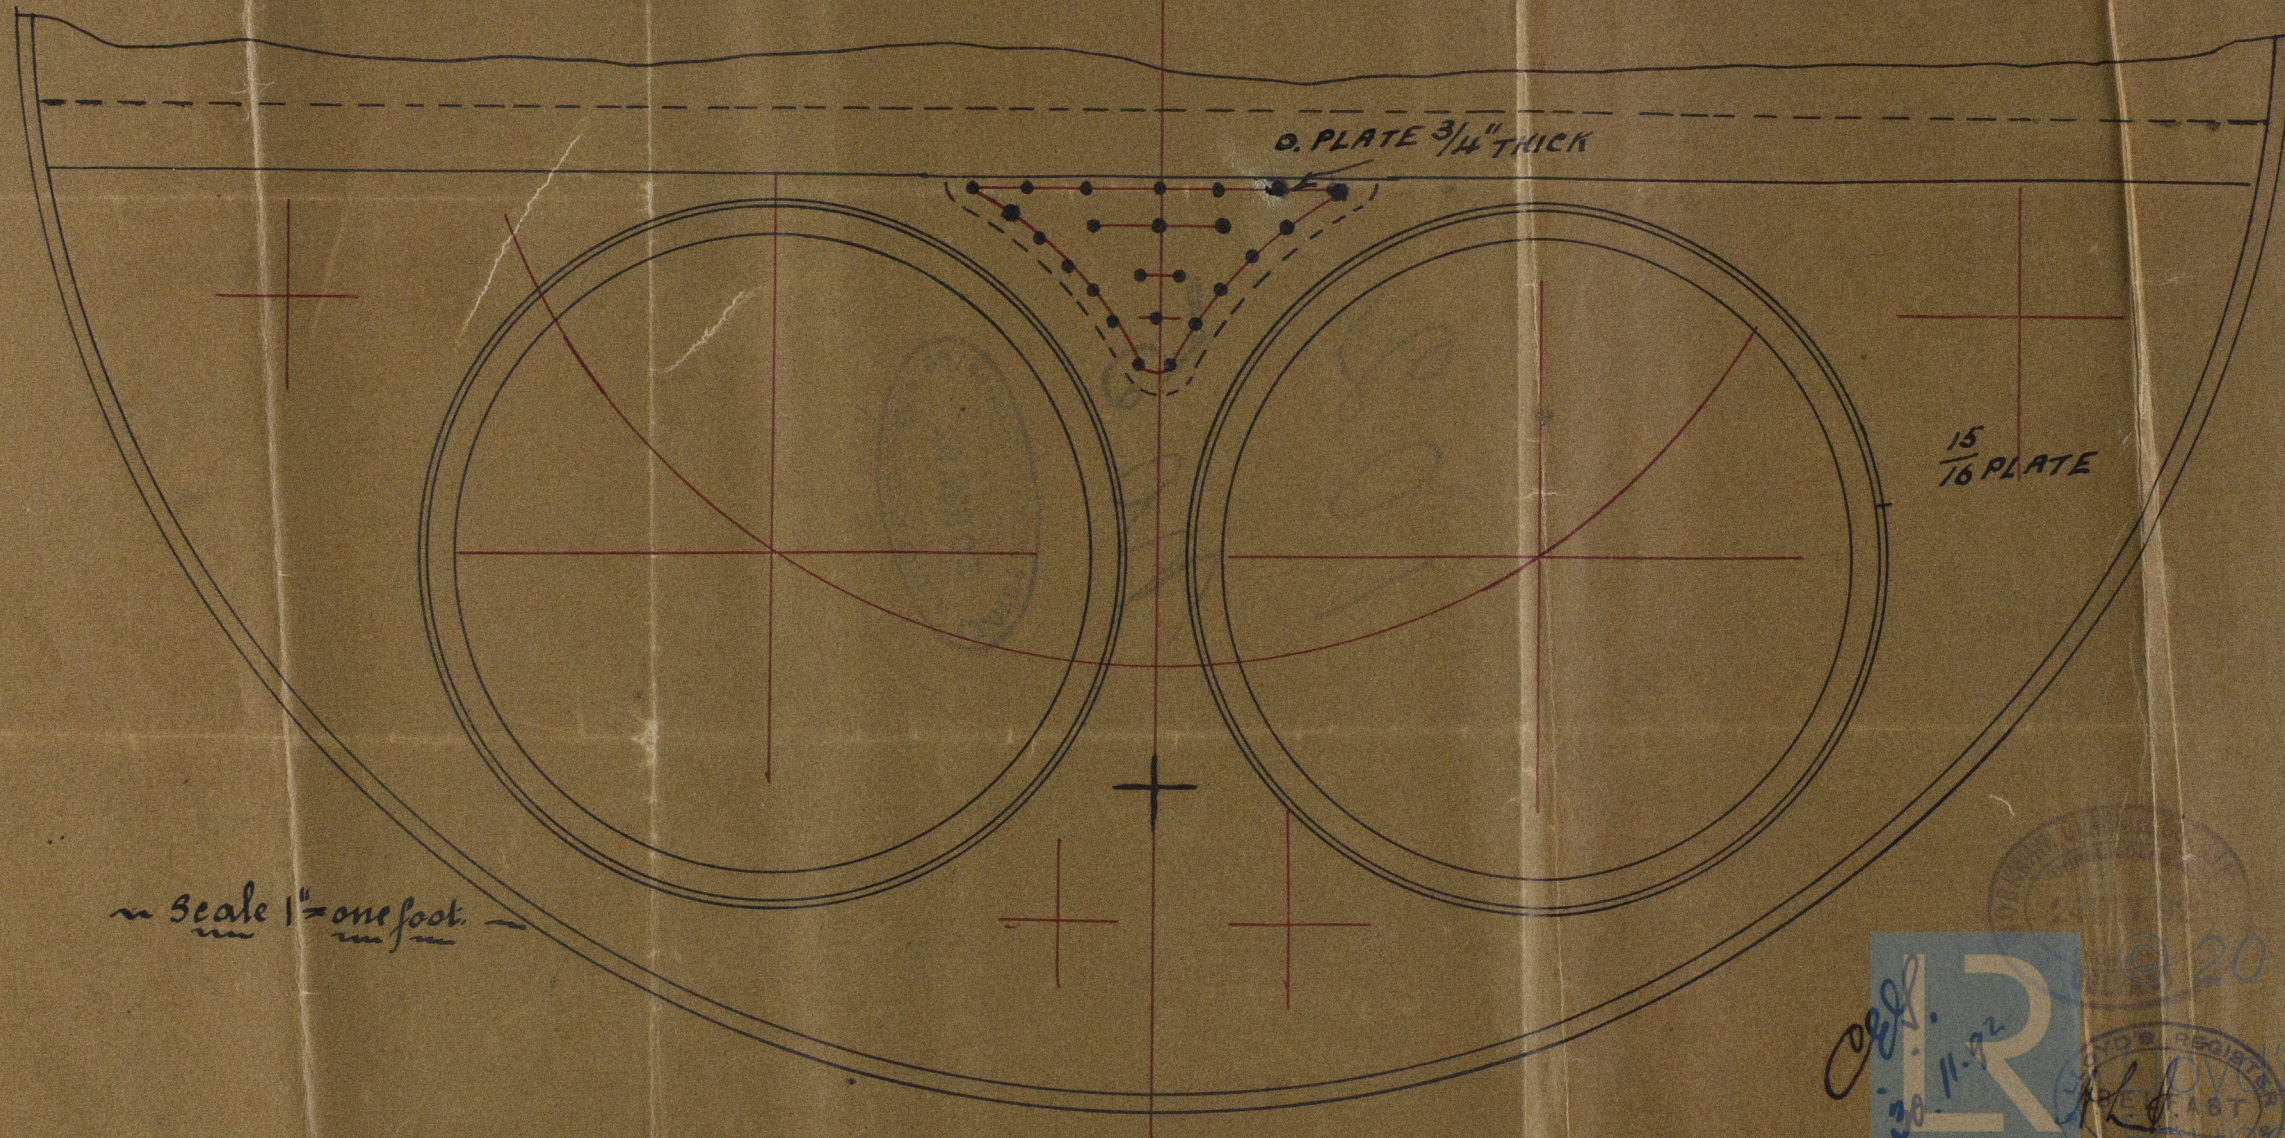

~ Scale 1" = one foot ~

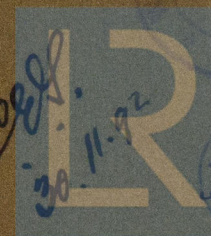

© 2019

Foundation