
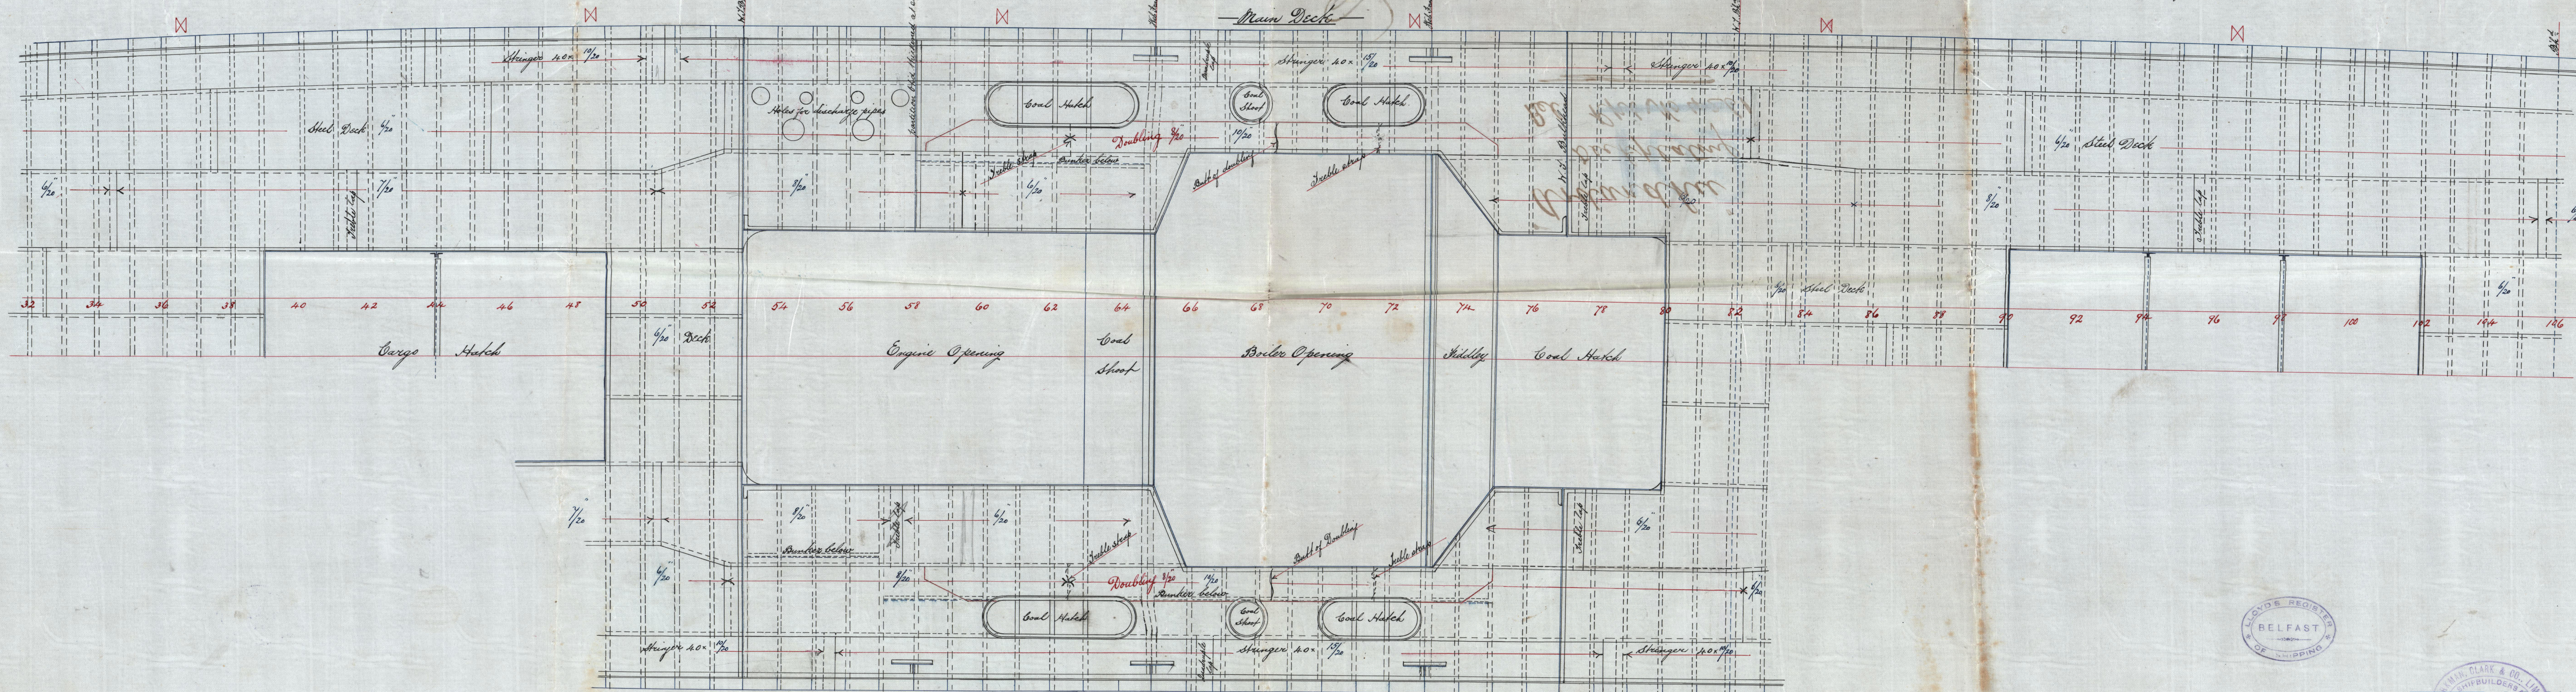
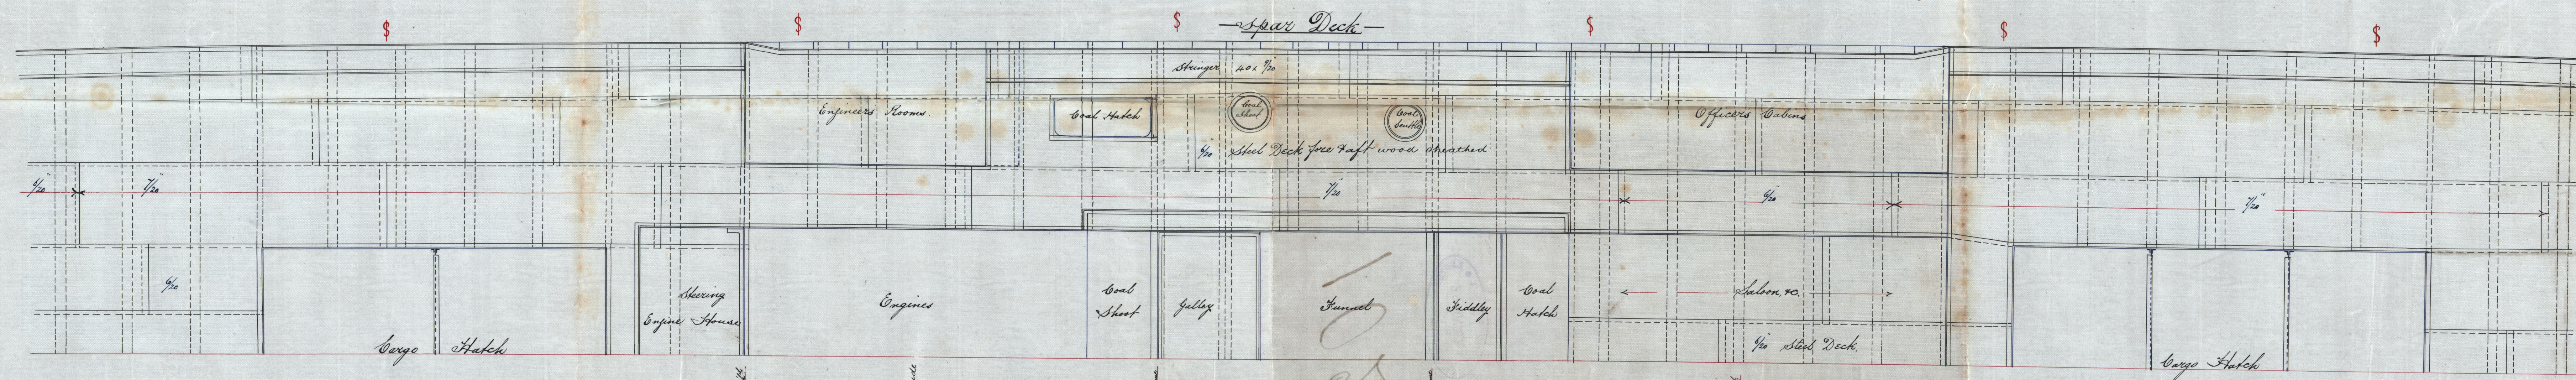


Midship Arrangement of Beams and Deck Plating of S.S. No. 102.


Scale 1/4 inch = One foot.

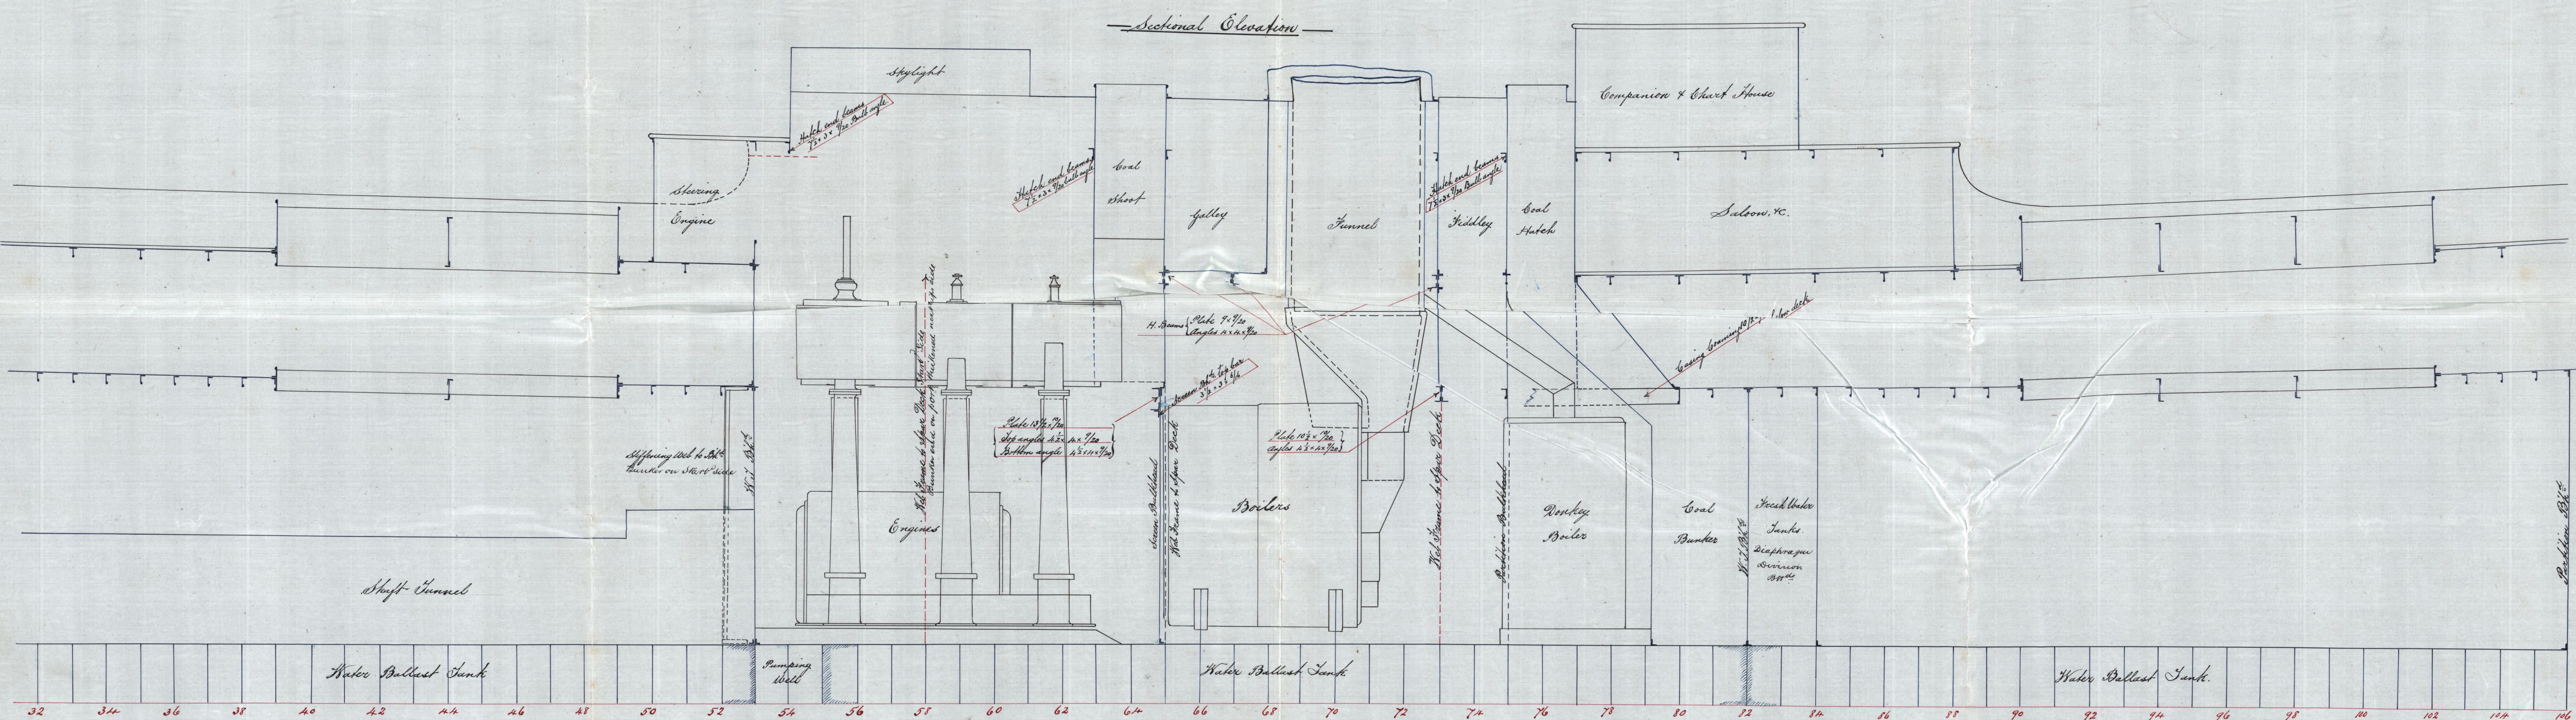

Ardandhu
Deckplating
Bel. Rpt No 4261

BEL62-0078

102

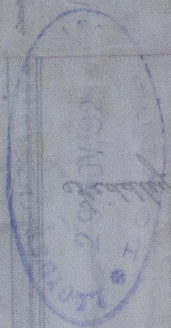

© 2021

Lloyd's Register
Foundation