


Scale 1" = one foot

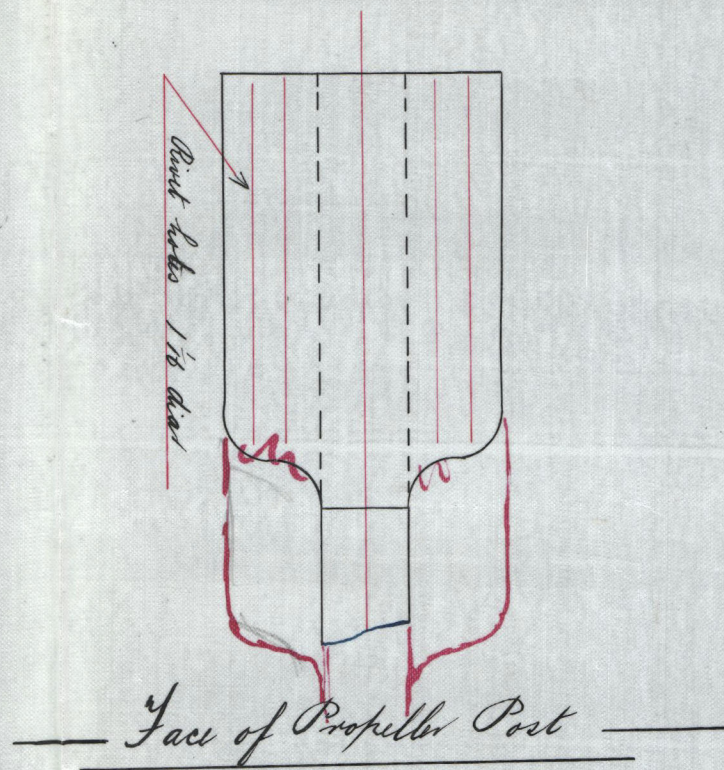

For Enclosure to

Messrs.


Lloyds Supervisors.

Ardanaku


102

Stern Frame

Bel Rpt No 4261

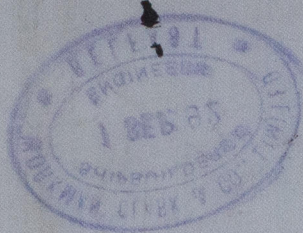

BEL62-0080

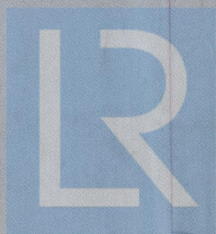

© 2021

Lloyd's Register
Foundation