

Dr: 12.7.92
S. 8.92


Longitudinal Elevation of N^o 102 S.S.

"Ar dand hu"

Scale 1/8 inch = 1 foot.

Ar dand hu
201

Sanibutiprab
185 Nov 29. 92

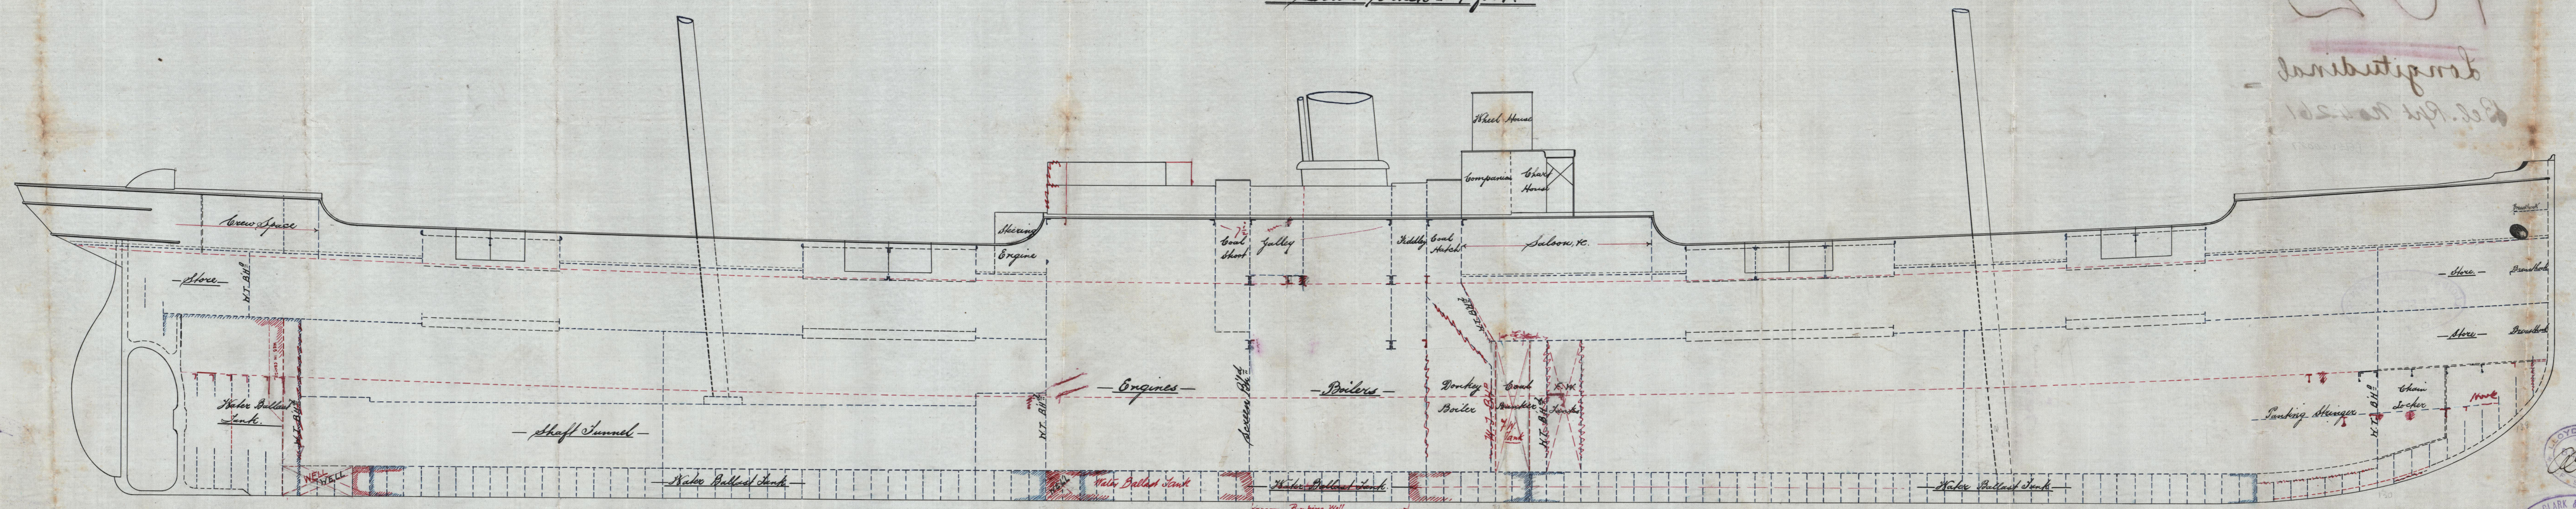

Note: A part longitudinal Section, + Deck Plan will be submitted hereafter shewing arrangement of Web Frames, heavy beams, + Deck plating amidships.



REGISTER OF SHIPS
RECEIVED
Ardandhu

102

Longitudinal

Del. Rpt No 4261

BEL62-0087



© 2021

Lloyd's Register
Foundation