


24.3.93
6.4.93

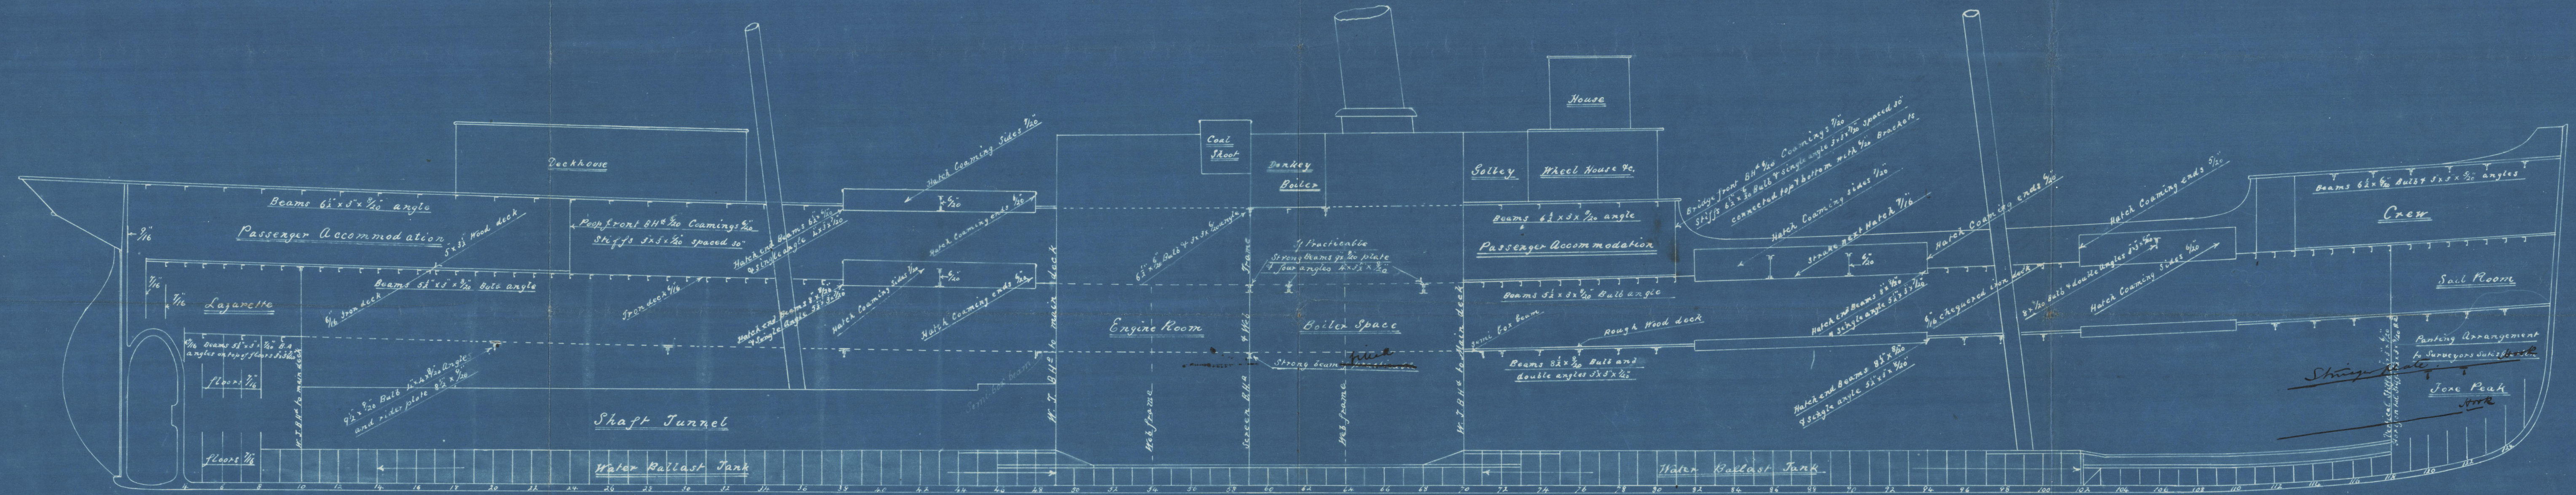

Profile. S. S. N° 57.

Scale 1/8" = 1 foot

Longitudinal strength of
bottom to be efficiently
maintained at ends of double bottom
through machinery space.

MAGILWYNE & MACCOLL,
LIMITED
17-20/18
20.3.93
SHIP BUILDERS AND ENGINEERS,
BELFAST.

11.9.93




Lloyd's Register
Foundation

B6462-0101



17/3/95

Wazzan
5
First Entry Rpt
BELFAST
No 4310
Profile

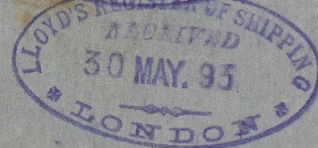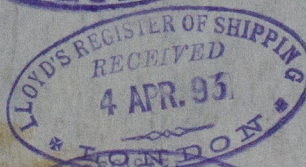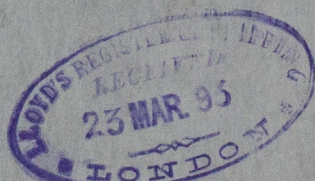

BEL62-0141

