

6.4.93


S. S. No 57.

Centre Keelson in E & B. Space.


Scale 1" = one foot.

No 3030

MAGILWAINE & MACDONELL
30.3.93
SHIP BUILDERS AND ENGINEERS,
BELFAST.

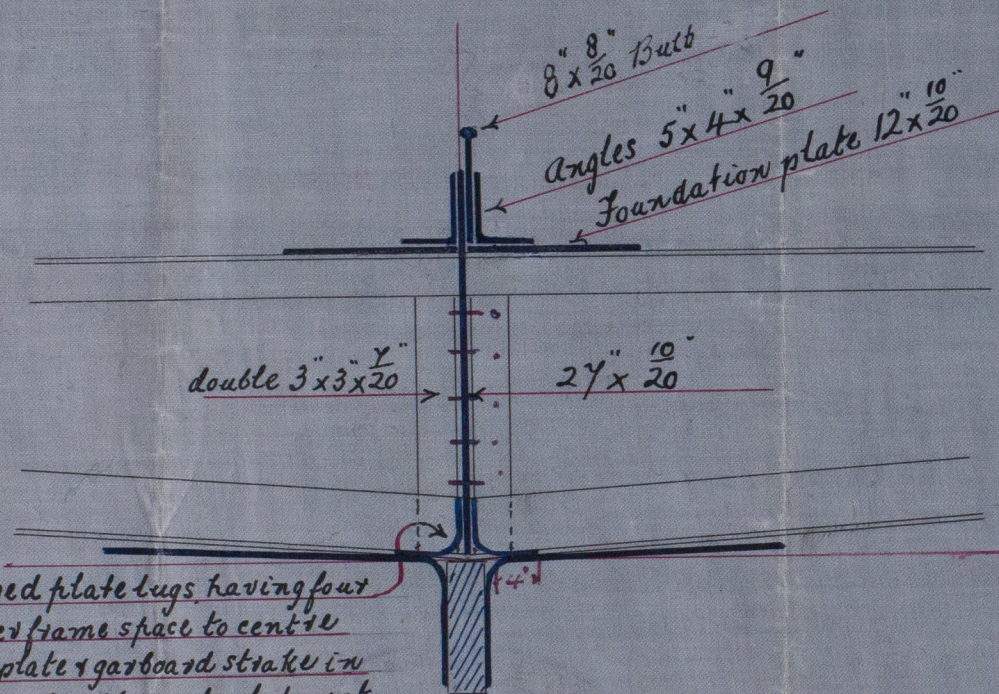

20 flanged plate lugs having four rivets per frame space to centre through plate & garboard strake in lieu of centre through plate not being connected to keel.

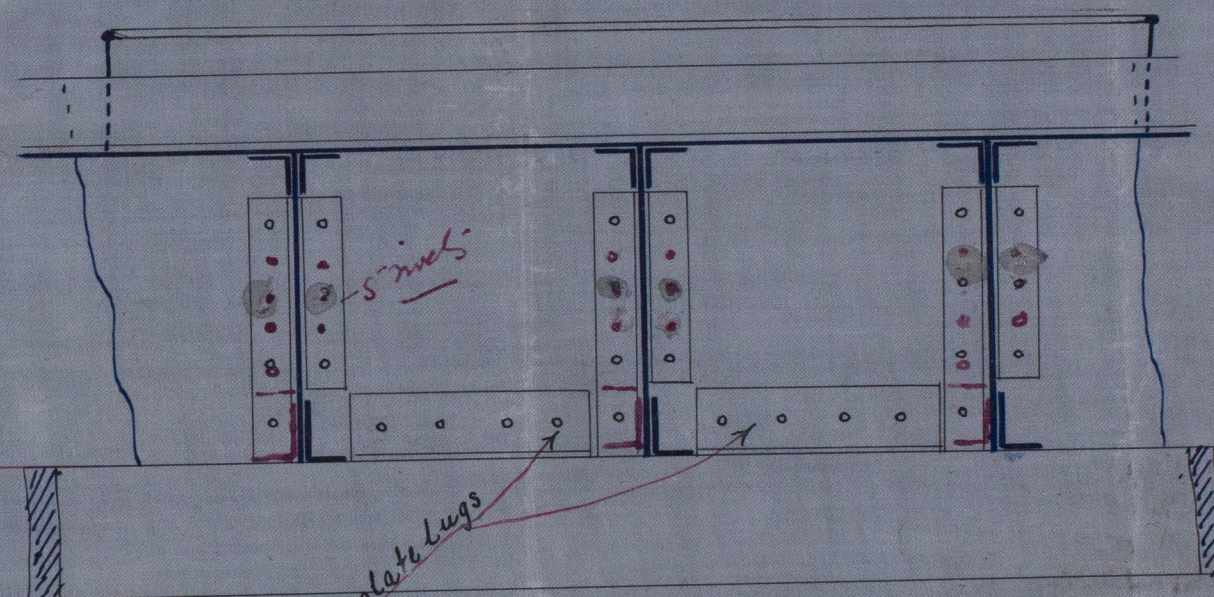

Flanged plate lugs

M.D.
7.4.93

© 2021
LLOYD'S REGISTER
OF SHIPBUILDING
BELFAST

LR


Lloyd's Register
Foundation

REG-0143

Re East 4310.

57

Record construction of vessel
from of center of gravity of vessel


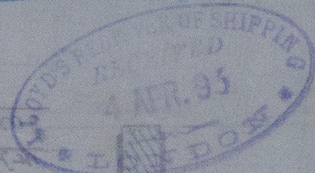


BEL62-0143



6.4.93

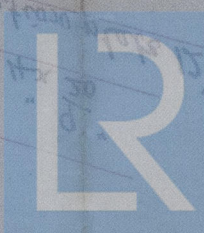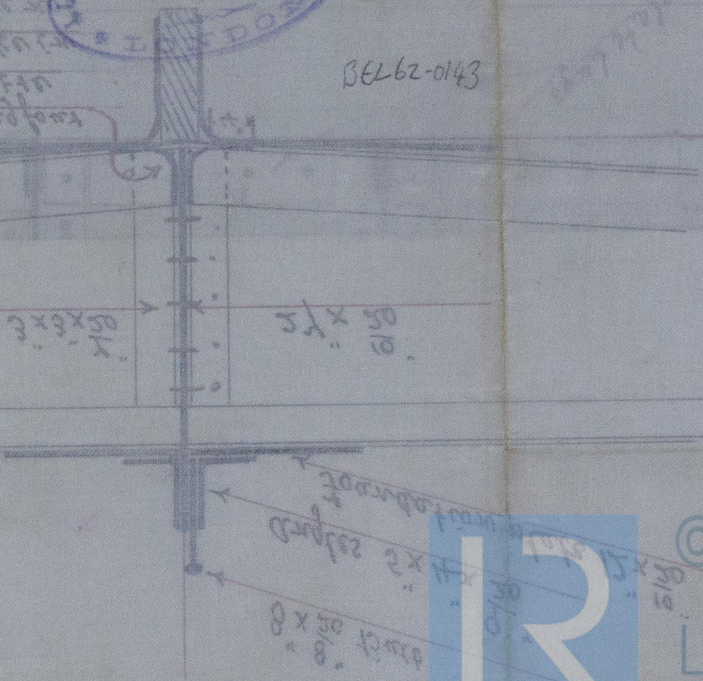

© 2021

Lloyd's Register
Foundation