

Lloyd's Register of British and Foreign Shipping.

(Report on Vessel No. _____ Port _____)

No. **4094** SHIP FORGINGS OR ~~CASTINGS~~.

I have to report that the undermentioned Iron or Steel Forgings or Castings,
 manufactured by *Messrs Wm Beardmore & Coy*
 of *Glasgow* for the Vessel No. *137*, being built
 by *Messrs Macilwaine & Maccoll of Belfast*
 have been inspected by me as set forth below, and found to be, so far as can be seen,
Sound & efficient

* The words FORGINGS or CASTINGS, IRON or STEEL, should be struck out as may be required.

Mark on Forgings.

Lloyd's

No. **4094**
W.H.*William Hamilton**Glasgow*
14/8/93

STERN FRAME.

RUDDER FRAME.

STEM.

Material* ...

How made ...


Dimensions ...

Progress on Inspection

Date when Inspected

Scrap iron
Forged
6 1/2 dia
Forging & smithing
20.23/27.30/6/93. 13
5.7.10.12.24/7/93. 1
3.4.5/8/93

SKETCHES OF FRAMES SHOWING POSITION AND DESCRIPTION OF WELDS OF FORGINGS, OR PARTICULARS OF
 TESTS APPLIED TO CASTINGS.

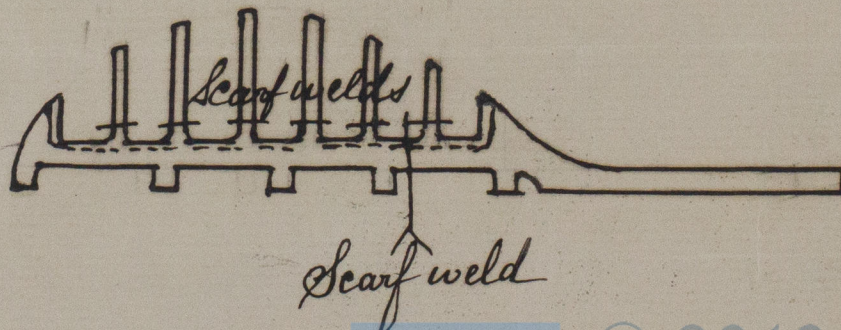

© 2019

Lloyd's Register
Foundation

14004











No 4310

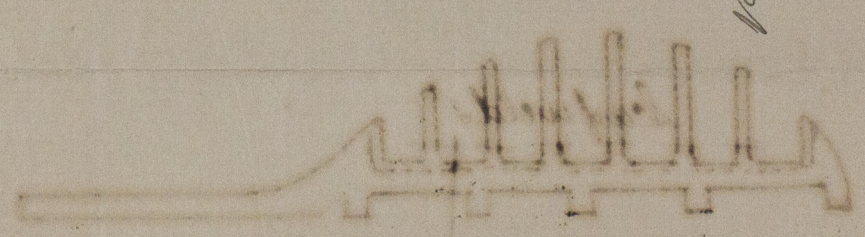

© 2019

Lloyd's Register
Foundation