


27.4.93

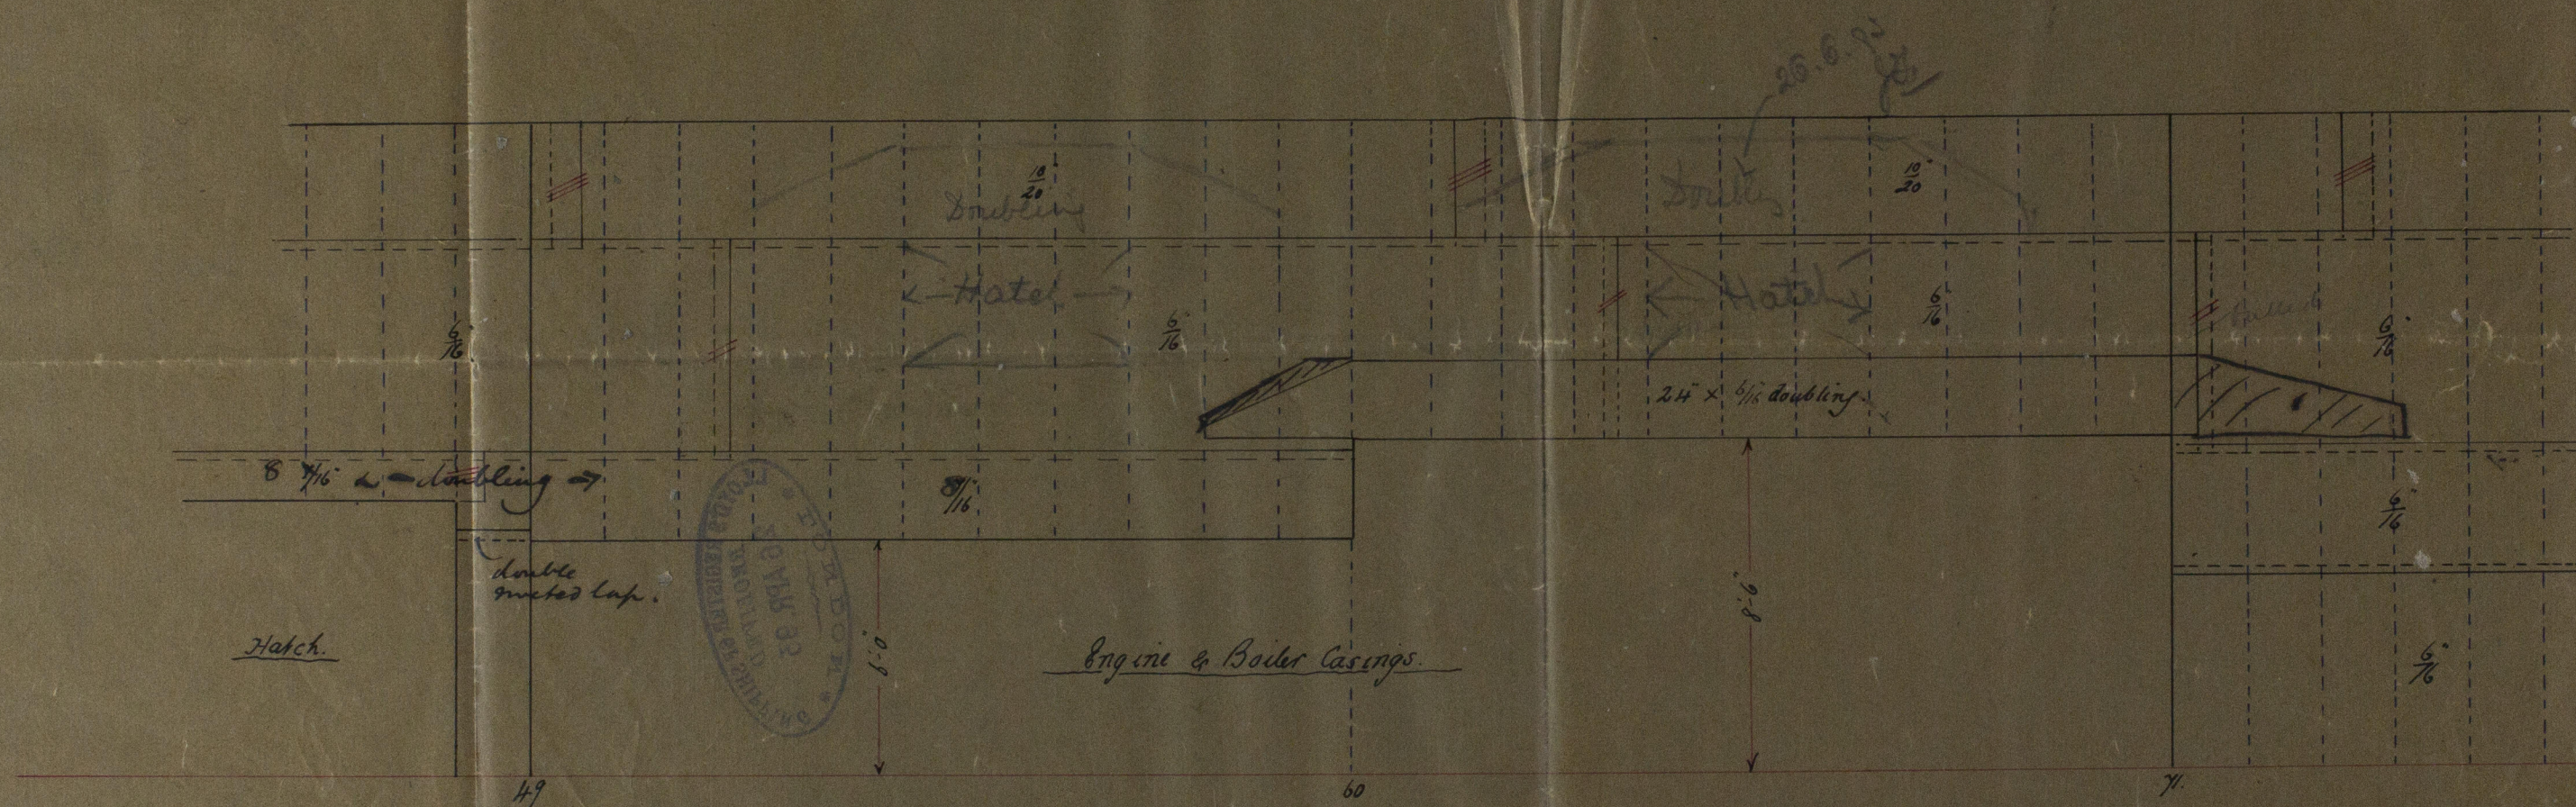

Proposed Strengthening of Main Deck  
in way of Engine & Boiler casing Opening

S. S. 11° 57'



Scale 1/4" = 1 foot

*Handwritten notes:*  
M. J. [unclear]  
[unclear]  
[unclear]  
[unclear]

*Handwritten:* M. J.  
*Stamp:* BELFAST






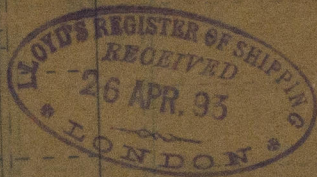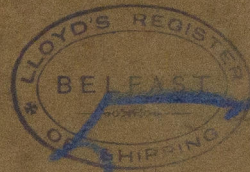

Wazzan

First Entry Rpt  
No 4310

BEL62-0149

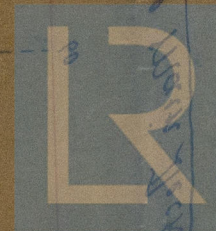

© 2021

Lloyd's Register  
Foundation


Examine & approve

Grid area with faint handwritten notes and markings.