

Chr. 9: 5: a<sup>3</sup>

Working Pressure 80 lbs per sq. inch.


Longitudinal seams lap jointed, 4 rivets per pitch  
Circumferential " " " 2 " " "  
Steel rivets  $\frac{1}{2}$ " dia. 3' 50" pitch  
Holes drilled in place after bonding  
Safety Valves  
McNeil's Patent Manhole Doors 16" x 12" x 14" x 10"  
With shorter axis longitudinally in shell

Shell Riveting.

Shell	$\frac{7}{16}$ thick
Rivets	$\frac{7}{16}$ dia
Pitch	3.508.

N.A.  
8.5.93


Scale 1" = 1 Foot.

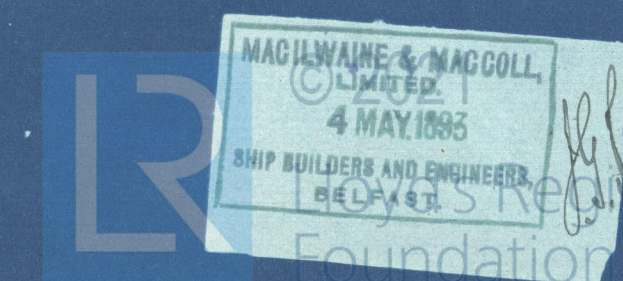



BELFAST

57  
Wazgan  
First Entry Rpt  
Donkey  
No 4310

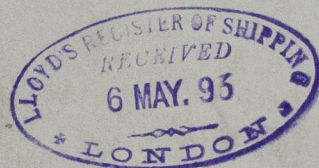

BEL 62 - 0154

11.1.94



© 2021

Lloyd's Register  
Foundation