

Increased Thickness Proposed
In Way of Main Deck Openings

Scale $\frac{1}{4}" = \text{One Foot}$

DECH WINE & MACCO


13.11.81

19.4.93


A.L.D.
21. 4. 93

Wazgan
Bel. First Entry Rpt
No 4310

Deck Plating

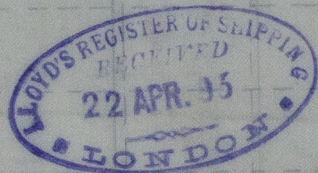

BEL 62-0155

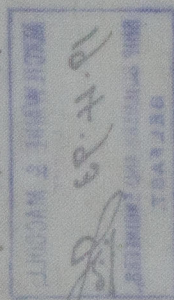

© 2021

Lloyd's Register
Foundation