

— Midship Section of N° 105 Screw Steamer —

— Class 100A1. 3 Decks Steel —


— Scale $\frac{1}{2}$ inch = 1 foot —

Ormiston

Bridge Deck

Upper Deck

Main Deck

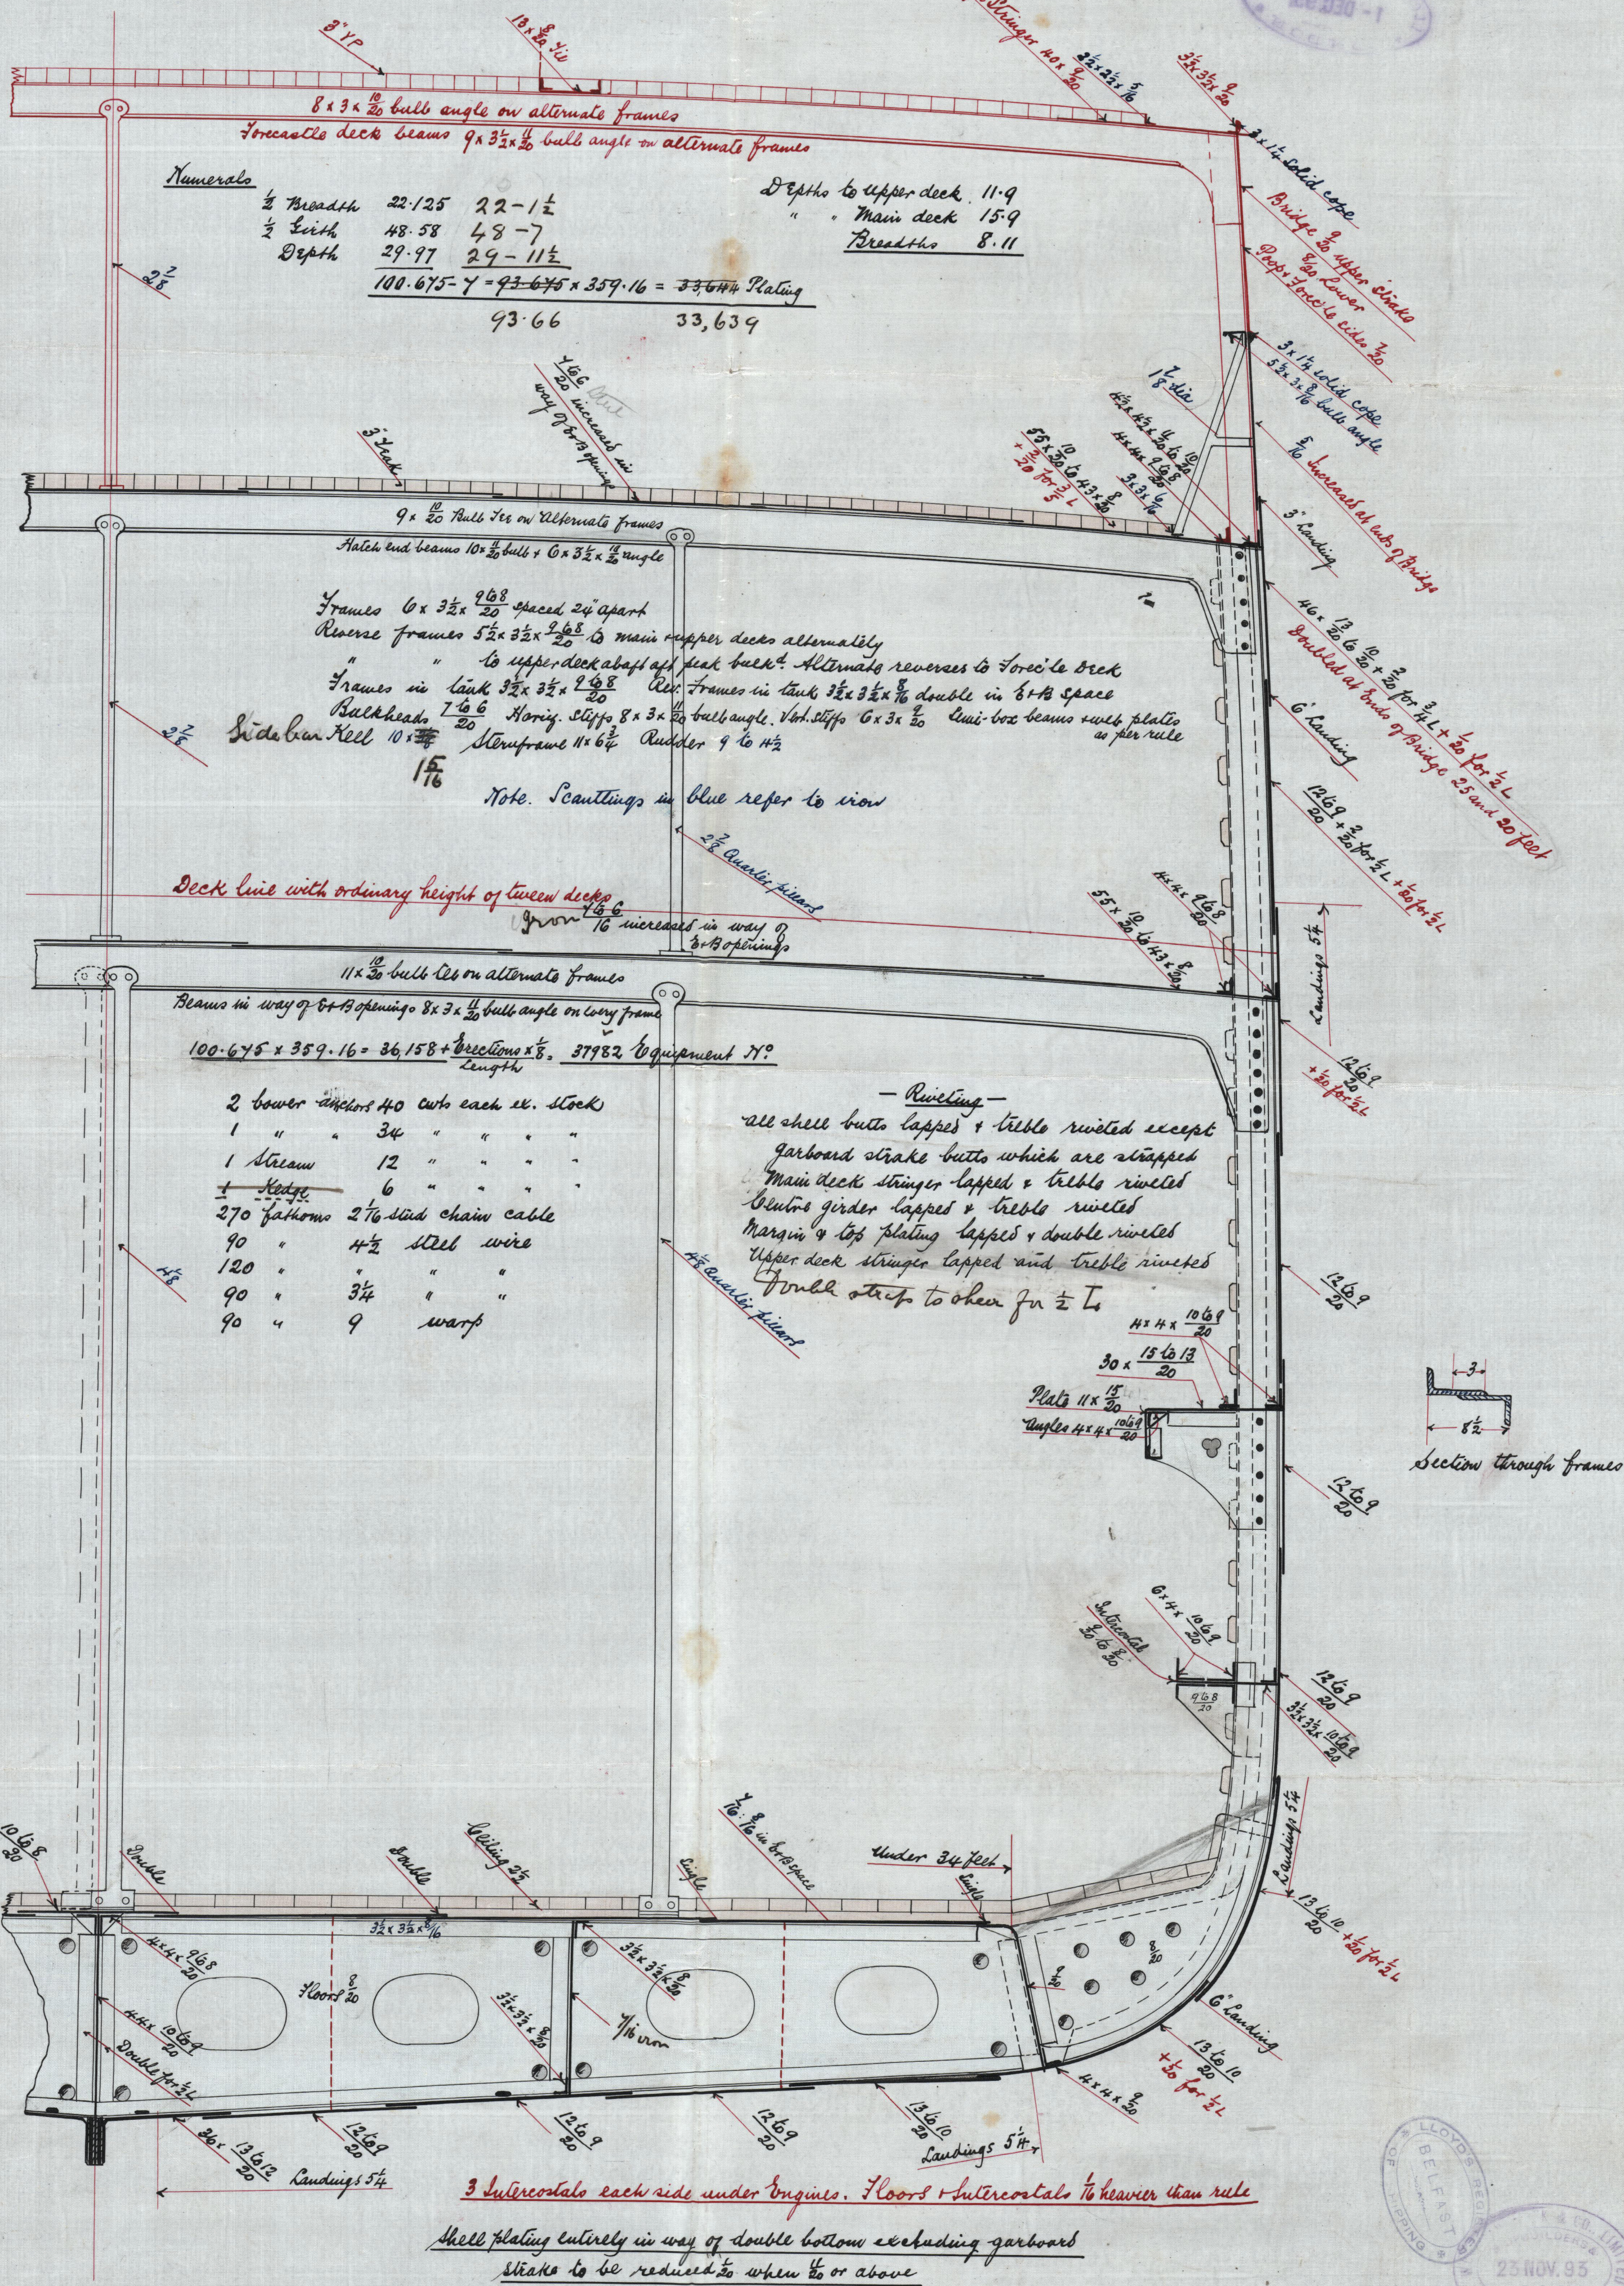

Bridge Deck

For Enclosure to

Messrs. *Lloyd's Surveyors*

0165 4/2

Foreca

18

24




105

BEL62-0165

Ormiston

Midship

Bel 4316

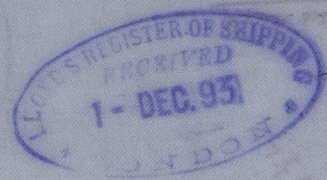

© 2021

Lloyd's Register
Foundation