

15.3.93

Midship Section of N°104 Screw Steamer

to class 100 A1 Spar Deck


Scale $\frac{1}{2}$ inch = 1 foot

Numerals:-

$\frac{1}{2}$ Breadth 19.72
 $\frac{1}{2}$ Depth 35.22
 Depth 19.12
 $74.06 \times 279.75 = 20,717$ plating number

Proportions:-

Depth to spar deck 10.71
 " Main " 14.63
 Breadth 7.08

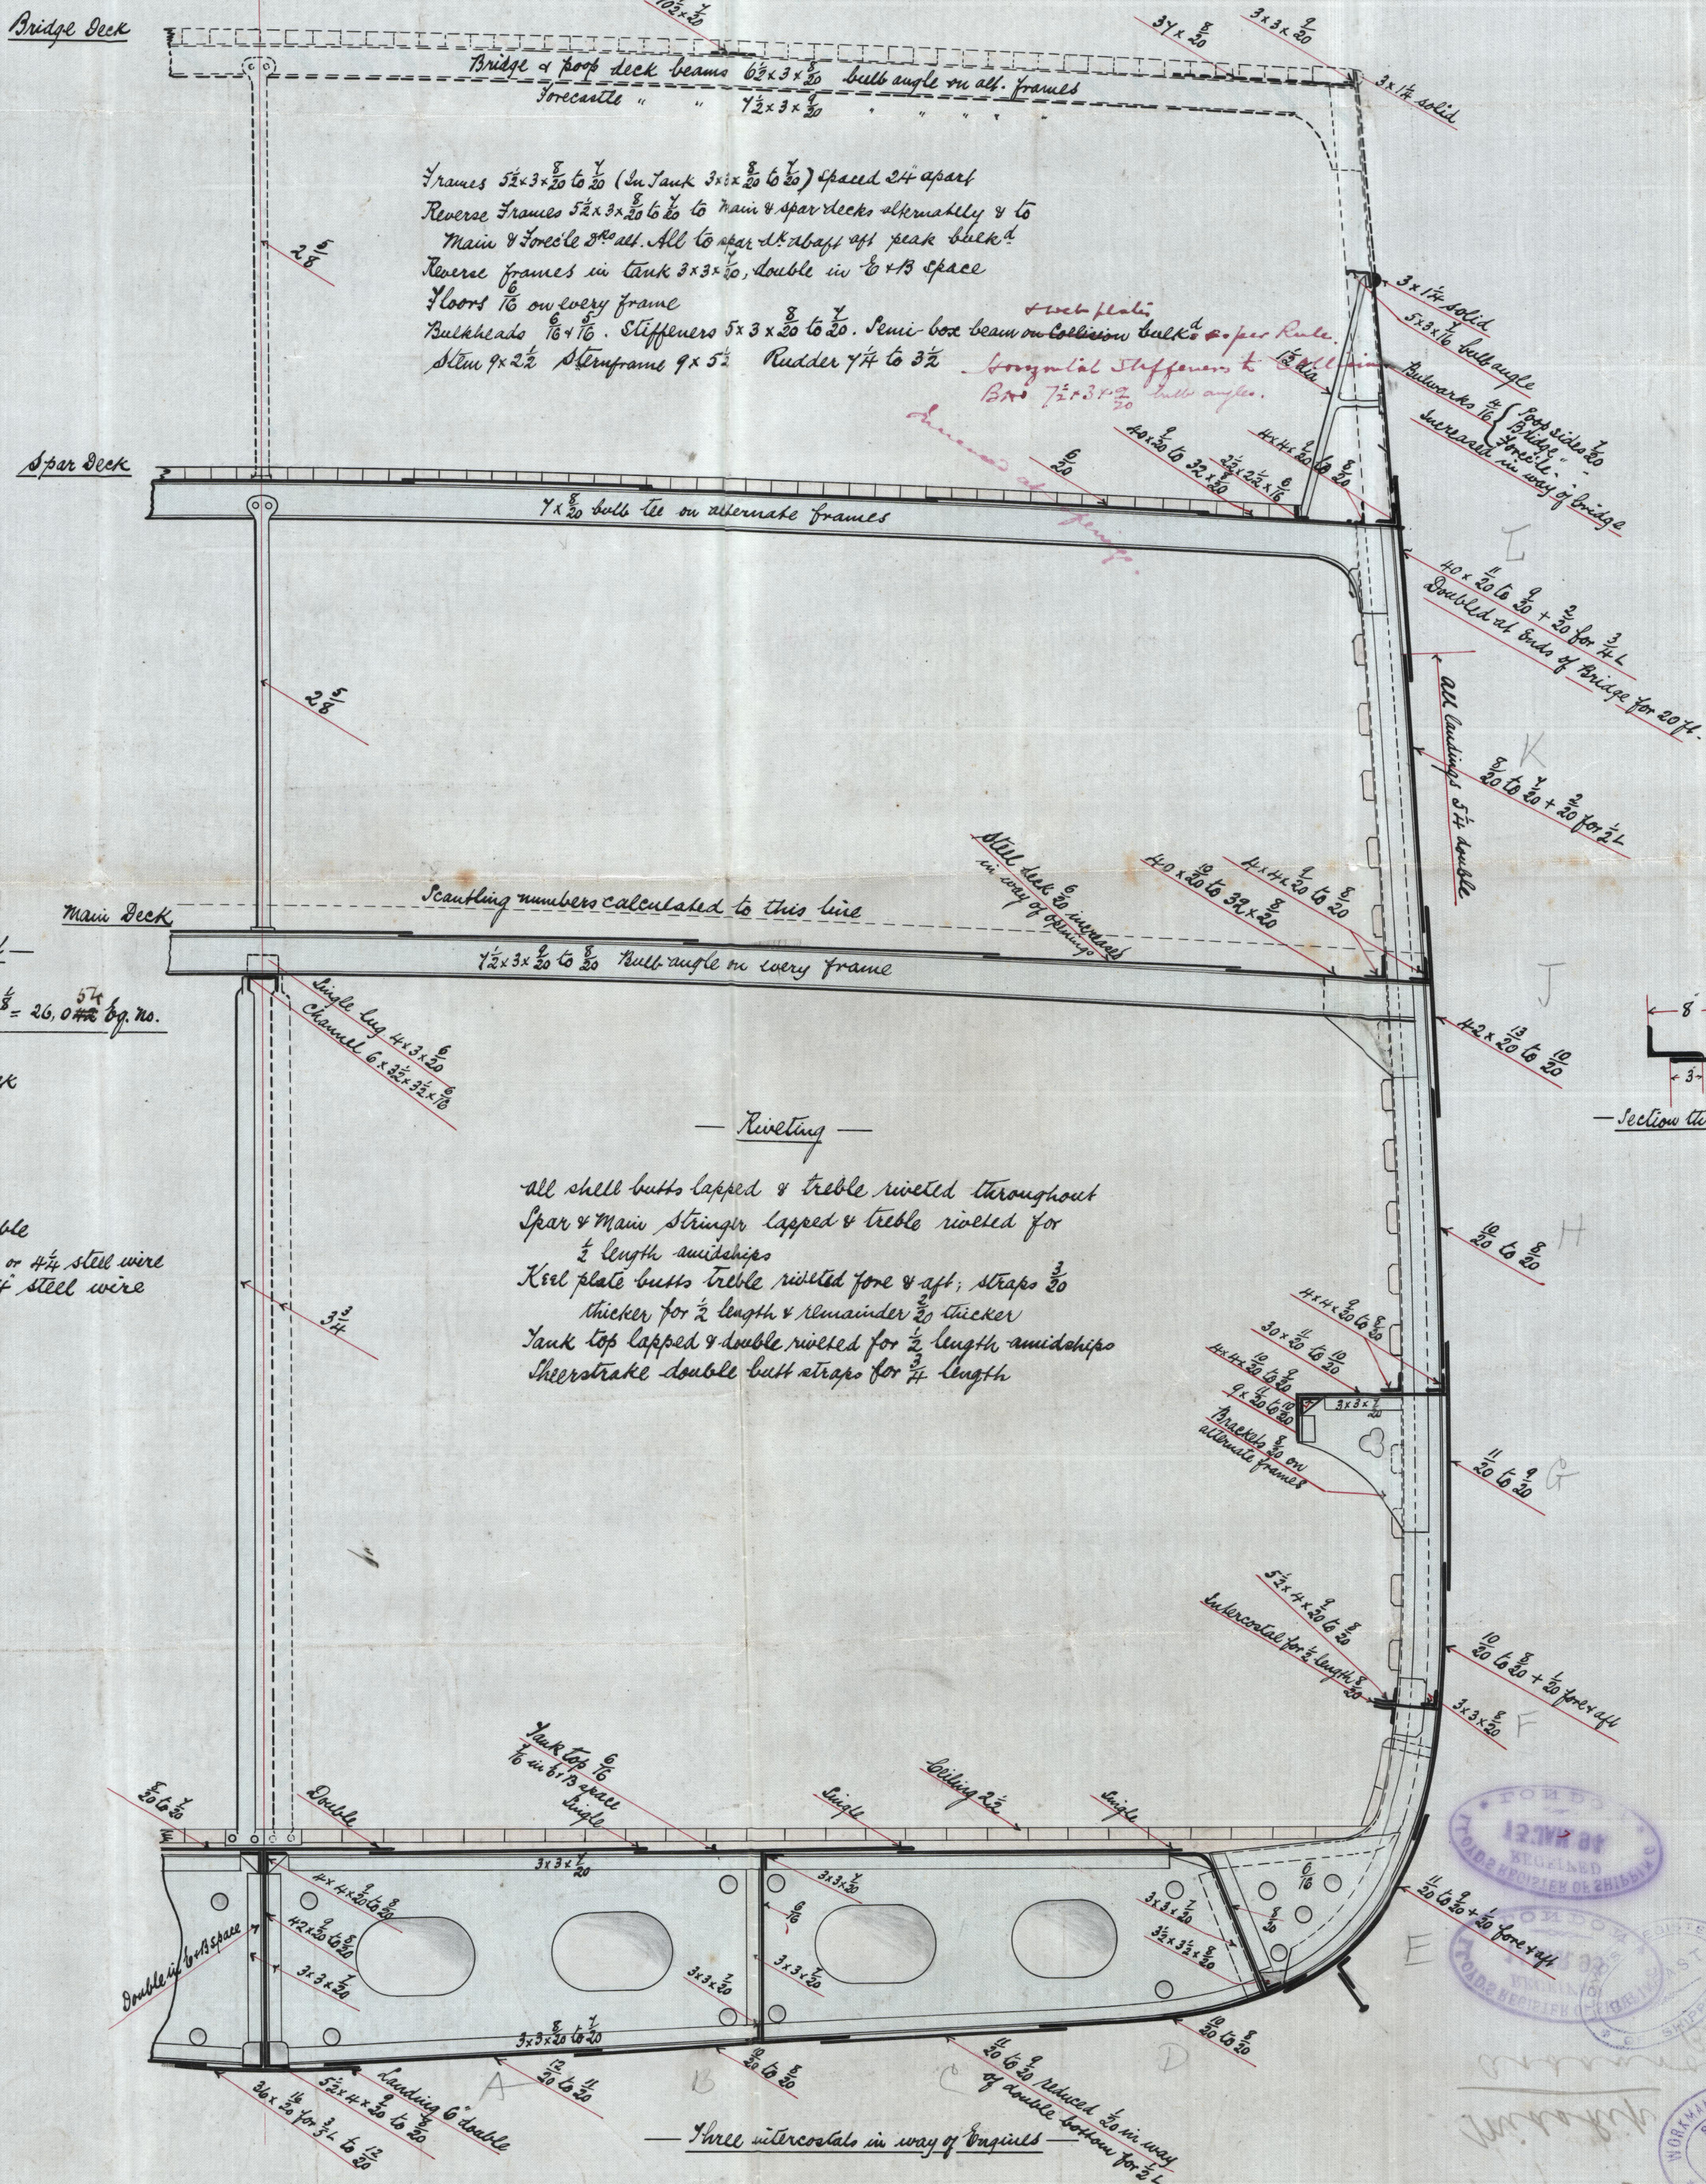

Equipment

$88.06 \times 279.75 = 24,634 + \frac{\text{correction}}{\text{length}} = 26,046$ sq. no.

- 2 lower anchors 32 cwt. ea. ex. stock
- 1 " " 27 $\frac{1}{4}$ " " "
- 1 stream " 10 $\frac{1}{2}$ " " "
- 1 Kedge 5 $\frac{1}{4}$ " " "
- 1 " 2 $\frac{1}{2}$ " " "
- 270 fathoms $1\frac{1}{8}$ steel chain cable
- 75 " $1\frac{1}{8}$ stream chain or $\frac{1}{4}$ steel wire
- 90 " 12 lowline or $\frac{1}{4}$ steel wire
- 90 " 9 $\frac{1}{2}$ hawser
- 90 " 7 $\frac{1}{2}$ warp



Lloyd's Register Foundation

104

Midskip

Andaurose

Bel 4 328

