
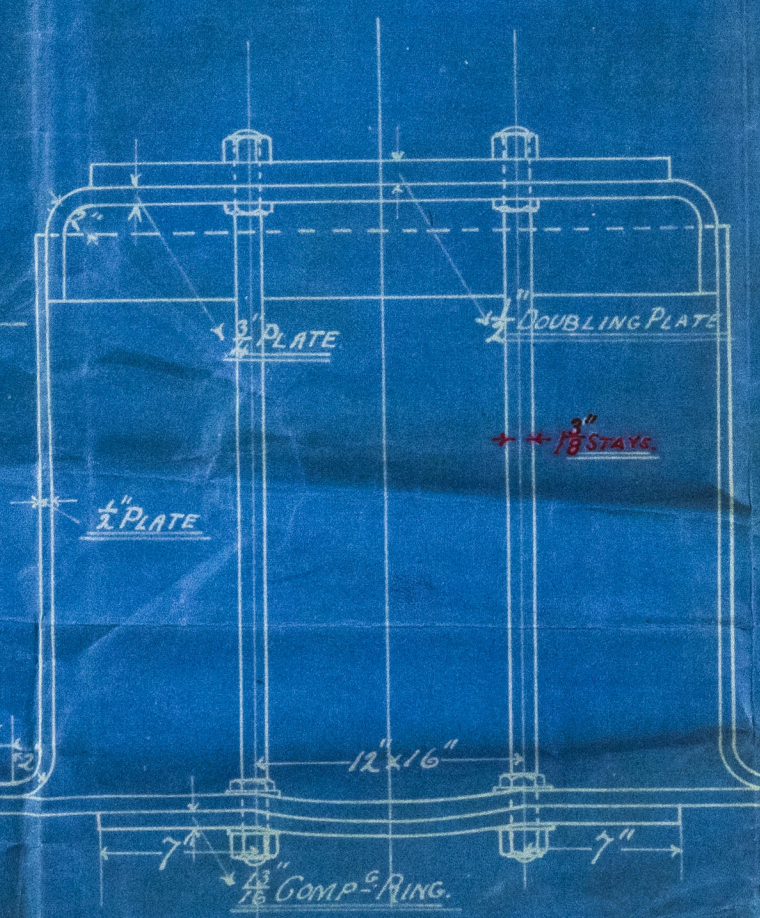


No 966
 Dec 17. 10. 93

— DOME FOR DONKEY BOILER. —

— No 11. —


Working Pressure 160 Lbs
 Dia of Boiler 9'-6"

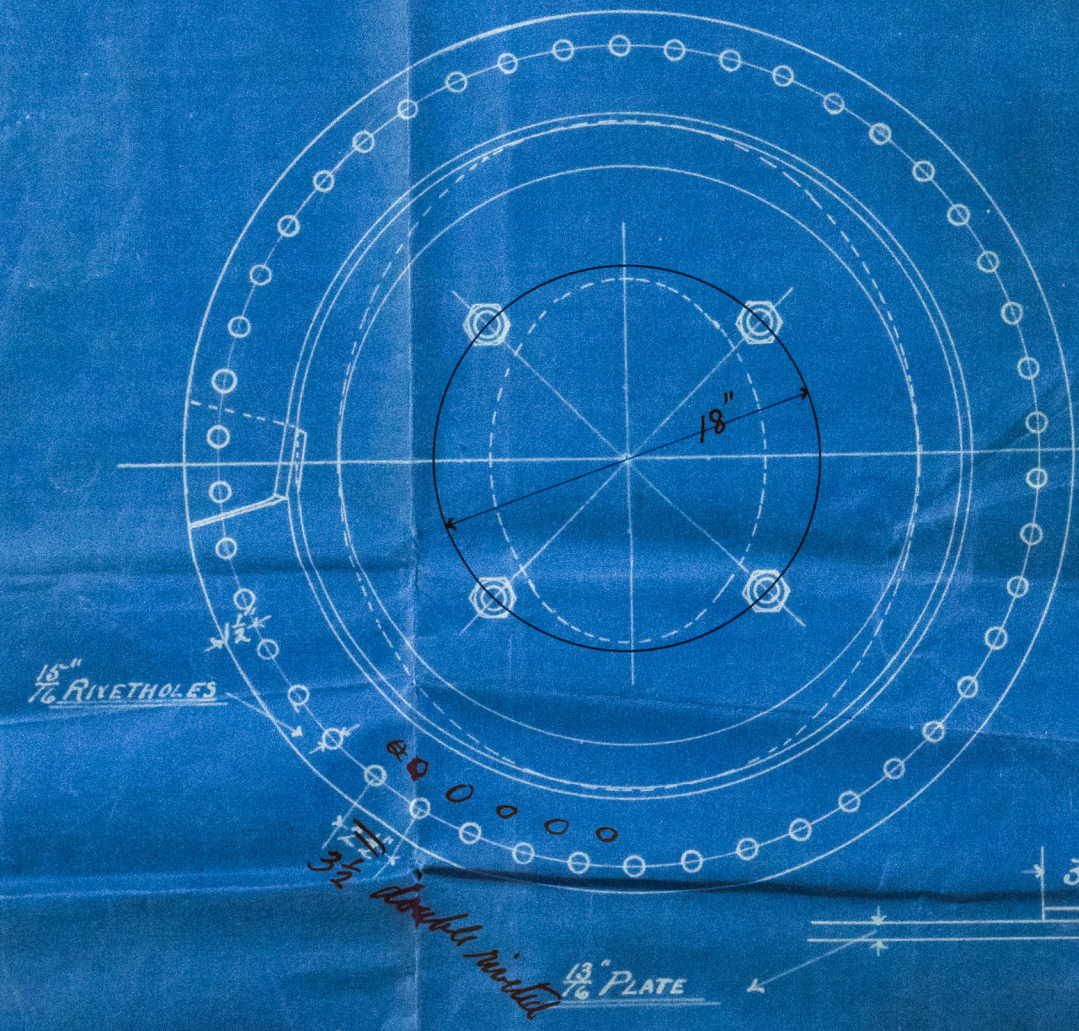


Dome to be as near
 end of boiler as
 possible.

Seam to be double riveted
 & made so as to have
 as much strength
 between the rivet
 holes as possible

M.L.
 18.10.93

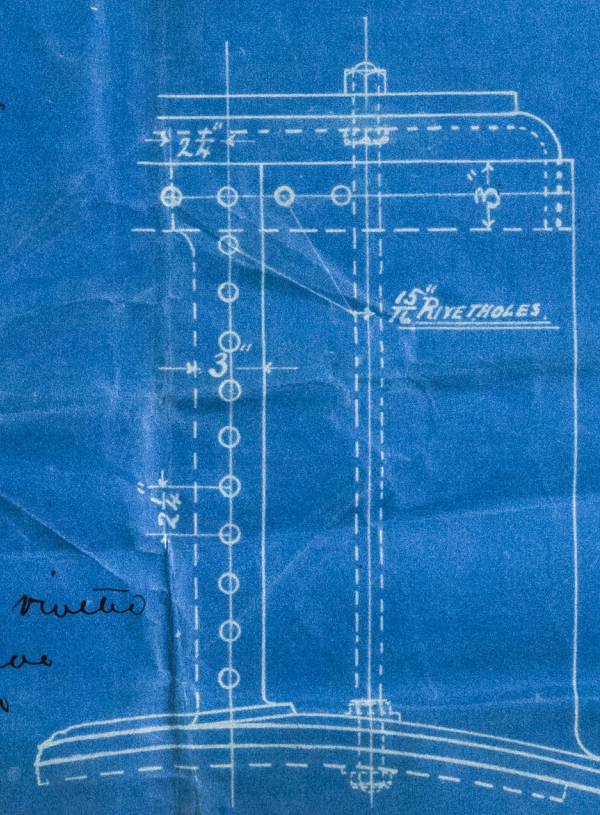

4 1/2" 15" Rivet holes
 3 1/2" pitch

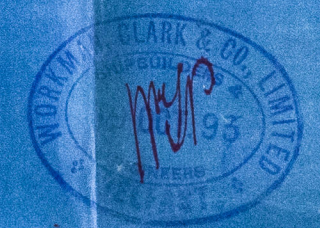

BEL 63-0054

247
BELFAST

casting

Rudder Frame

Exemplemore

Belfast Rpt No 4337



© 2019

Lloyd's Register
Foundation