


18.10.93.
26.10.93.

No 107 SS. Sultan

Plan shewing proposed compensation at Gangway doors and Air Ports

Scale $\frac{1}{8}" = \text{one foot}$

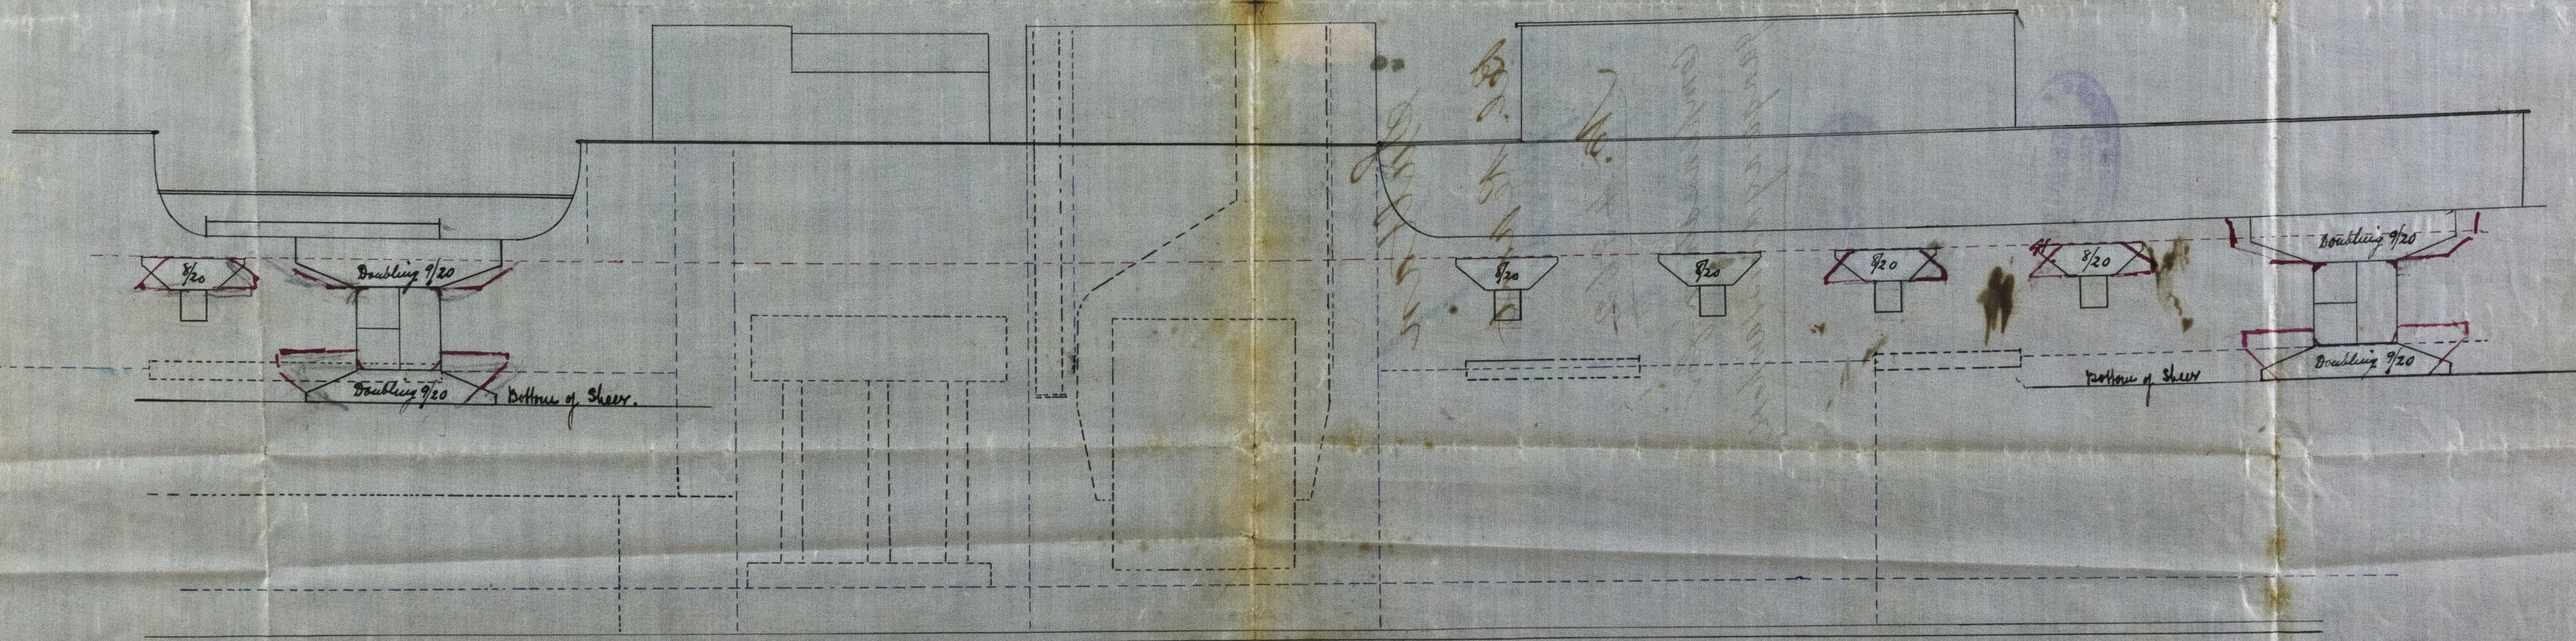

Lloyd's Register
Foundation
BEL 63-0058

10.93.
10.93.

No 107 SS Sultan

Plan showing proposed compensation for 107 SS Sultan

Scale 1/6 - one foot





Sultan

Bel. Report

Compensation

No. 4362

Compensation for
gangway door stairs

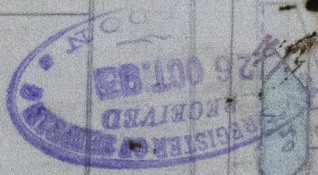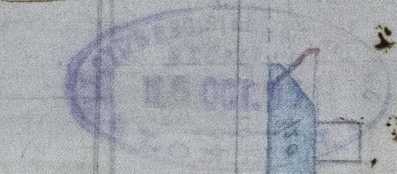

© 2019

Lloyd's Register
Foundation