


Sultan
107
Rel. Report

No. 4362
Fresh Water Tank

Spice Deck

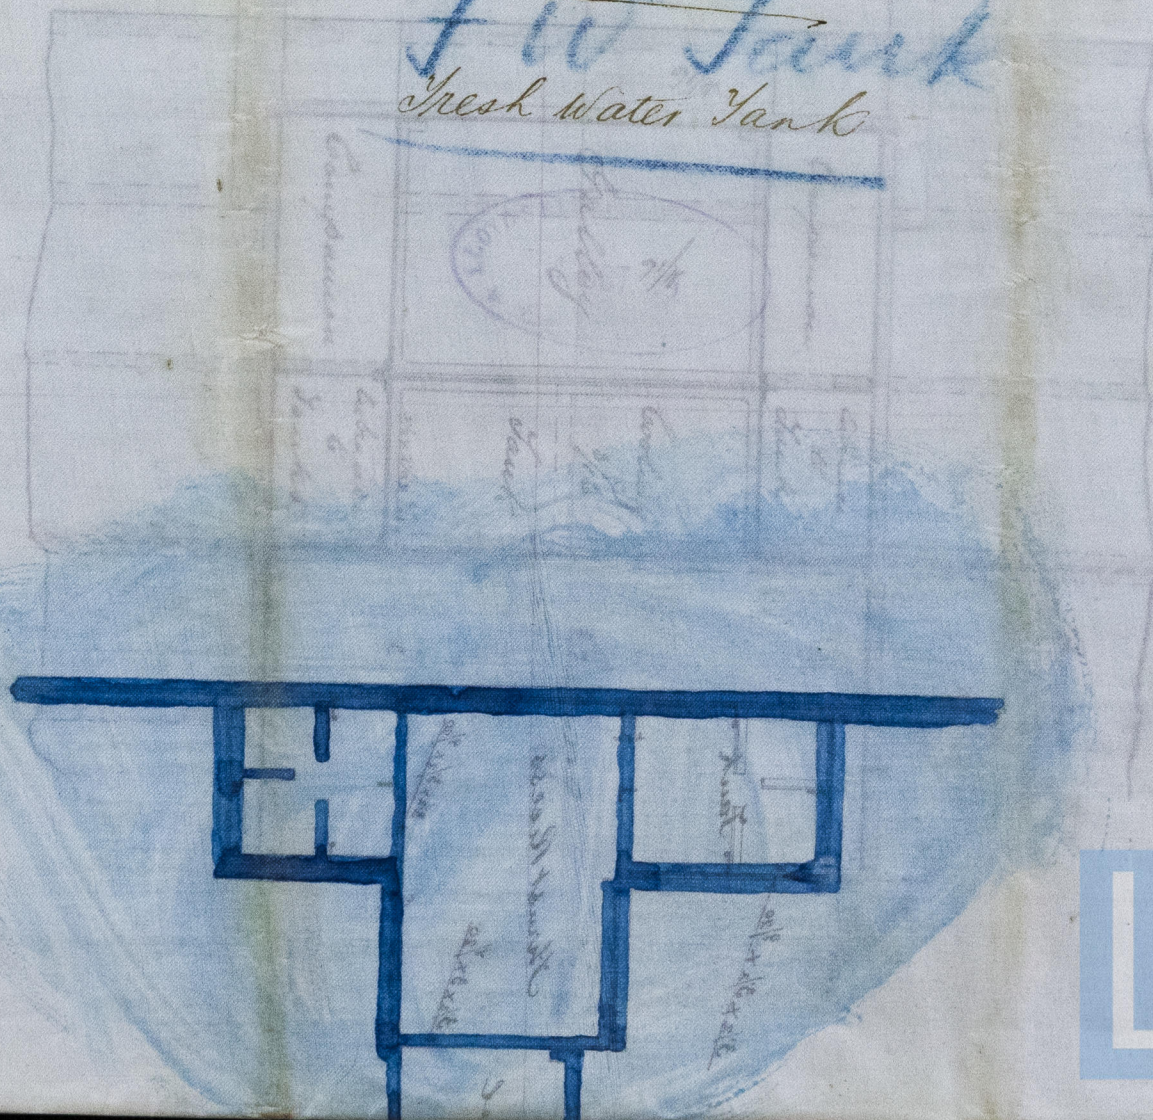

Spice Deck

10.93



© 2019
Lloyd's Register
Foundation

0000-2063-0060