


— Scale $\frac{1}{8}$ " = one foot. —

8/8/53
26.10.93



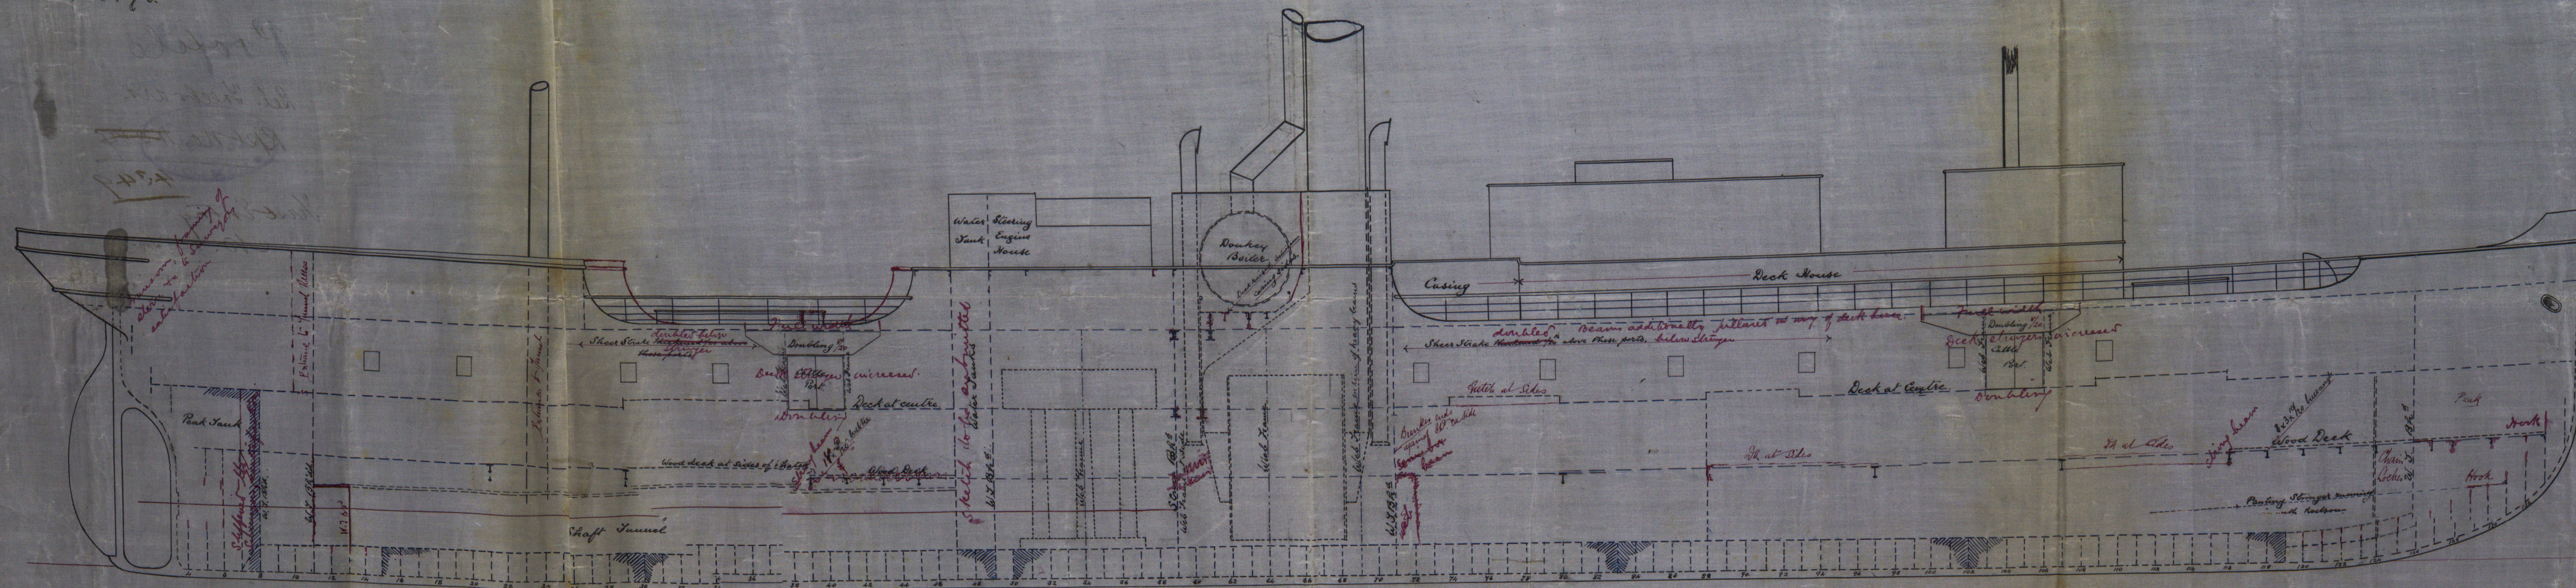


Sultan 8/2/93
8/2/93

Profile

Rel. Freeboard

Rpt No. ~~4284~~
4349

First Entry
No. 4362

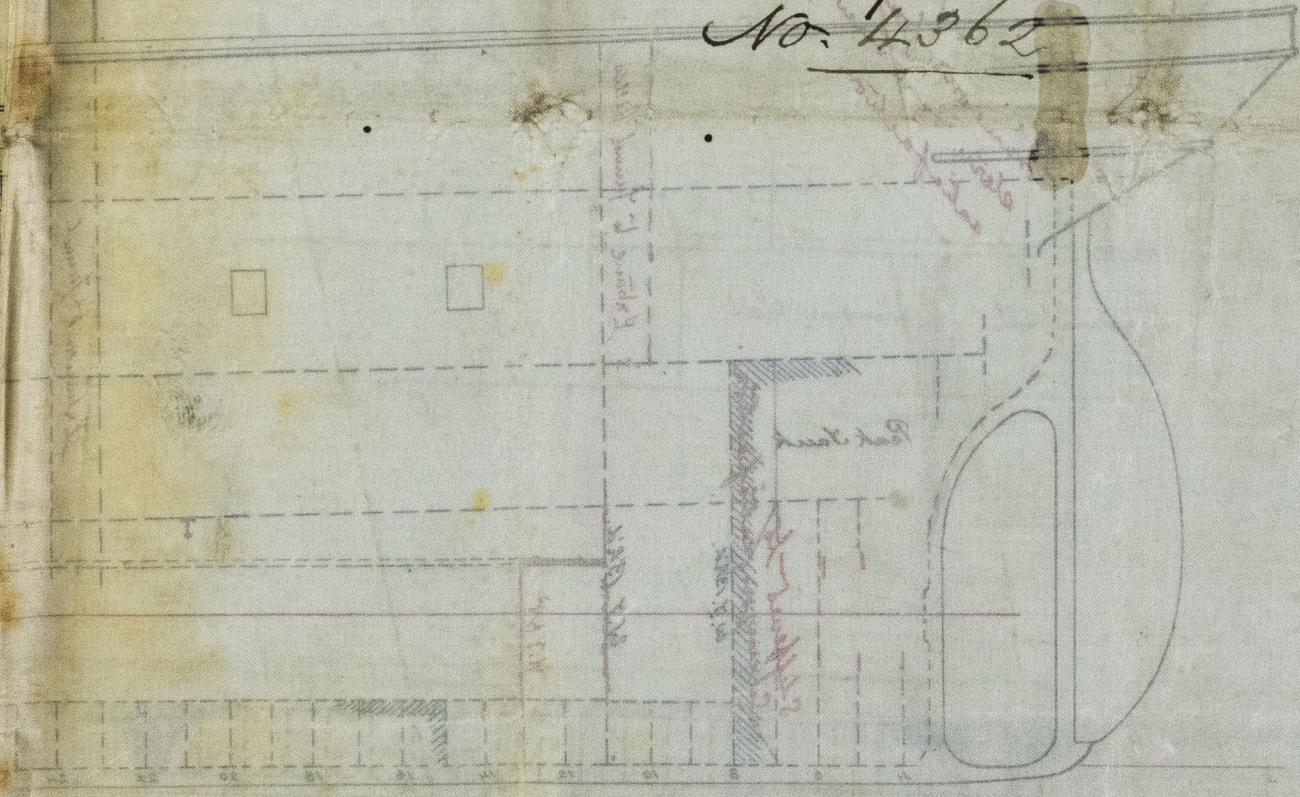

© 2019

Lloyd's Register
Foundation