


S. S. N^o 59


MASTS

SCALES $\frac{1}{32}$ & $\frac{1}{4}$ = 1 FT

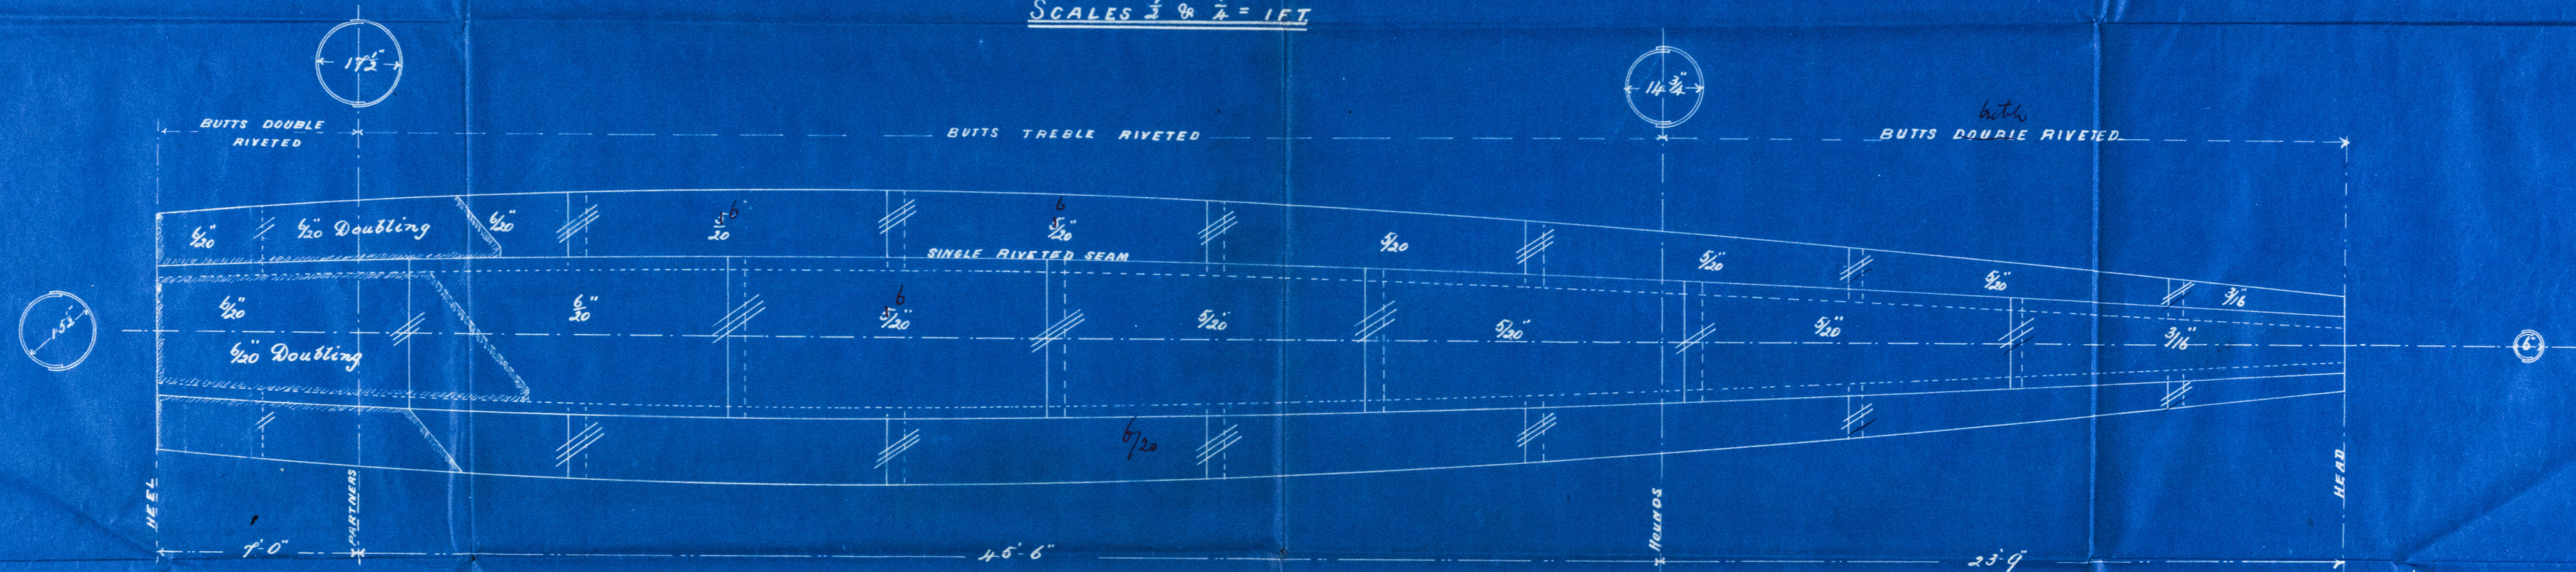


MAIN MAST


MASTS TO CARRY FORE & AFT SAIL ONLY

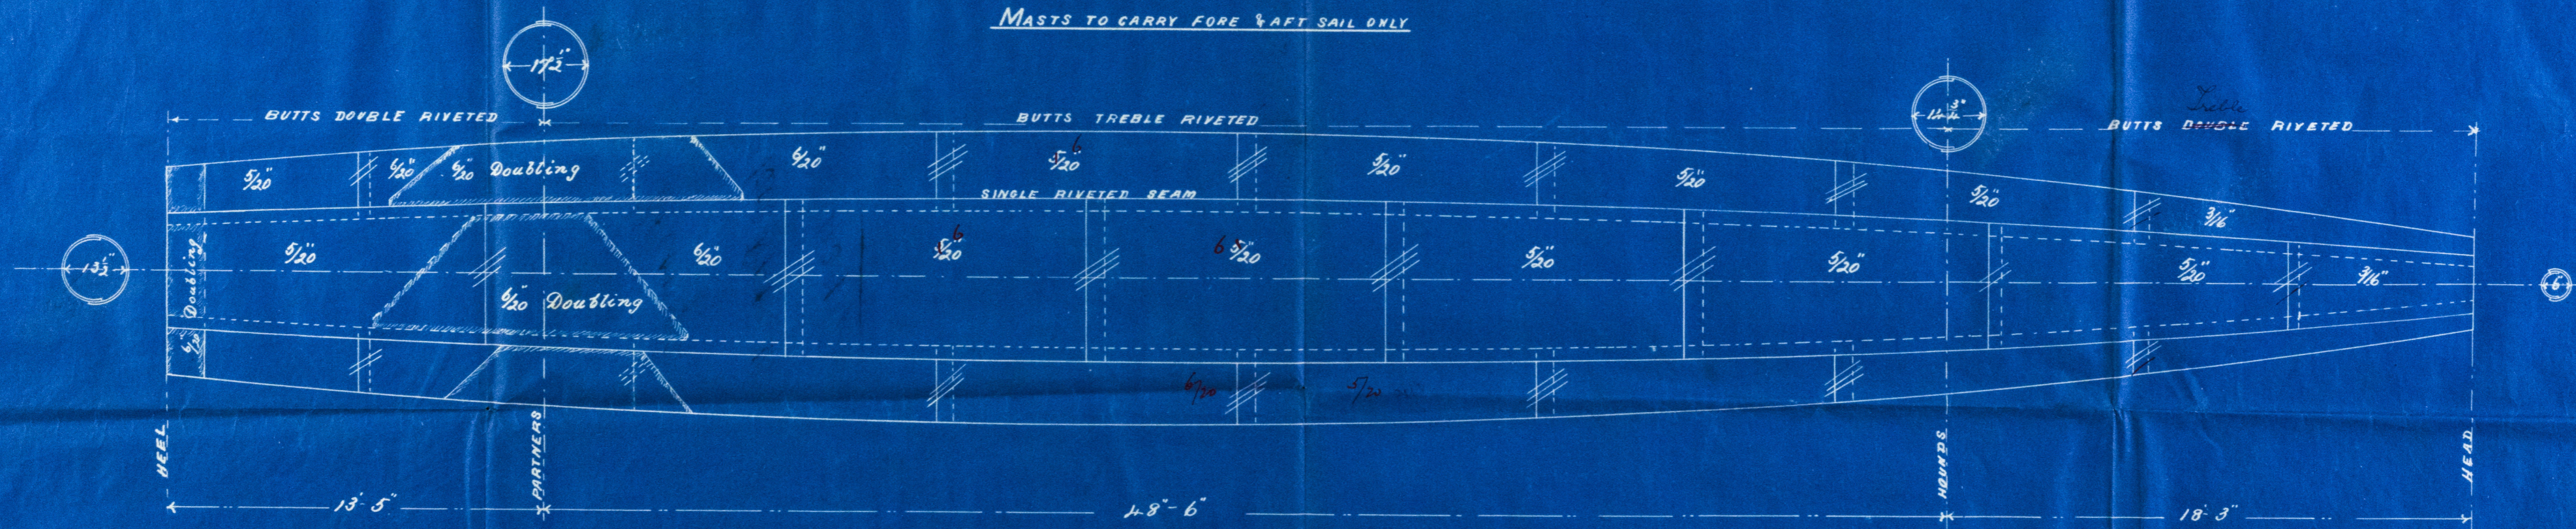


FORE MAST

HL
9.11.93

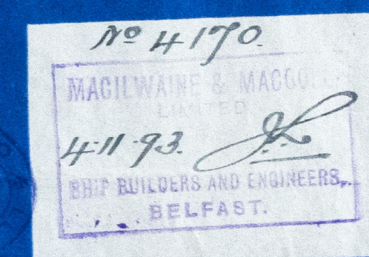

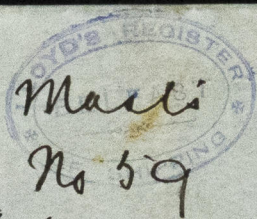

"Theory"

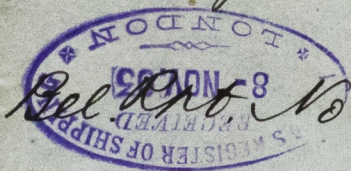

4374



© 2019
Lloyd's Register
Foundation