

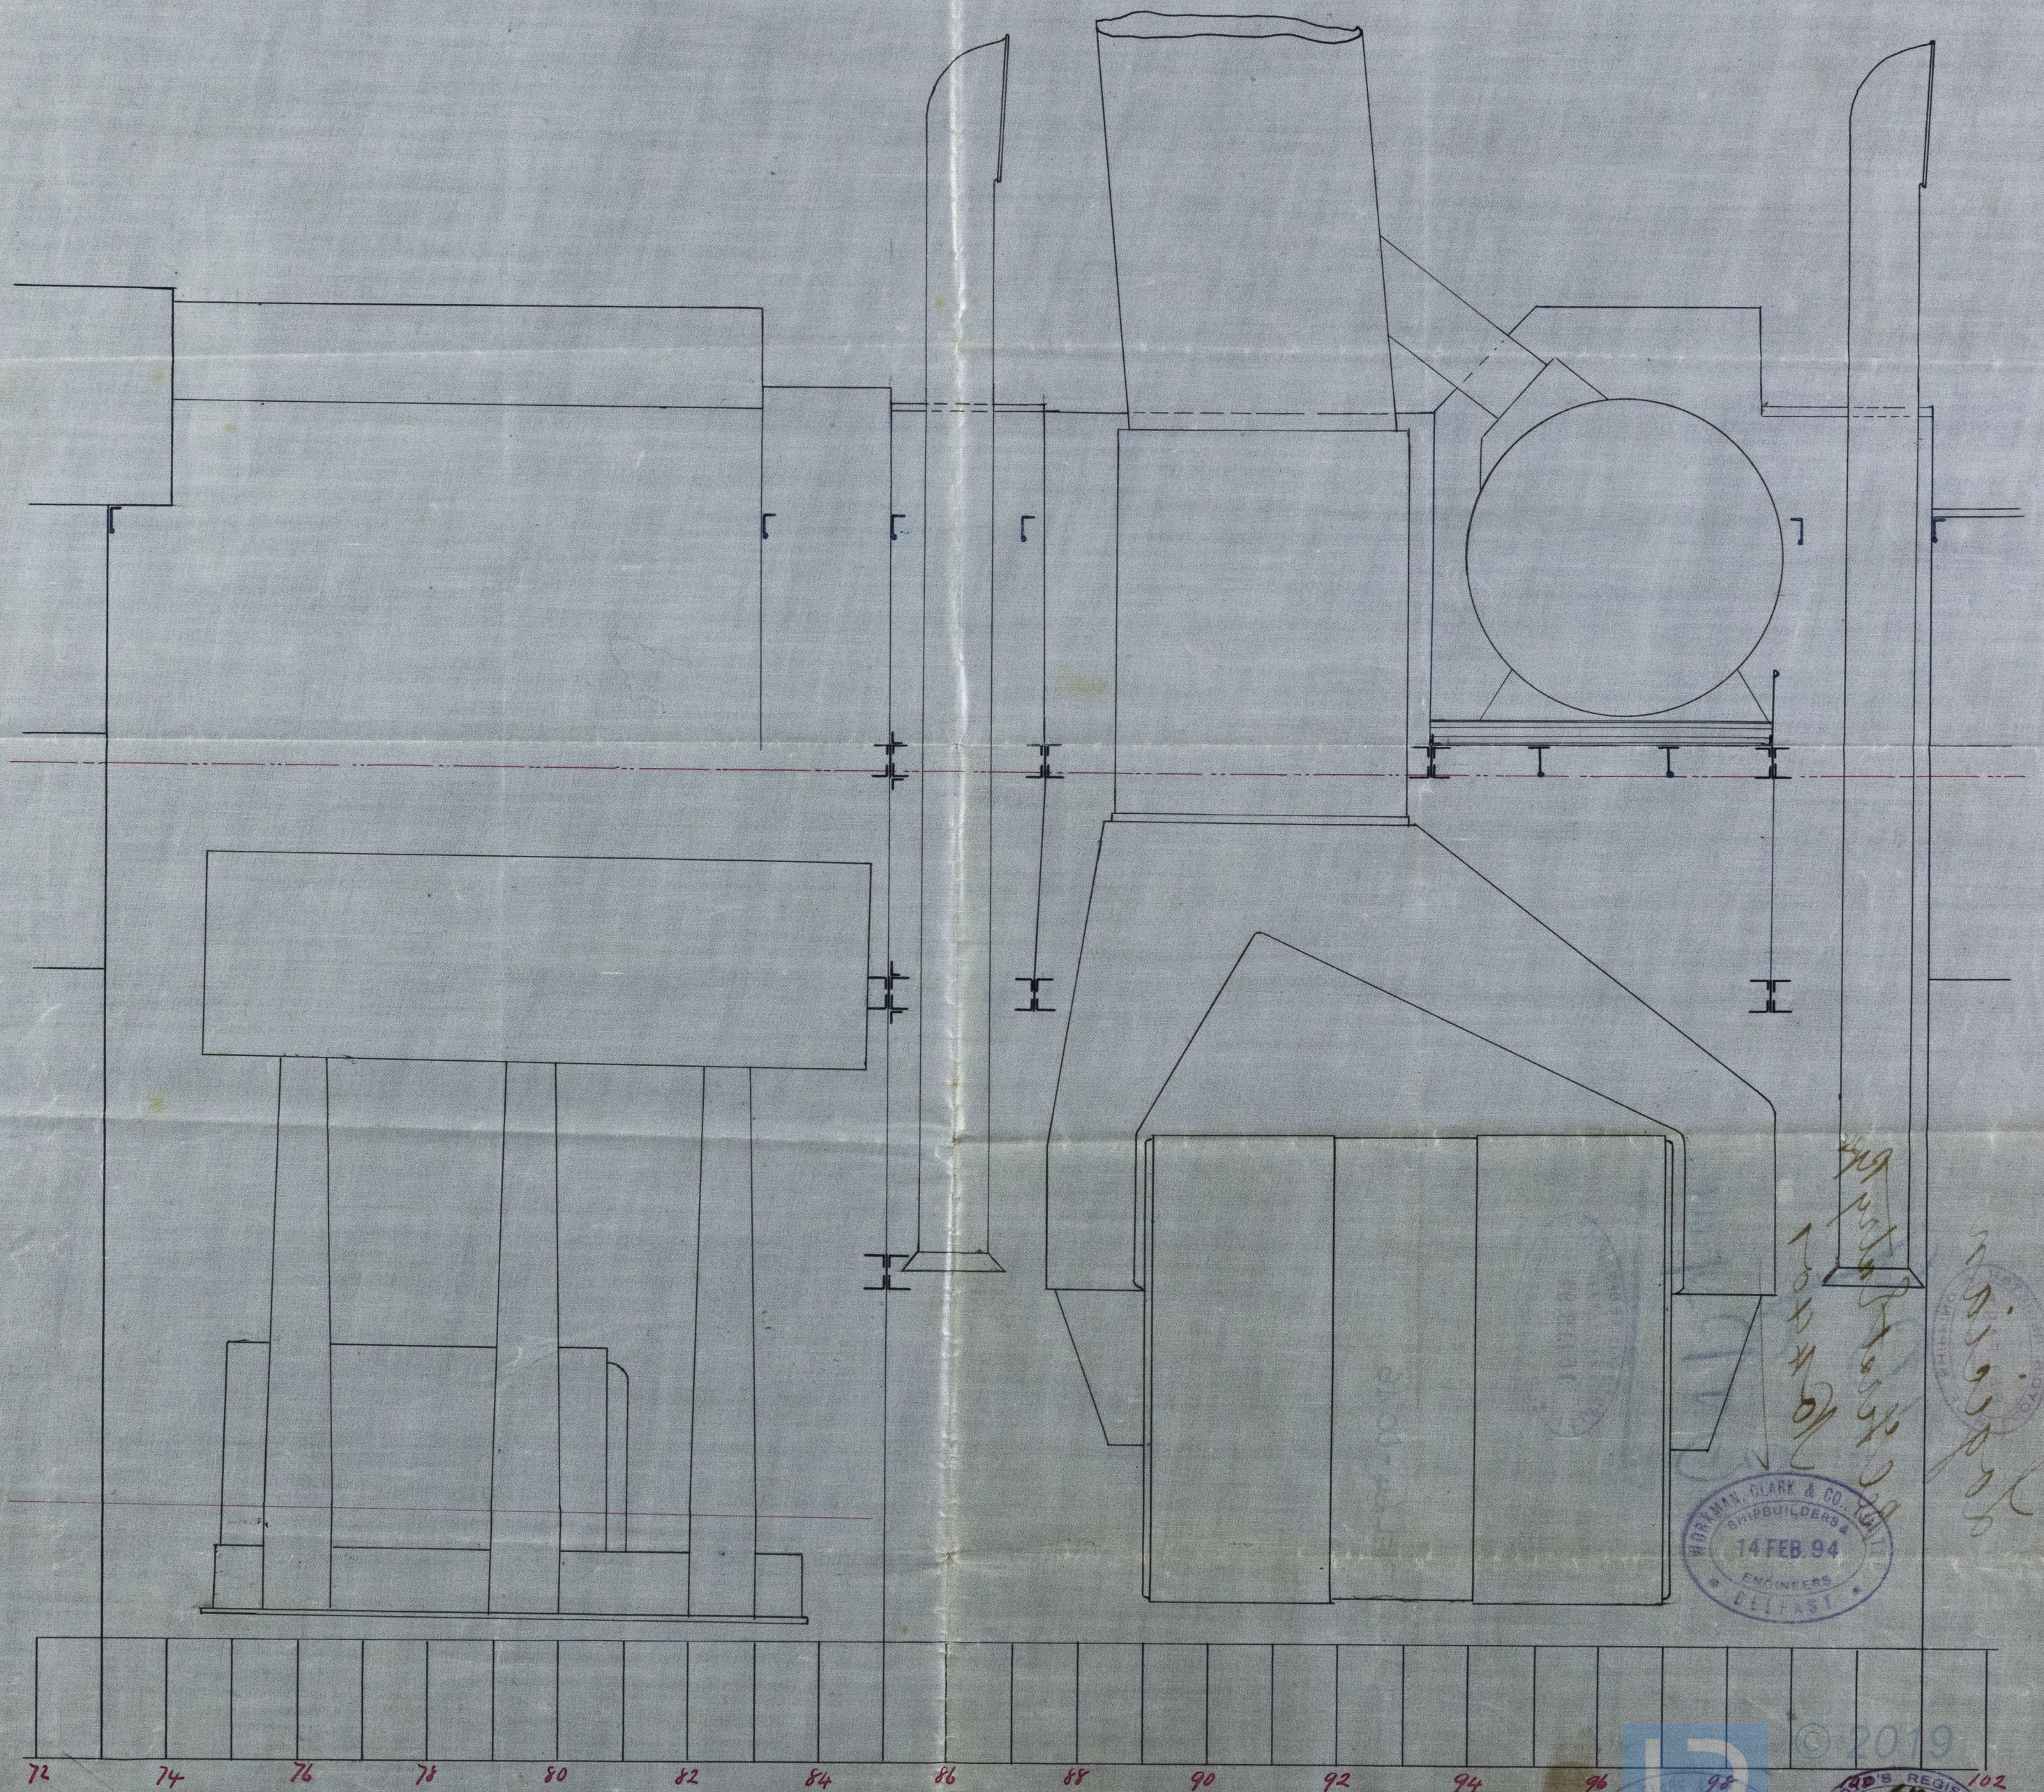


19.2.94.

Longitudinal Section of Engine & Boiler Space showing arrangement
of Strong Beams N^o 109 S.S.
Scale $\frac{1}{4}$ inch = One foot

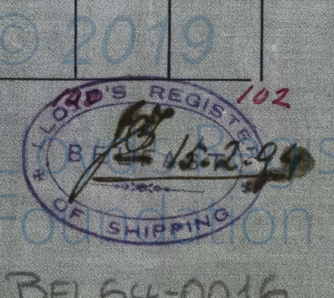


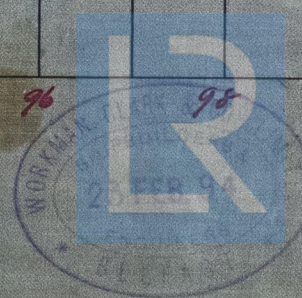

BEL64-0016


Logician



Bel First Entry Rpt
No 4401



ETB Space

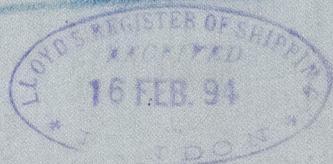

BEL 64-0016



© 2019

Lloyd's Register
Foundation

Bel 64-0016



10

8

6

4

Bel 64-0016

No 109 S.S.